


U. S. PUBLIC LAND SURVEY MONUMENT RECORD

SECTION 5 T 16 N, R 6 W, TOWN OF HAMILTON  
 LA CROSSE COUNTY

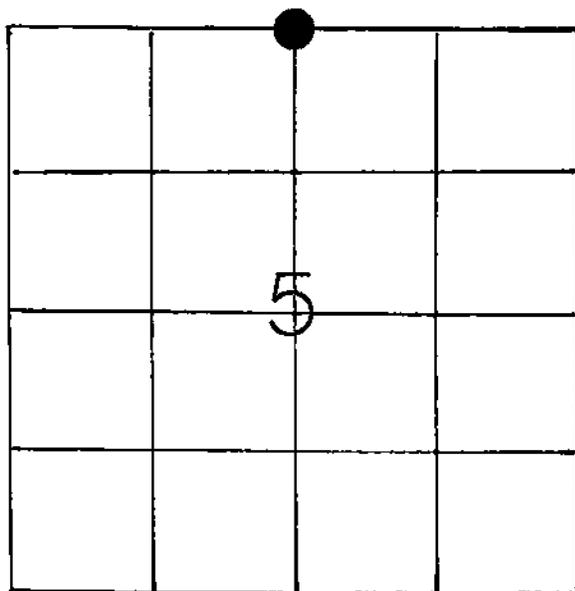

LOCATION OF LANDMARK

WISCONSIN COORDINATE SYSTEM
North
East
Theta Angle
Horiz. Order
Vert. Order
TYPE OF LANDMARK
Railroad spike over iron bar
BEARINGS ARE REFERENCED TO
Assumed

Crew: William C. Jung  
 Peter F. Follansbee

Date: August 19, 1991

Describe any record evidence, monument evidence, testimonial evidence or any other material evidence you considered and whether the monument was found or restored through acceptance of an obliterated evidence location.

In 1984 I again used the iron bar at this corner as the corner. (See my old 1986 tie sheet for a narrative of the corner.) In May of 1989 I drove the bar down as the road was to be milled and then paved. In May of 1990 I found the bar down in a large hole chipped out by the D.O.T. surveyors. In August of this year we found the bar down 7" in this hole. We patched the hole and set a railroad spike over the bar.


Describe or show any material discrepancy between the location of the restored corner and that of the corner previously restored or reestablished.

None known.

Year tie made  
↓

RECORD OF DURABLE WITNESS MONUMENTS

	NO	DESCRIPTION	BEARING	DISTANCE
1984	1	Existing 1½"x27" pipe	-----	47.15
"	2	" 1" pipe	South+	44.45
"	3	" 1½"x27" pipe	-----	46.39
1989	4	" 1" pipe	-----	47.17
"	5	" 1" pipe	-----	46.65

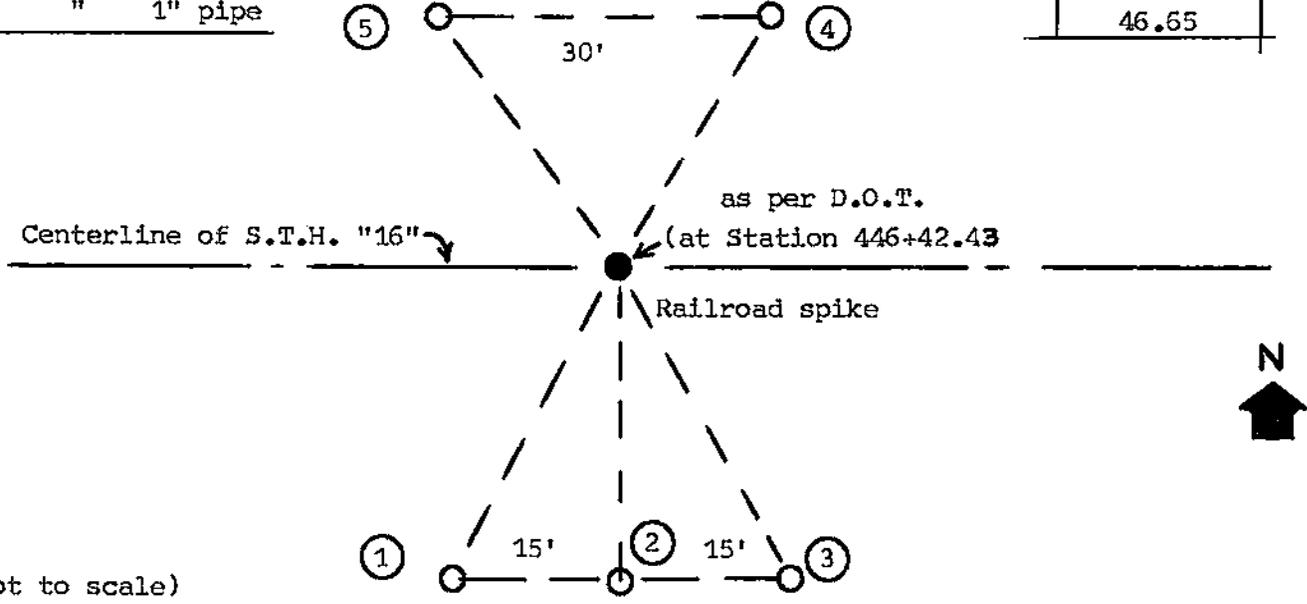


(not to scale)

PLAN VIEW DRAWING OF REFERENCE TIES


MAP SHOWING DISTANCE AND DIRECTION TO OTHER PUBLIC LAND SURVEY CORNERS USED FOR REESTABLISHING THE CORNER

(not to scale)

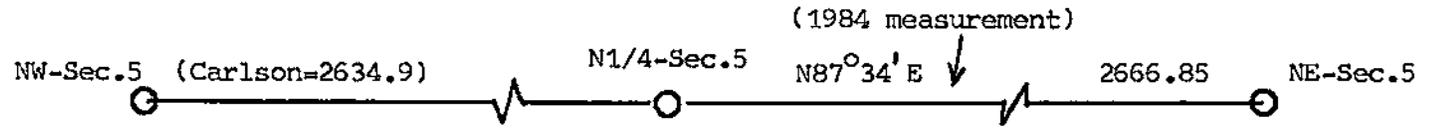

I, William C. Jung, Deputy County Surveyor,  
 HEREBY CERTIFY THAT THE CORNER LOCATION SHOWN ON THIS RECORD  
 WAS DETERMINED BY ME OR UNDER MY DIRECTION AND CONTROL AND  
 THAT THIS U. S. PUBLIC LAND SURVEY MONUMENT RECORD IS CORRECT  
 AND COMPLETE TO THE BEST OF MY KNOWLEDGE AND BELIEF.

William C. Jung                      November 7, 1991  
 Signature                                      Date

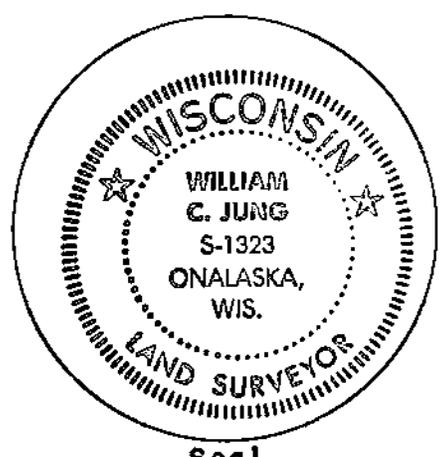


Seal

U. S. PUBLIC LAND SURVEY MONUMENT RECORD

SECTION 5 T 16 N, R 6 W, TOWN OF HAMILTON

LA CROSSE COUNTY

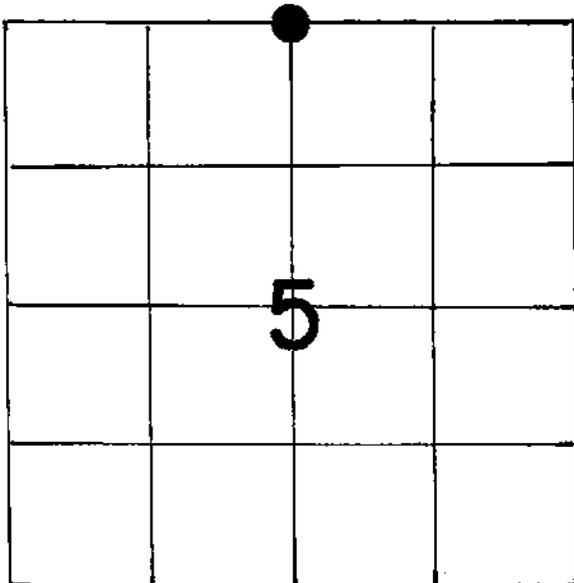

LOCATION OF LANDMARK

Crew: William Jung  
Perry Dahl

11/8/84

Describe any record evidence, monument evidence, testimonial evidence or any other material evidence you considered and whether the monument was found or restored through acceptance of an obliterated evidence location.

The 1935 highway map shows the corner to be in the centerline and on line with a property line to the South. Carlson set an iron bar at this location in 1979. I used this bar as the corner in 1980. I accepted this occupied corner as the best possible evidence of the original government corner location. There is a fence going South from the corner.


Describe or show any material discrepancy between the location of the restored corner and that of the corner previously restored or reestablished.

None known.

WISCONSIN COORDINATE SYSTEM
North
East
Theta Angle
Horiz. Order
Vert. Order
TYPE OF LANDMARK
3/4" IRON ROD
BEARINGS ARE REFERENCED TO
Assumed


RECORD OF DURABLE WITNESS MONUMENTS

NO	DESCRIPTION	BEARING	DISTANCE
1	SET 1 1/4" IRON PIPE (27" long)	_____	47.15'
2	SET 1" IRON PIPE	SOUTH ±	44.45'
3	SET 1 1/4" IRON PIPE (27" long)	_____	46.39'
4			

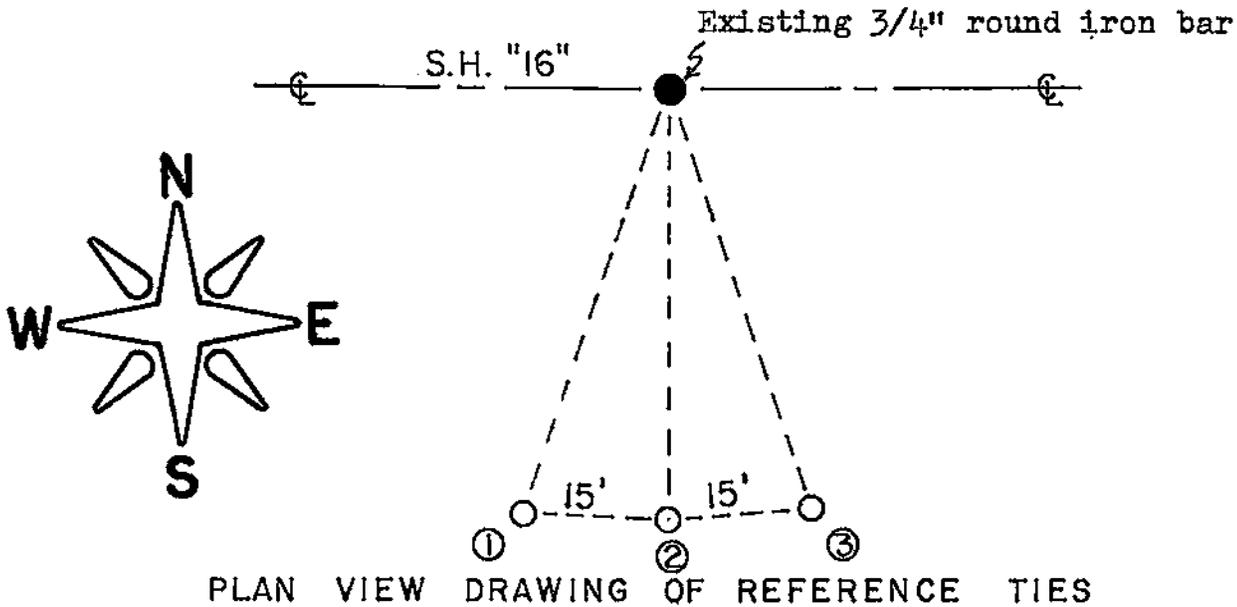

MAP SHOWING DISTANCE AND DIRECTION TO OTHER PUBLIC LAND SURVEY CORNERS USED FOR REESTABLISHING THE CORNER

(not to scale)

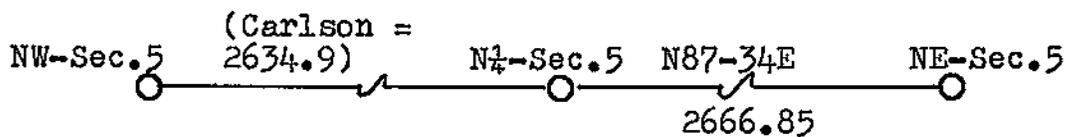

I, William C. Jung, Deputy County Surveyor,  
 HEREBY CERTIFY THAT THE CORNER LOCATION SHOWN ON THIS RECORD  
 WAS DETERMINED BY ME OR UNDER MY DIRECTION AND CONTROL AND  
 THAT THIS U. S. PUBLIC LAND SURVEY MONUMENT RECORD IS CORRECT  
 AND COMPLETE TO THE BEST OF MY KNOWLEDGE AND BELIEF.

William C. Jung 3/14/86  
 Signature Date



Seal