


21706330020

U. S. PUBLIC LAND SURVEY MONUMENT RECORD

SECTION 4 T 16 N, R 6 W, ^{Village} ~~TOWN~~ OF West Salem

LA CROSSE COUNTY

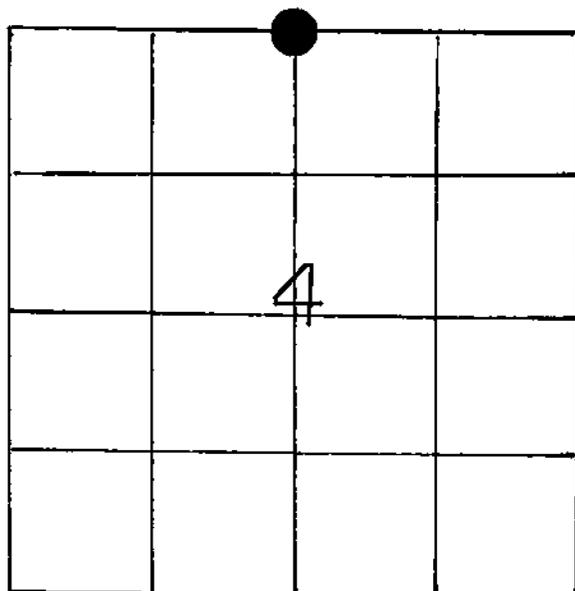

LOCATION OF LANDMARK

WISCONSIN COORDINATE SYSTEM
North
East
Theta Angle
Horiz. Order
Vert. Order
TYPE OF LANDMARK (see ties on back page)
BEARINGS ARE REFERENCED TO Assumed

Crew: William C. Jung
Peter F. Follansbee

Date: August 21, 1991

Describe any record evidence, monument evidence, testimonial evidence or any other material evidence you considered and whether the monument was found or restored through acceptance of an obliterated evidence location.

The P.K. nail was destroyed during road construction. The new corner falls in the concrete which chipped away as I tried to set a drill hole. There is only a small drill hole at the corner. It falls 7.06' feet East of my tie P.K. and 0.12' North of the concrete crack. The easiest way to shoot this corner is to shoot the P.K. and adjust the coordinate 7.06' East and 0.12' North.


(See my old 1986 tie sheet for a narrative of the corner.)

Describe or show any material discrepancy between the location of the restored corner and that of the corner previously restored or reestablished.

(See my old 1986 tie sheet.)

RECORD OF DURABLE WITNESS MONUMENTS

NO	DESCRIPTION	BEARING	DISTANCE
1	Southwest bolt of lamp post	-----	110.82
2	P.K. nail in new power pole	-----	90.24
3	Center of manhole	-----	56.93
4	Set P.K. nail at the intersection	-----	7.06

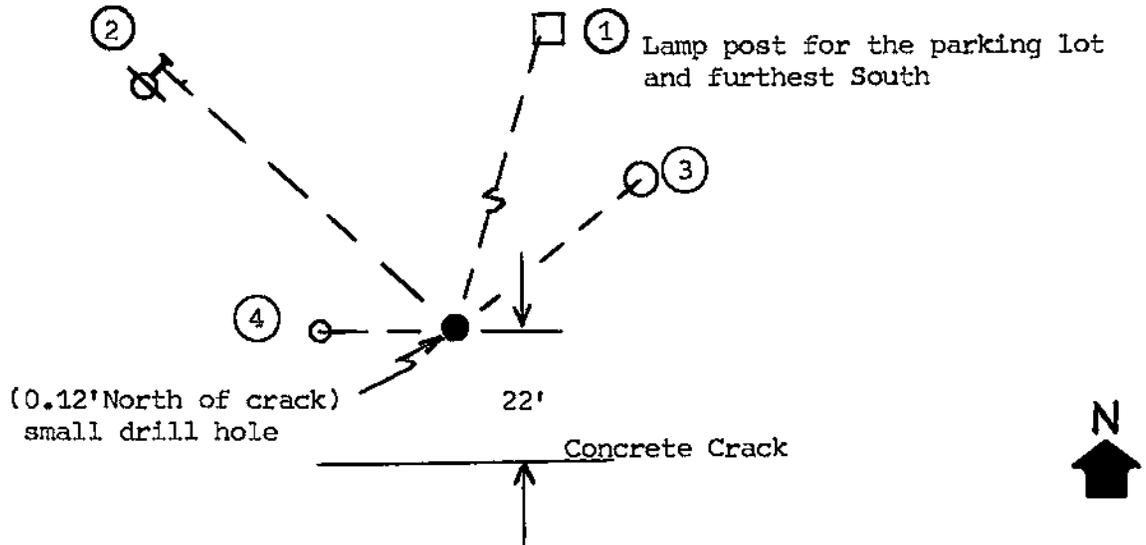


(not to scale)

PLAN VIEW DRAWING OF REFERENCE TIES


MAP SHOWING DISTANCE AND DIRECTION TO OTHER PUBLIC LAND SURVEY CORNERS USED FOR REESTABLISHING THE CORNER

(not to scale)

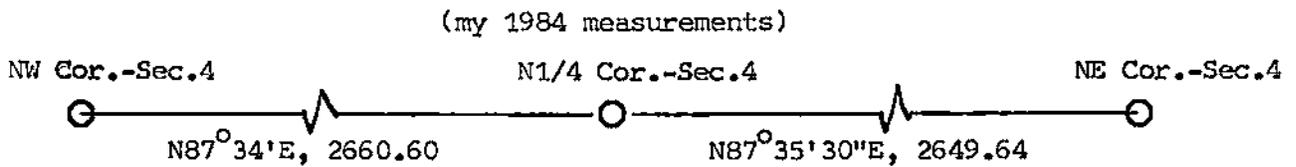

I, William C. Jung, Deputy County Surveyor,
 HEREBY CERTIFY THAT THE CORNER LOCATION SHOWN ON THIS RECORD
 WAS DETERMINED BY ME OR UNDER MY DIRECTION AND CONTROL AND
 THAT THIS U. S. PUBLIC LAND SURVEY MONUMENT RECORD IS CORRECT
 AND COMPLETE TO THE BEST OF MY KNOWLEDGE AND BELIEF.

William C. Jung November 6, 1991
 Signature Date

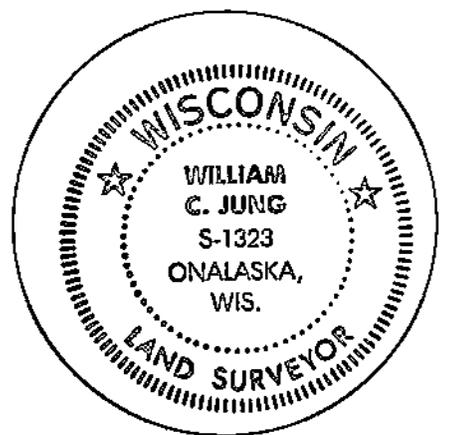


Seal

U. S. PUBLIC LAND SURVEY MONUMENT RECORD

SECTION 4 T 16 N, R 6 W, TOWN OF HAMILTON

LA CROSSE COUNTY

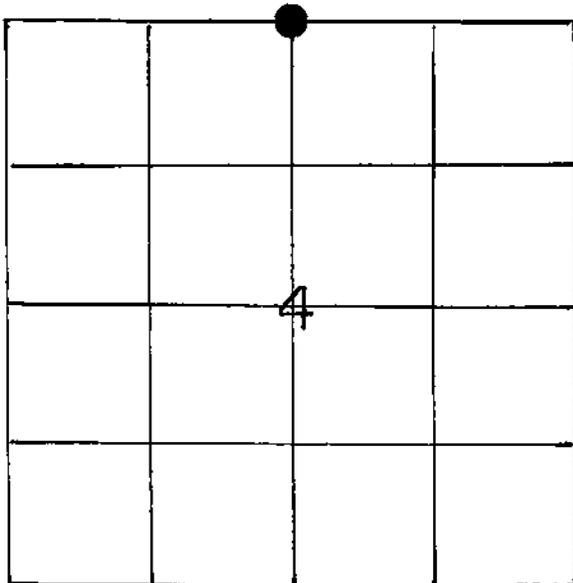

LOCATION OF LANDMARK

Crew: William Jung
Mike Weibel

1/3/85

WISCONSIN COORDINATE SYSTEM

North

East

Theta Angle

Horiz. Order

Vert. Order

TYPE OF LANDMARK

P.K. nail with the top broken off

BEARINGS ARE REFERENCED TO

Assumed

Describe any record evidence, monument evidence, testimonial evidence or any other material evidence you considered and whether the monument was found or restored through acceptance of an obliterated evidence location.


My research showed that this corner had at least four possible locations. My traversing and computations indicate to me that the corner should be set so as to fit the location shown on the last DOT hwy. map. I agree with the DOT on this corner. I discussed this problem with Ray Pelishek, and he agrees with my final location too. Rob Lampman used this corner in March of 1985.

Describe or show any material discrepancy between the location of the restored corner and that of the corner previously restored or reestablished.


I do not agree with the P.K. nail 7.4' to the West which has been used as the corner in previous surveys.

RECORD OF DURABLE WITNESS MONUMENTS

NO	DESCRIPTION	BEARING	DISTANCE
1	To a P.K. nail in a wood R/W post	- - - - -	58.49
2	Existing P.K. nail	- - - - -	7.40
3	To the middle of a steel R/W post	- - - - -	60.85
4	To the middle of the top of a steel R/W post - - - -	- - - - -	79.85

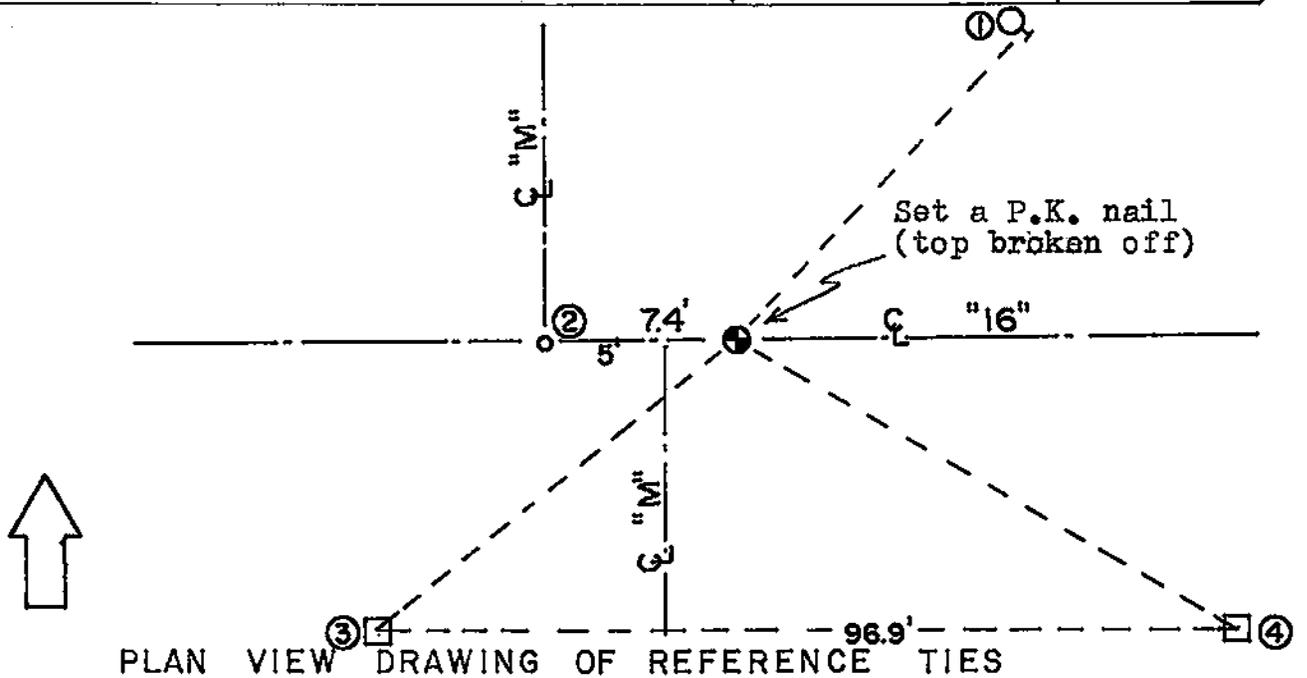

MAP SHOWING DISTANCE AND DIRECTION TO OTHER PUBLIC LAND SURVEY CORNERS USED FOR REESTABLISHING THE CORNER
(not to scale)

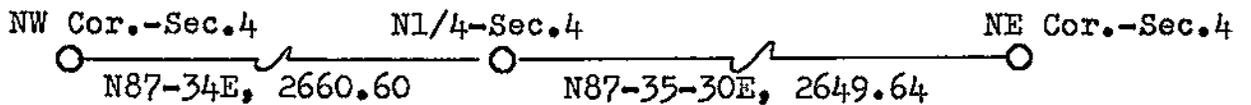

I, William C. Jung, Deputy County Surveyor,
HEREBY CERTIFY THAT THE CORNER LOCATION SHOWN ON THIS RECORD
WAS DETERMINED BY ME OR UNDER MY DIRECTION AND CONTROL AND
THAT THIS U. S. PUBLIC LAND SURVEY MONUMENT RECORD IS CORRECT
AND COMPLETE TO THE BEST OF MY KNOWLEDGE AND BELIEF.

William C. Jung 3/14/86
Signature Date

