


21706340000

U. S. PUBLIC LAND SURVEY MONUMENT RECORD

SECTION 3 T 16 N, R 6 W, VILLAGE OF WEST SALEM

LA CROSSE COUNTY

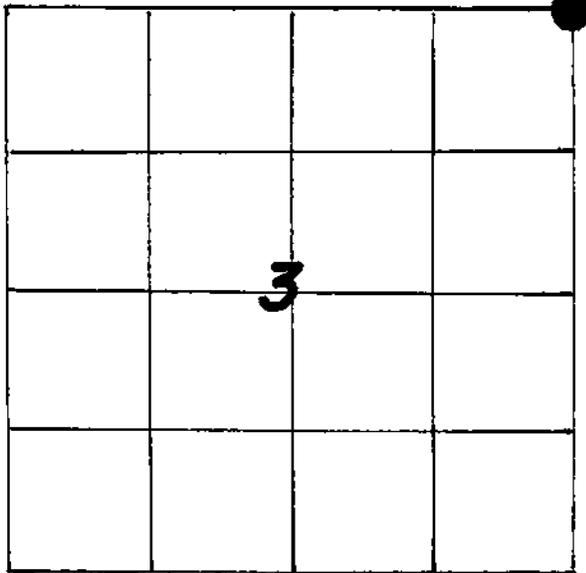

LOCATION OF LANDMARK

WISCONSIN COORDINATE SYSTEM

North 693,970.757

East 1,686,140.499

Theta Angle

Horiz. Order

Vert. Order

DATUM: 1983('91)

TYPE OF LANDMARK

~~RAILROAD SPIKE~~ P.K. nail

BEARINGS ARE REFERENCED TO

True North

CREW: BILL JUNG, PERRY DAHL
DATE: 3-16-87Crew: Bill Jung, Pete Follansbee
Revised: 11-30-89Crew: Bill Jung, Pete Follansbee
Date: 5-14-99

Describe any record evidence, monument evidence, testimonial evidence or any other material evidence you considered and whether the monument was found or restored through acceptance of an obliterated evidence location.

I found a railroad spike at the corner and accepted it as the best available evidence of the original government corner position. This railroad spike has been used as the corner in several previous surveys.


The railroad spike was destroyed in 1998 during road construction. I set a P.K. nail at the old corner location.

Describe or show any material discrepancy between the location of the restored corner and that of the corner previously restored or reestablished.

None known.

RECORD OF DURABLE WITNESS MONUMENTS

NO	DESCRIPTION	BEARING	DISTANCE
1	(191.03 North of an ex. iron bar) 1 3/4" IRON PIPE (existing)	NORTH ₊	33.00
2	behind new walk 1" IRON PIPE (set) (existing)	SOUTH ₊	33.00'
3	Existing iron bar	-----	142.98
4	To the center of a manhole	-----	99.10

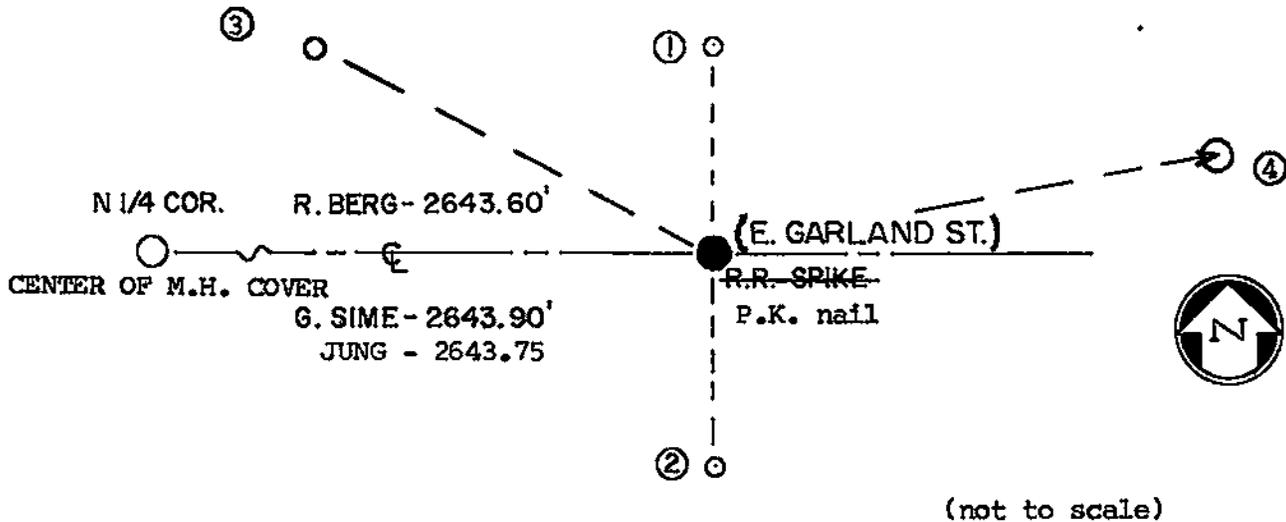


(not to scale)

PLAN VIEW DRAWING OF REFERENCE TIES



MAP SHOWING DISTANCE AND DIRECTION TO OTHER PUBLIC LAND SURVEY CORNERS USED FOR REESTABLISHING THE CORNER

(not to scale)

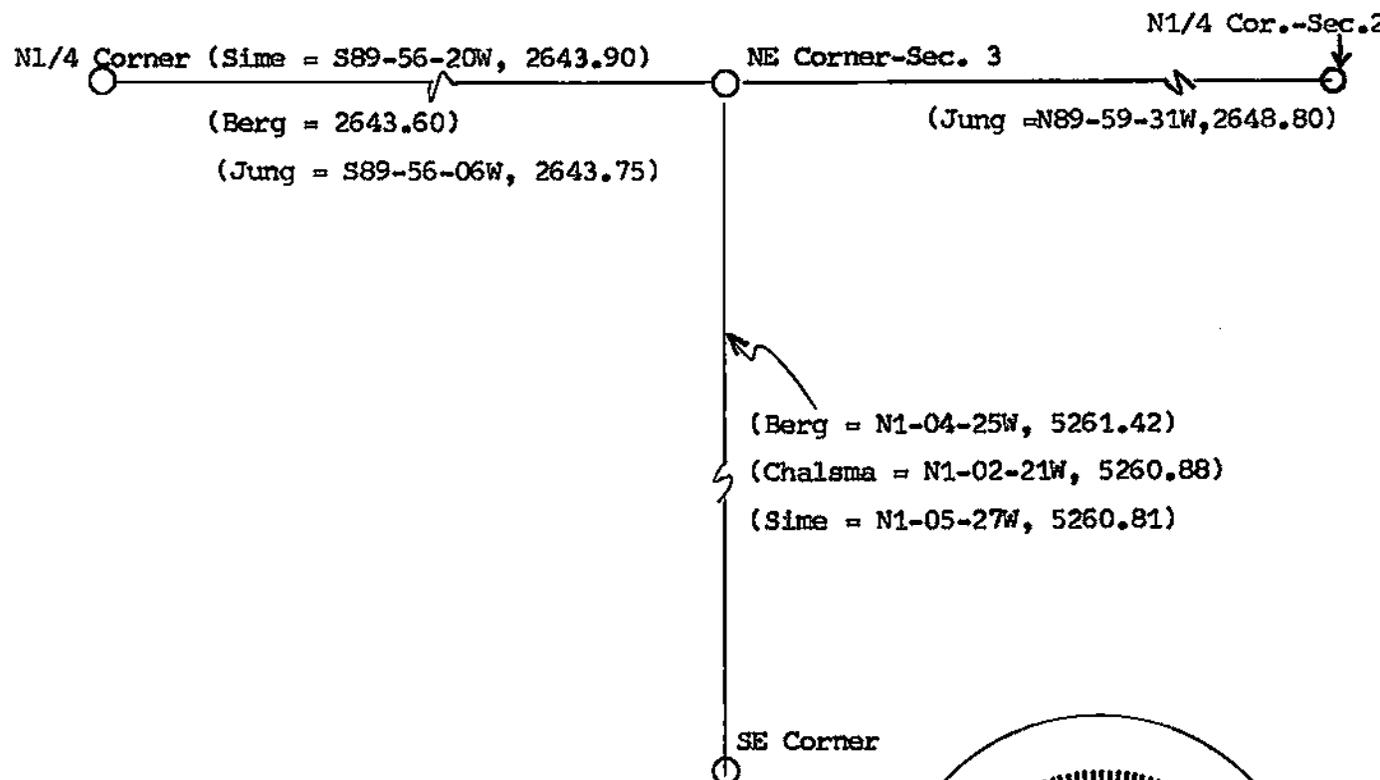

I, WILLIAM C. JUNG, ~~Deputy~~ County Surveyor,
HEREBY CERTIFY THAT THE CORNER LOCATION SHOWN ON THIS RECORD
WAS DETERMINED BY ME OR UNDER MY DIRECTION AND CONTROL AND
THAT THIS U. S. PUBLIC LAND SURVEY MONUMENT RECORD IS CORRECT
AND COMPLETE TO THE BEST OF MY KNOWLEDGE AND BELIEF.

William C. Jung
Signature
Revised: May 14, 1999 *wcj*

April 22, 1987
Date
Revised: Nov. 30, 1989 *wcj*

