


21706350000

U. S. PUBLIC LAND SURVEY MONUMENT RECORD

SECTION 1 T 16 N, R 6 W, TOWN OF HAMILTON

LA CROSSE COUNTY

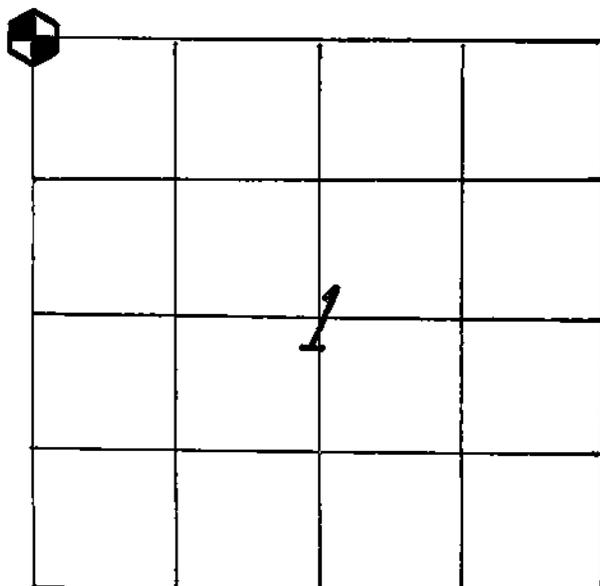

LOCATION OF LANDMARK

CREW: WILLIAM C. JUNG
 PETER F. FOLLANSBEE
 DATE: 3/12/2004

WISCONSIN COORDINATE SYSTEM

North 693,908.408

East 1,691,436.839

Theta Angle

Horiz. Order

Vert. Order

DATUM: 1983('91)

TYPE OF LANDMARK

1.75" (O.D.) x 45" IRON PIPE WITH LUNDE CAP.

BEARINGS ARE REFERENCED TO
 GRID NORTH AS PER SECTION DATA.

Describe any record evidence, monument evidence, testimonial evidence or any other material evidence you considered and whether the monument was found or restored through acceptance of an obliterated evidence location.

The iron pipe that I set at this corner back in March of 1989 was destroyed during the time that the project was going on to the West. I set a new iron pipe with a Lunde cap at my old 1989 section corner location.


Describe or show any material discrepancy between the location of the restored corner and that of the corner previously restored or reestablished.

NONE KNOWN.

RECORD OF DURABLE WITNESS MONUMENTS


MAGNETIC

NO	DESCRIPTION	BEARING	DISTANCE
1	SET A NAIL IN E-SIDE OF A 34" BURR OAK	SOUTH ±	116.78 FT.
2	SET A NAIL IN E-SIDE OF A 16-1/2" NORWAY PINE	S 35° W	84.06 FT.
3	EX. RR. NAIL IN W-SIDE OF A 16-1/4" NORWAY PINE	N 10° E	66.81 FT.
4			

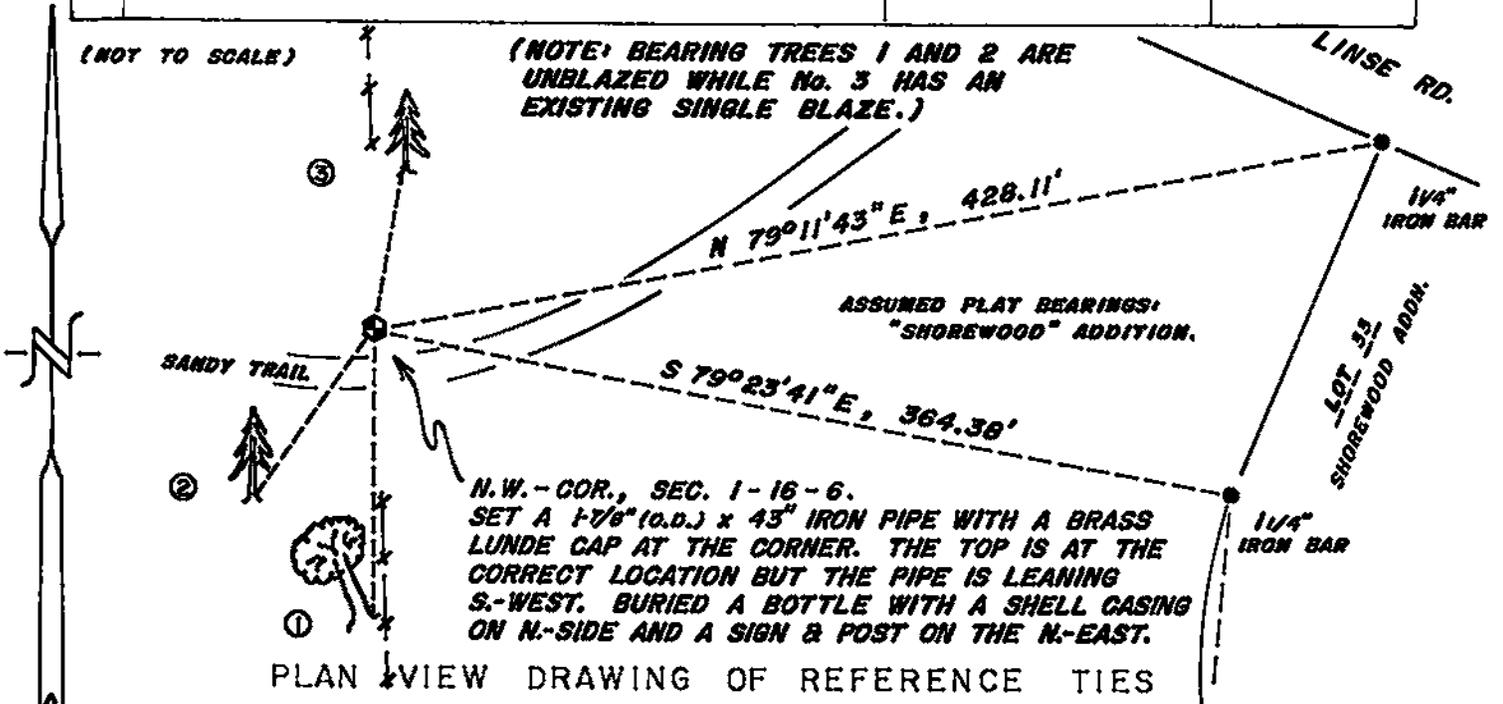

MAP SHOWING DISTANCE AND DIRECTION TO OTHER PUBLIC LAND SURVEY CORNERS USED FOR REESTABLISHING THE CORNER

(GRID BEARINGS AND DISTANCES)
(GRID FACTOR: 0.9999377)
(NOT TO SCALE)

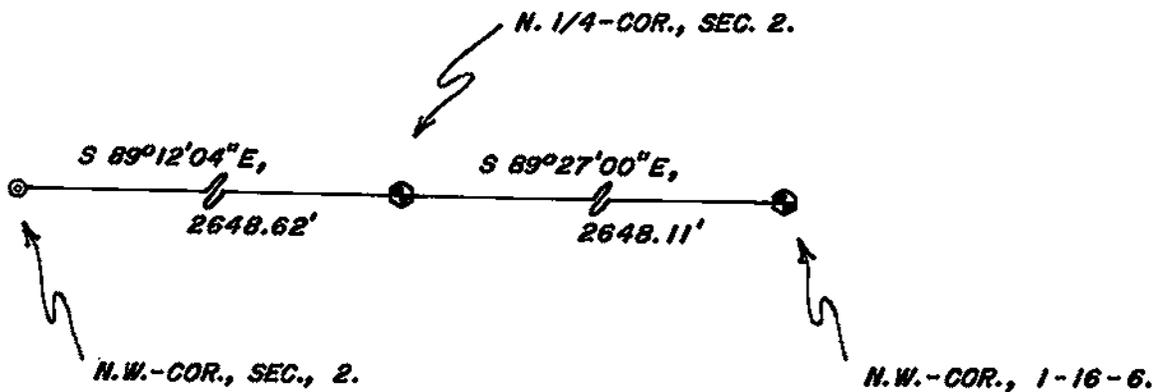

I, WILLIAM C. JUNG, COUNTY SURVEYOR
HEREBY CERTIFY THAT THE CORNER LOCATION SHOWN ON THIS RECORD WAS DETERMINED BY ME OR UNDER MY DIRECTION AND CONTROL AND THAT THIS U. S. PUBLIC LAND SURVEY MONUMENT RECORD IS CORRECT AND COMPLETE TO THE BEST OF MY KNOWLEDGE AND BELIEF.

William C. Jung 1/26/05
Signature Date




Seal

U. S. PUBLIC LAND SURVEY MONUMENT RECORD

SECTION 2 T 16 N, R 6 W, TOWN OF Hamilton

LA CROSSE COUNTY

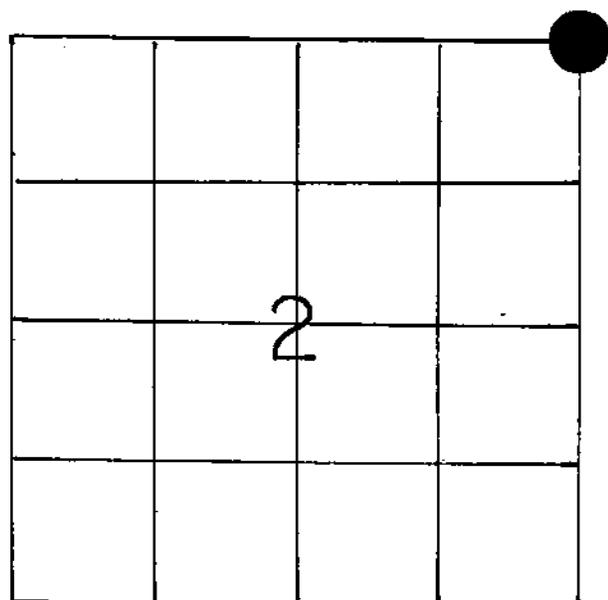

LOCATION OF LANDMARK

Crew: William C. Jung
Peter Follansbee

Date: March 30, 1989

Describe any record evidence, monument evidence, testimonial evidence or any other material evidence you considered and whether the monument was found or restored through acceptance of an obliterated evidence location.

This occupied fence corner had been used as the section corner in previous surveys. I accepted the fence corner as the best available evidence of the original government corner position. I set a 1" iron pipe at the North base of a 3½" steel fence post leaning to the South.

Describe or show any material discrepancy between the location of the restored corner and that of the corner previously restored or reestablished.

None known.

WISCONSIN COORDINATE SYSTEM

North

East

Theta Angle

Horiz. Order

Vert. Order

TYPE OF LANDMARK


1" iron pipe at fence corner

BEARINGS ARE REFERENCED TO

True

RECORD OF DURABLE WITNESS MONUMENTS


NO	DESCRIPTION	BEARING	DISTANCE
1	P.K. nail in double blazed 9" Norway	-----	59.1
2	P.K. nail in single blazed 16" Norway	-----	66.8
3	Existing P.K. nail in power pole	-----	9.1
4	P.K. nail in unblazed 30" burr oak	-----	116.8

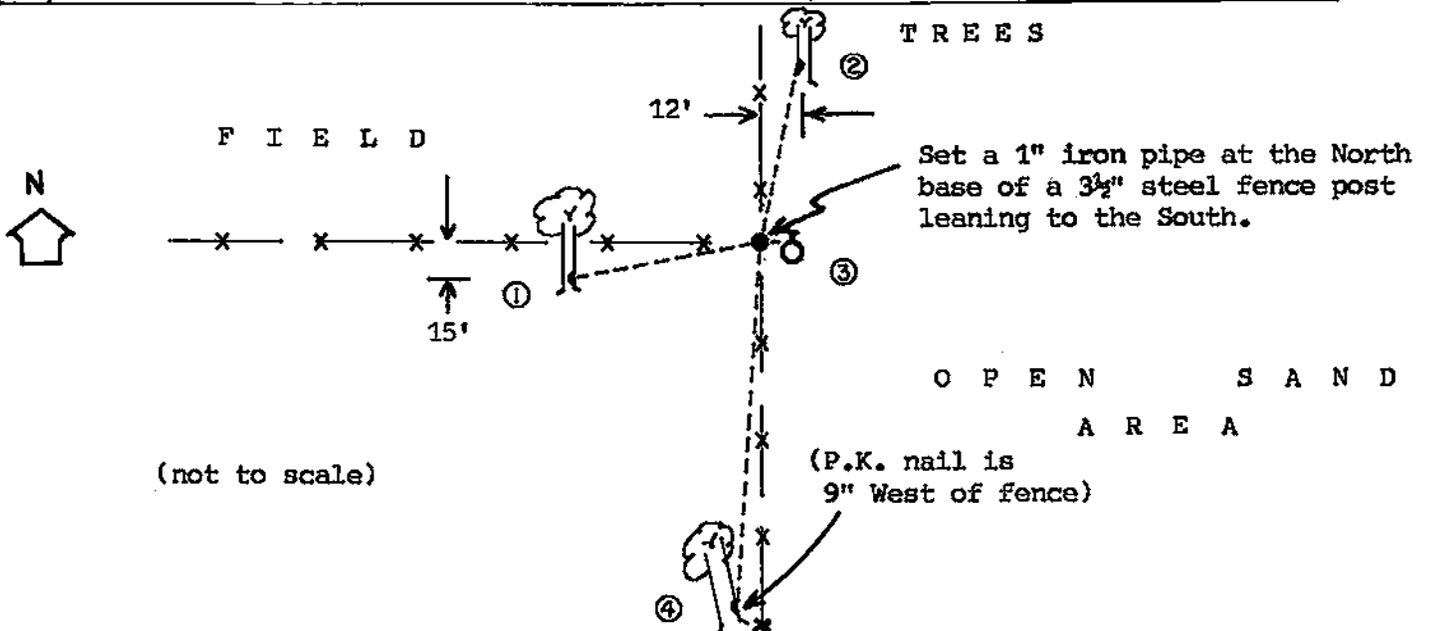

PLAN VIEW DRAWING OF REFERENCE TIES

MAP SHOWING DISTANCE AND DIRECTION TO OTHER PUBLIC LAND SURVEY CORNERS USED FOR REESTABLISHING THE CORNER

(not to scale)

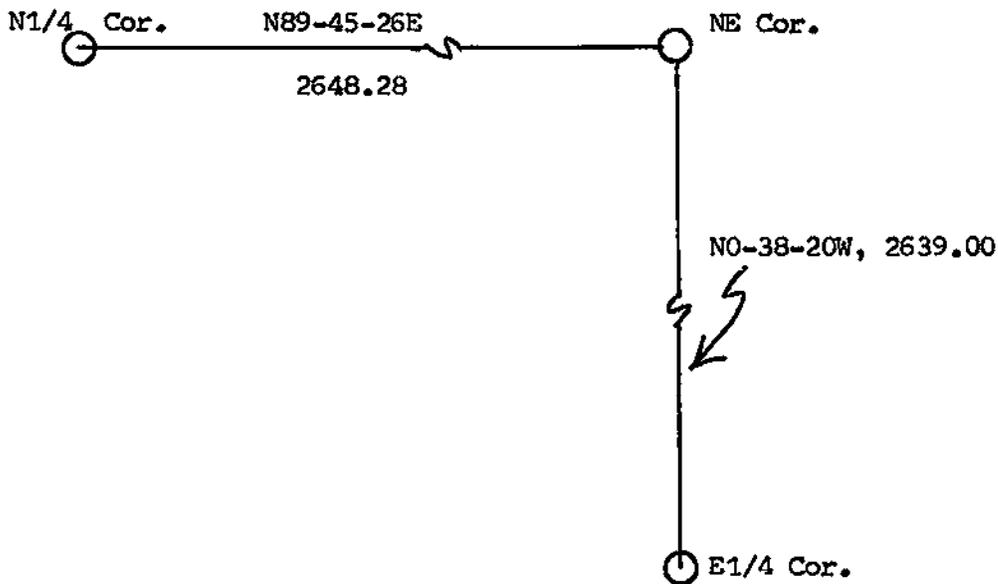

I, William C. Jung, Deputy County Surveyor,
 HEREBY CERTIFY THAT THE CORNER LOCATION SHOWN ON THIS RECORD
 WAS DETERMINED BY ME OR UNDER MY DIRECTION AND CONTROL AND
 THAT THIS U. S. PUBLIC LAND SURVEY MONUMENT RECORD IS CORRECT
 AND COMPLETE TO THE BEST OF MY KNOWLEDGE AND BELIEF.

William C. Jung July 20, 1989
 Signature Date

