


U. S. PUBLIC LAND SURVEY MONUMENT RECORD

SECTION 1 T 16 N, R 6 W, TOWN OF HAMILTON
 LA CROSSE COUNTY

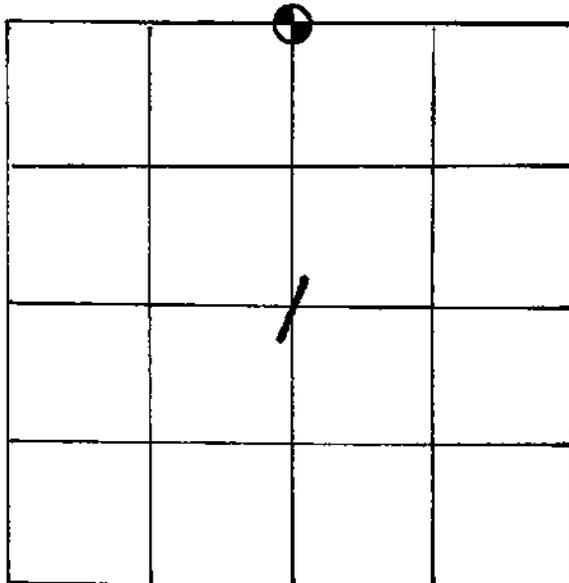

LOCATION OF LANDMARK

Crew: WILLIAM C. JUNG
 PETER F. FOLLANSBEE
 Date: 11/06/1995

WISCONSIN COORDINATE SYSTEM

North

East

Theta Angle

Horiz. Order

Vert. Order

TYPE OF LANDMARK

Set brass cap Lunde marker.

BEARINGS ARE REFERENCED TO

Describe any record evidence, monument evidence, testimonial evidence or any other material evidence you considered and whether the monument was found or restored through acceptance of an obliterated evidence location.


I found an iron bar at the corner which had been used in several previous surveys. I accepted this corner as the best available evidence of the original government corner position. The bar was removed and replaced with a brass capped Lunde marker.

Describe or show any material discrepancy between the location of the restored corner and that of the corner previously restored or reestablished.

None Known.

RECORD OF DURABLE WITNESS MONUMENTS

NO	DESCRIPTION	BEARING	DISTANCE
1	Set P.K. Nail in E.-side 8½" Burr Oak	Northwesterly ±	43.92 Ft.
2	Set P.K. Nail in E.-side 8½" Burr Oak	North ±	29.09 Ft.
3	Set P.K. Nail in E.-side 6" Burr Oak	North ±	21.00 Ft.
4	Set P.K. Nail in W.-side 11½" Burr Oak	South ±	32.55 Ft.

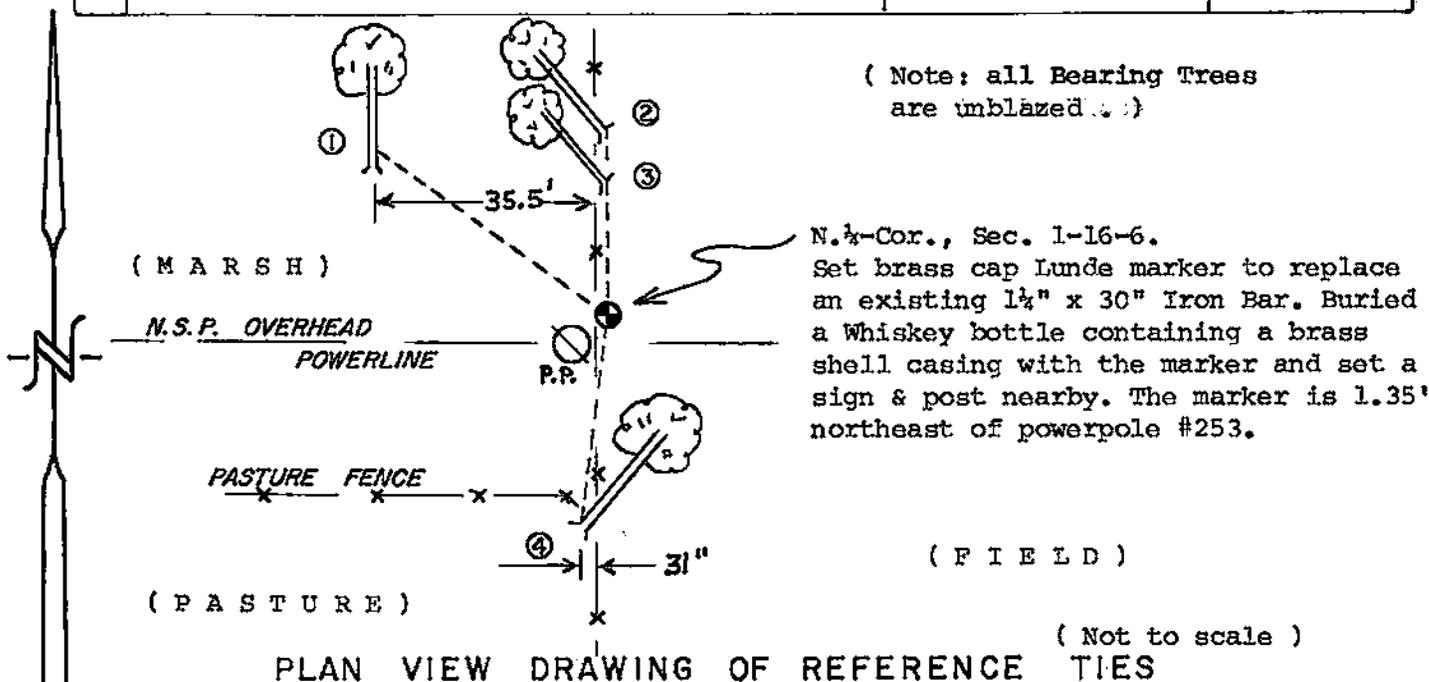


MAP SHOWING DISTANCE AND DIRECTION TO OTHER PUBLIC LAND SURVEY CORNERS USED FOR REESTABLISHING THE CORNER

No section measurements were made by me at this time. This corner location was confirmed by previous section measurements.

I, William C. Jung, County Surveyor
HEREBY CERTIFY THAT THE CORNER LOCATION SHOWN ON THIS RECORD WAS DETERMINED BY ME OR UNDER MY DIRECTION AND CONTROL AND THAT THIS U. S. PUBLIC LAND SURVEY MONUMENT RECORD IS CORRECT AND COMPLETE TO THE BEST OF MY KNOWLEDGE AND BELIEF.

William C. Jung 12/7/95
Signature Date

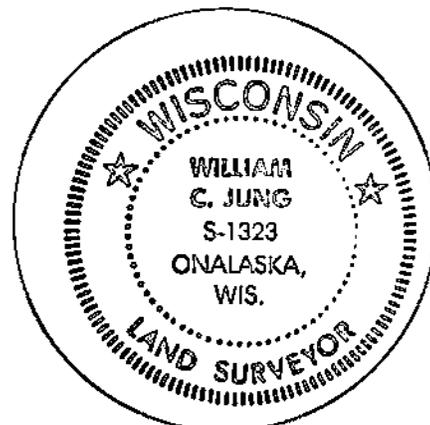

Seal