


U. S. PUBLIC LAND SURVEY MONUMENT RECORD

SECTION 1 T 16 N, R 7 W, ~~TOWN OF~~ CITY OF ONALASKA
 LA CROSSE COUNTY

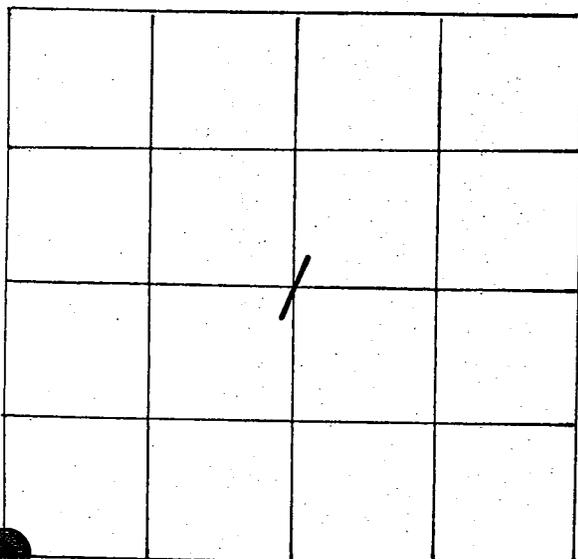

LOCATION OF LANDMARK

CREW: WILLIAM C. JUNG
 PETER F. FOLLANSBEE
 DATE: 10/14/2005

WISCONSIN COORDINATE SYSTEM
North
East
Theta Angle
Horiz. Order
Vert. Order
TYPE OF LANDMARK
1/4" IRON BAR. (18" LONG)
BEARINGS ARE REFERENCED TO

Describe any record evidence, monument evidence, testimonial evidence or any other material evidence you considered and whether the monument was found or restored through acceptance of an obliterated evidence location.


This corner was again knocked out due to new road construction. Paul Fairchild set a new iron bar at the old corner location. We took new ties to this iron bar.

Describe or show any material discrepancy between the location of the restored corner and that of the corner previously restored or reestablished.


NONE KNOWN.

RECORD OF DURABLE WITNESS MONUMENTS

NO	DESCRIPTION	MAGNETIC BEARING	DISTANCE
1	EX. P.K. NAIL IN E.-SIDE OF A POWER POLE	NORTH ±	SLOPE = 86.20'
2	SET A NAIL IN W.-SIDE OF A LARGE TREE	EASTERLY ±	63.33 FT.
3	SET A DRILL HOLE IN THE TOP OF CONC. CURB	S 88° E	38.64 FT.
4	CENTER OF AN EX. MANHOLE IN THE ROADWAY	S 12° E	103.97 FT.

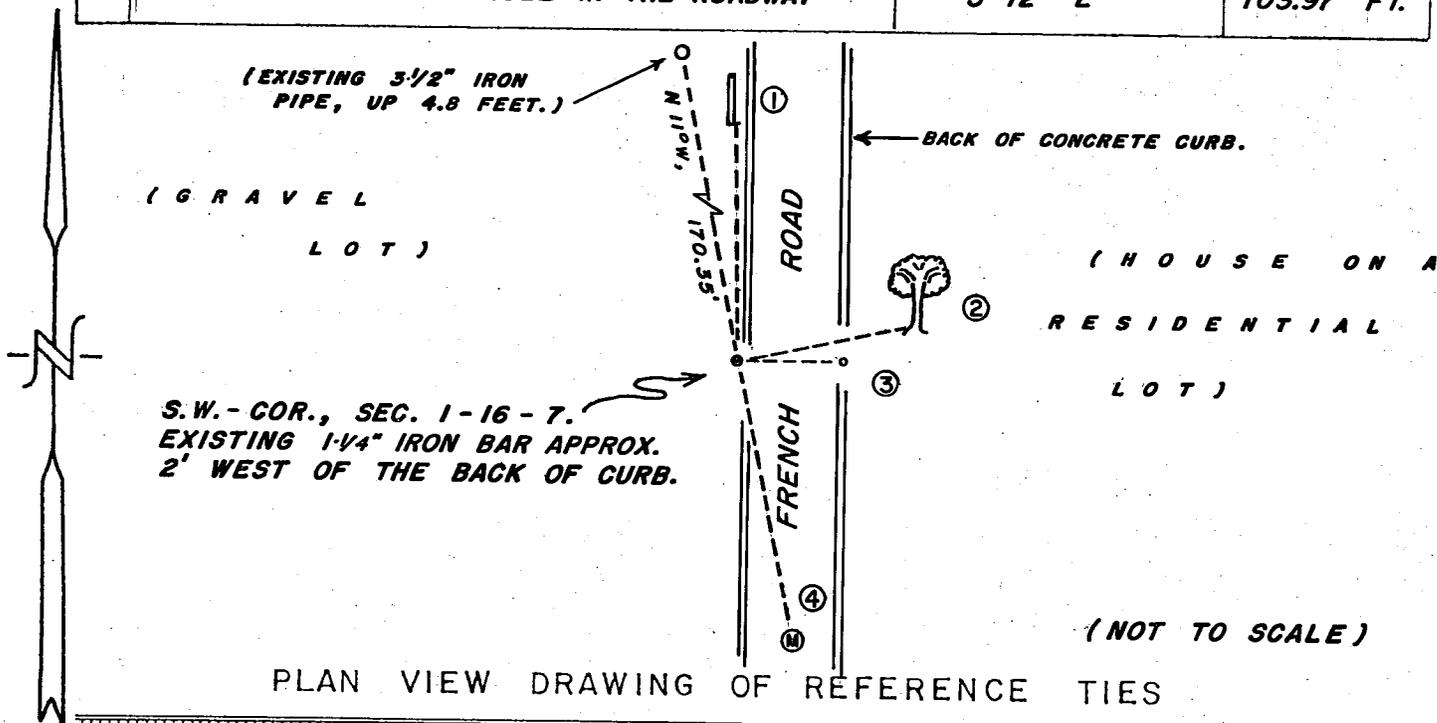

MAP SHOWING DISTANCE AND DIRECTION TO OTHER PUBLIC LAND SURVEY CORNERS USED FOR REESTABLISHING THE CORNER

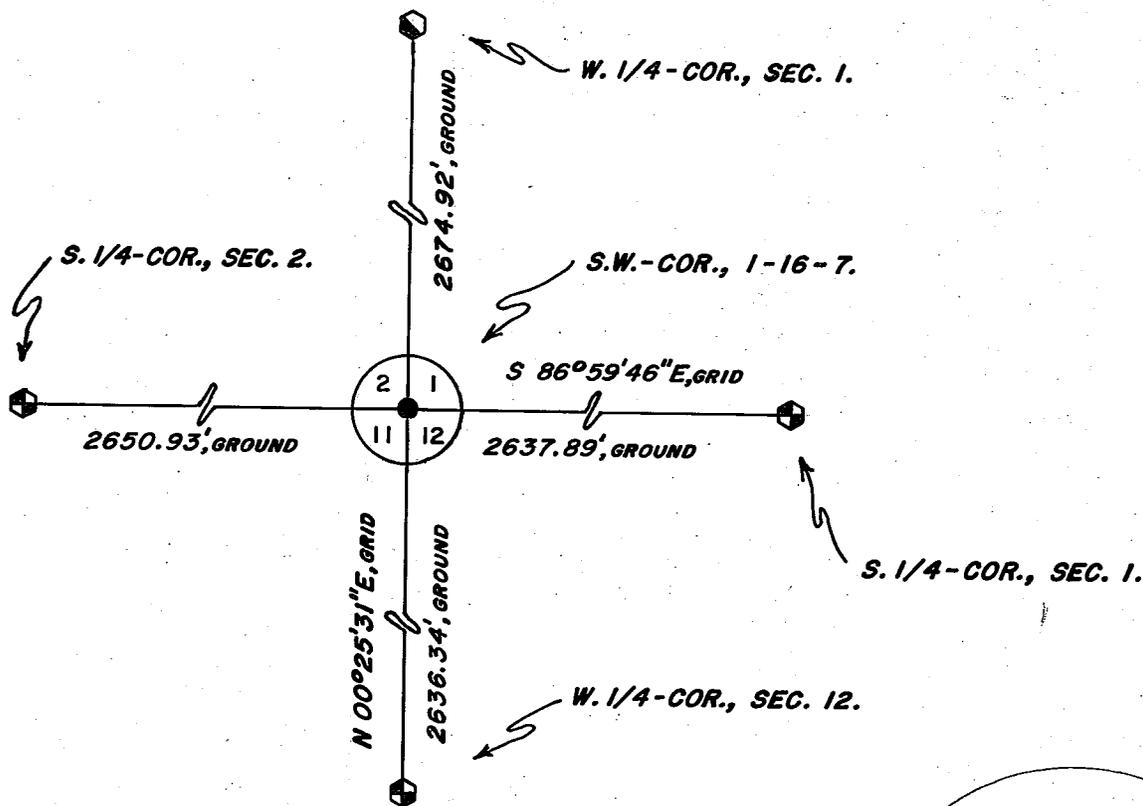

I, WILLIAM C. JUNG, COUNTY SURVEYOR
HEREBY CERTIFY THAT THE CORNER LOCATION SHOWN ON THIS RECORD
WAS DETERMINED BY ME OR UNDER MY DIRECTION AND CONTROL AND
THAT THIS U. S. PUBLIC LAND SURVEY MONUMENT RECORD IS CORRECT
AND COMPLETE TO THE BEST OF MY KNOWLEDGE AND BELIEF.


William C. Jung 1/9/06
Signature Date



Seal

U. S. PUBLIC LAND SURVEY MONUMENT RECORD

SECTION 12 T 16 N, R 7 W, TOWN OF MEDARY
LA CROSSE COUNTY

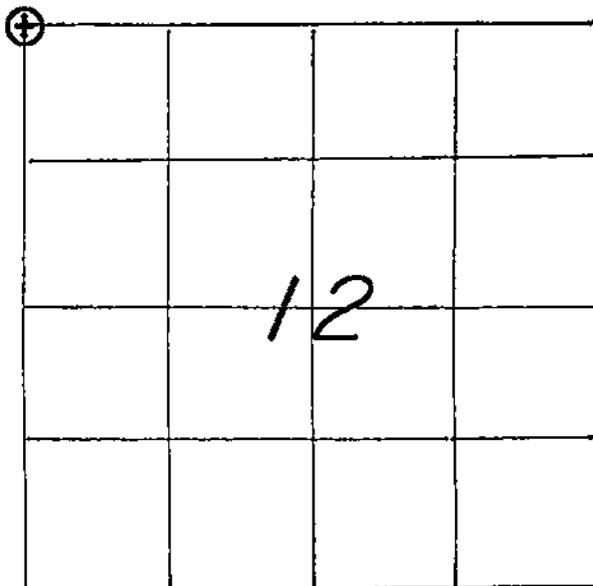

LOCATION OF LANDMARK

CREW: **WILLIAM C. JUNG**
PETER F. FOLLANSBEE
DATE: **5/04/1999**

WISCONSIN COORDINATE SYSTEM

North

East

Theta Angle

Horiz. Order

Vert. Order

TYPE OF LANDMARK

3/4" x 16" ROUND IRON BAR WITH ALUMINUM CAP

BEARINGS ARE REFERENCED TO

ASSUMED NORTH.

Describe any record evidence, monument evidence, testimonial evidence or any other material evidence you considered and whether the monument was found or restored through acceptance of an obliterated evidence location.


I removed the Lunde marker last year because of road construction and then set a 3/4"x16" round iron bar with a cap this year as a replacement.

Describe or show any material discrepancy between the location of the restored corner and that of the corner previously restored or reestablished.

NONE KNOWN.


RECORD OF DURABLE WITNESS MONUMENTS

NO	DESCRIPTION	BEARING	DISTANCE
1	SET A SPIKE AT THE PREVIOUS LOCATION OF AN IRON PIPE	WEST ±	34.17 FT.
2	SET A P.K. NAIL IN N.W.-SIDE UNBLAZED 10-1/2" ELM (?)	N. EASTERLY ±	63.08 FT.
3	EXIST. P.K. NAIL IN W-SIDE UNBLAZED TREE	EASTERLY ±	63.52 FT.
4	SET A P.K. NAIL IN THE TRAVELLED E OF NEW PAVEMENT	EAST ±	17.88 FT.

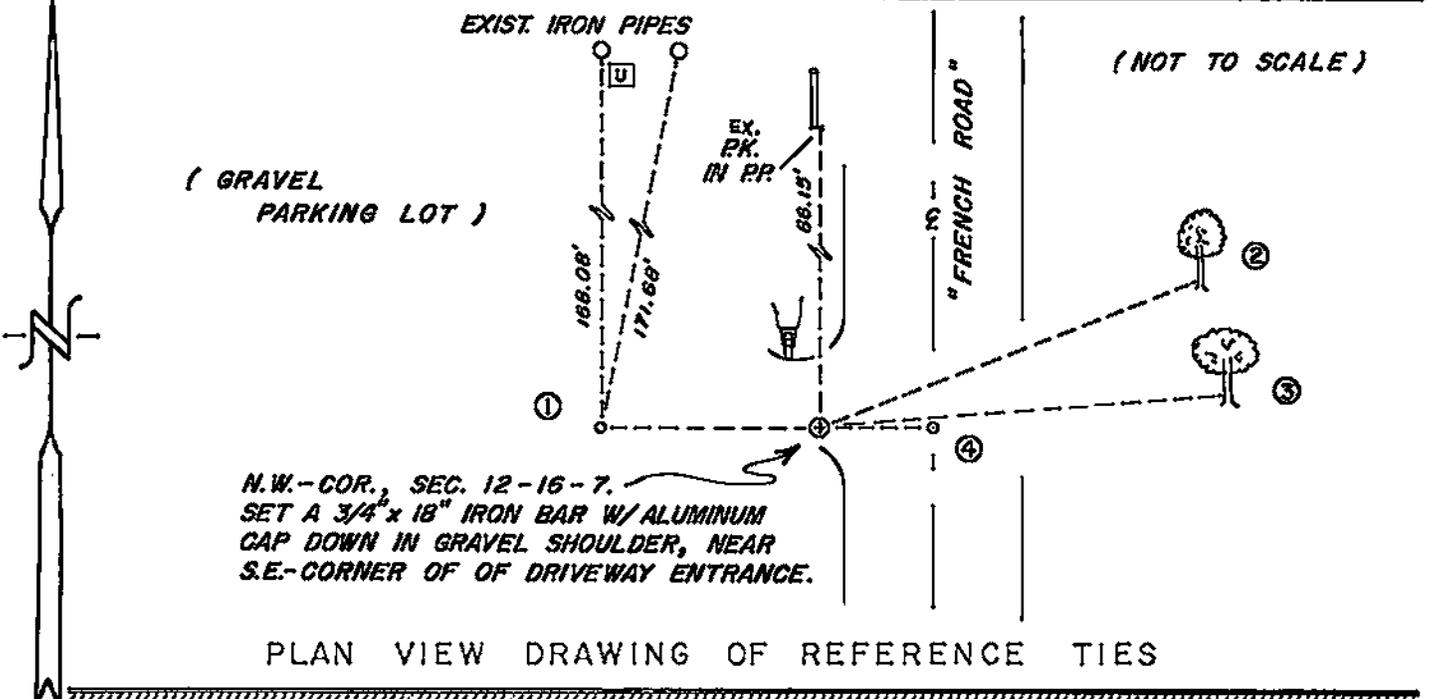

MAP SHOWING DISTANCE AND DIRECTION TO OTHER PUBLIC LAND SURVEY CORNERS USED FOR REESTABLISHING THE CORNER

(not to scale)

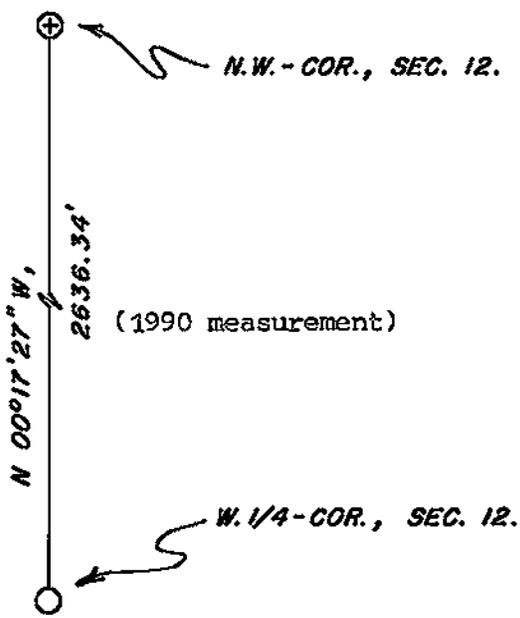

I, WILLIAM C. JUNG, COUNTY SURVEYOR
 HEREBY CERTIFY THAT THE CORNER LOCATION SHOWN ON THIS RECORD WAS DETERMINED BY ME OR UNDER MY DIRECTION AND CONTROL AND THAT THIS U. S. PUBLIC LAND SURVEY MONUMENT RECORD IS CORRECT AND COMPLETE TO THE BEST OF MY KNOWLEDGE AND BELIEF.


William C. Jung 5/18/99
 Signature Date



Seal

U. S. PUBLIC LAND SURVEY MONUMENT RECORD

SECTION 12 T 16 N, R 7 W, TOWN OF MEDARY
 LA CROSSE COUNTY

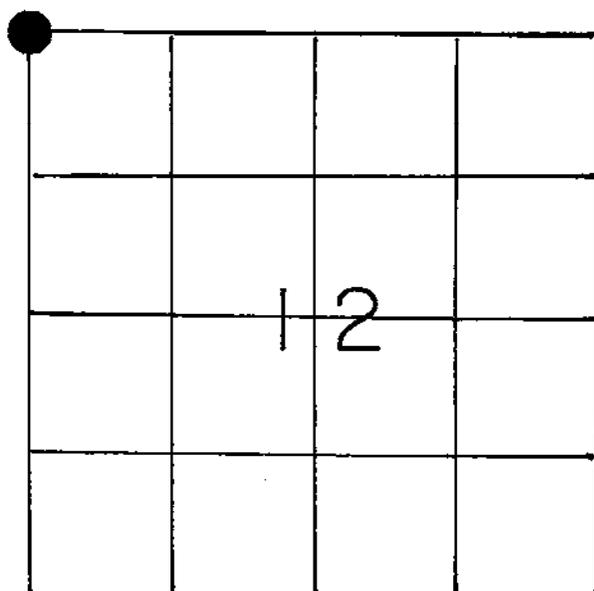

LOCATION OF LANDMARK

Crew: William C. Jung
 Peter F. Follansbee

Dates: July 25, 1990 and September 4, 1990

Describe any record evidence, monument evidence, testimonial evidence or any other material evidence you considered and whether the monument was found or restored through acceptance of an obliterated evidence location.

I found a 2" iron pipe at the corner which had been used as the accepted section corner in many previous surveys. I removed the pipe and replaced it with a Lunde marker. I also buried a bottle with the corner and placed a sign and post by the corner.

Describe or show any material discrepancy between the location of the restored corner and that of the corner previously restored or reestablished.


None known.

WISCONSIN COORDINATE SYSTEM
North
East
Theta Angle
Horiz. Order
Vert. Order
TYPE OF LANDMARK
Brass capped Lunde marker
BEARINGS ARE REFERENCED TO
Assumed

VOID

RECORD OF DURABLE WITNESS MONUMENTS

NO	DESCRIPTION	BEARING	DISTANCE
1	Set a 1" iron pipe behind an old wood R/W post	N0°32'22"W	351.58
2	Northeast corner of building	-----	11.71
3	P.K. nail in utility pole	-----	86.14
4	Set a railroad spike in the travelled centerline	-----	18.42

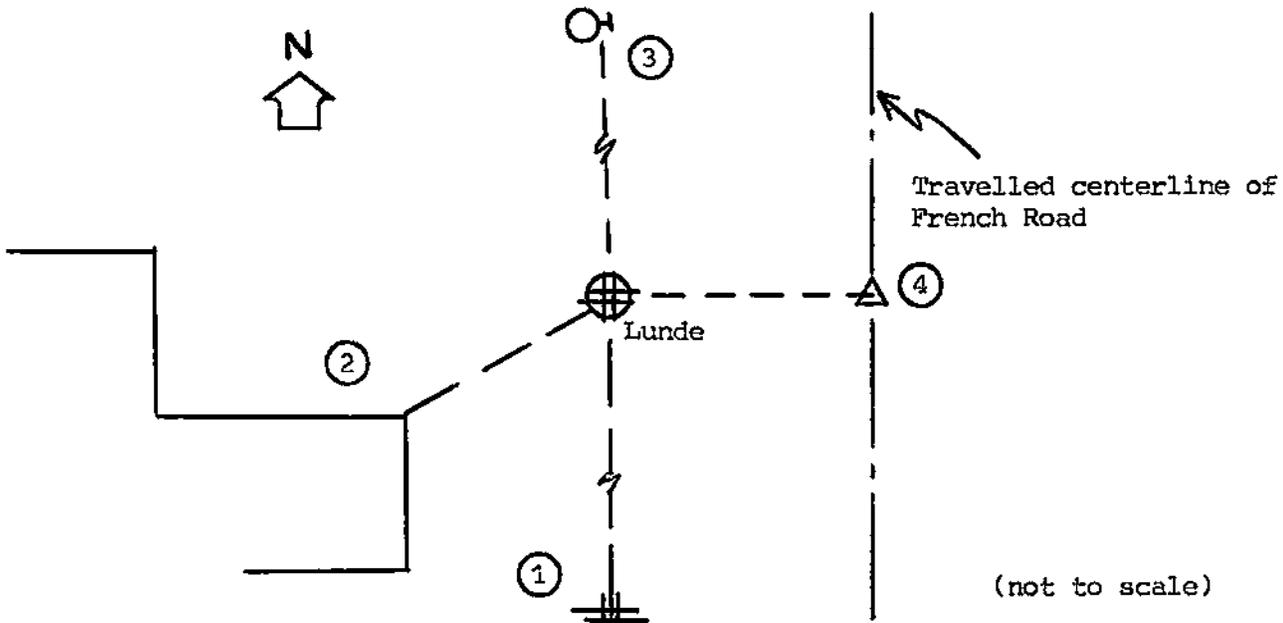


PLAN VIEW DRAWING OF REFERENCE TIES



MAP SHOWING DISTANCE AND DIRECTION TO OTHER PUBLIC LAND SURVEY CORNERS USED FOR REESTABLISHING THE CORNER


(not to scale)

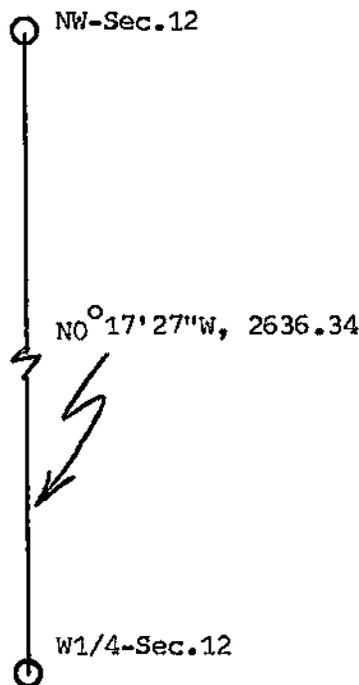

I, William C. Jung, Deputy County Surveyor,
 HEREBY CERTIFY THAT THE CORNER LOCATION SHOWN ON THIS RECORD
 WAS DETERMINED BY ME OR UNDER MY DIRECTION AND CONTROL AND
 THAT THIS U. S. PUBLIC LAND SURVEY MONUMENT RECORD IS CORRECT
 AND COMPLETE TO THE BEST OF MY KNOWLEDGE AND BELIEF.

William C. Jung
 Signature

January 10, 1991
 Date

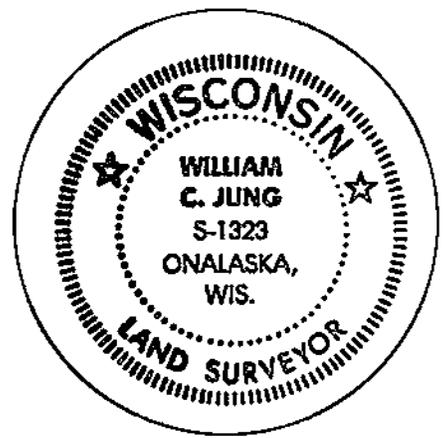

Seal