


U. S. PUBLIC LAND SURVEY MONUMENT RECORD

SECTION 2 T 16 N, R 7 W, TOWN OF MEDARY

LA CROSSE COUNTY

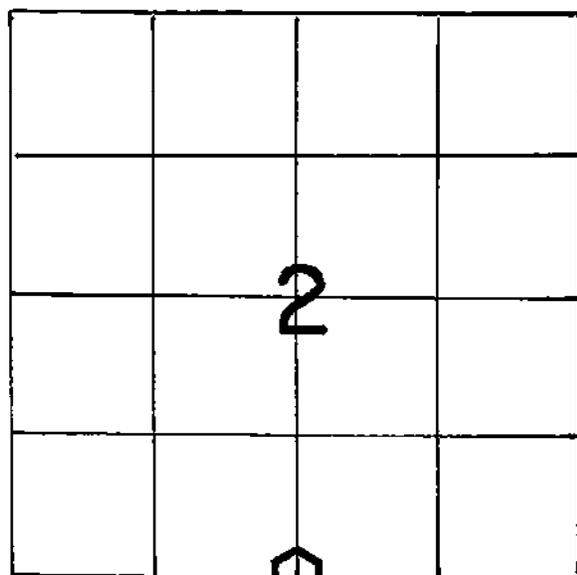

LOCATION OF LANDMARK

Crew: William C. Jung
Peter F. Follansbee

Date: August 15, 1991

Describe any record evidence, monument evidence, testimonial evidence or any other material evidence you considered and whether the monument was found or restored through acceptance of an obliterated evidence location.

Paul Fairchild found an existing 1½" iron pipe at the corner. He accepted this pipe as the best available evidence of the original government corner position. After discussing this corner with Paul, I agreed with his opinion. I removed the pipe and replaced it with a Lunde marker. To the North I set a sign and post. The existing 1½"x14" iron pipe was buried by the Lunde as was a bottle with a brass shell casing, set as a memorial. Fairchild and I do not know who set the pipe. Neither Van Loon's or Kraft's field notes tell us. The Lunde is about 16.5' North of the fence.

Describe or show any material discrepancy between the location of the restored corner and that of the corner previously restored or reestablished.

About S63°W, 7.35 feet from the Lunde is a 2¼" cast iron pipe which I do not agree with.

WISCONSIN COORDINATE SYSTEM

North

East

Theta Angle

Horiz. Order

Vert. Order


TYPE OF LANDMARK

Brass capped Lunde marker

BEARINGS ARE REFERENCED TO

RECORD OF DURABLE WITNESS MONUMENTS
Magnetic

NO	DESCRIPTION	BEARING	DISTANCE
1	Ex. 1" iron pipe at a fence corner	S40°W	38.49
2	" by a 16" oak	N42°W	21.95
3	" by 16" and 18" double oaks	N24°E	34.81
4	" by a 10" spruce	S48°E	25.94

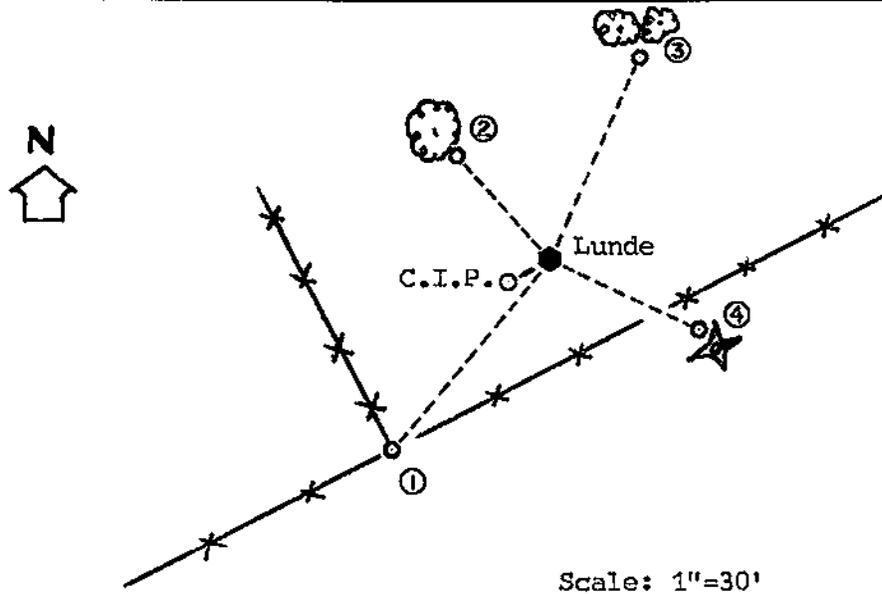

PLAN VIEW DRAWING OF REFERENCE TIES


MAP SHOWING DISTANCE AND DIRECTION TO OTHER PUBLIC LAND SURVEY CORNERS USED FOR REESTABLISHING THE CORNER

I did not personally make any section measurements at this time. However I did review section data as submitted by Scholze, Logan, and Fairchild. Their data agreed.

I, William C. Jung, Deputy County Surveyor,
HEREBY CERTIFY THAT THE CORNER LOCATION SHOWN ON THIS RECORD WAS DETERMINED BY ME OR UNDER MY DIRECTION AND CONTROL AND THAT THIS U. S. PUBLIC LAND SURVEY MONUMENT RECORD IS CORRECT AND COMPLETE TO THE BEST OF MY KNOWLEDGE AND BELIEF.

William C. Jung
Signature

October 4, 1991
Date

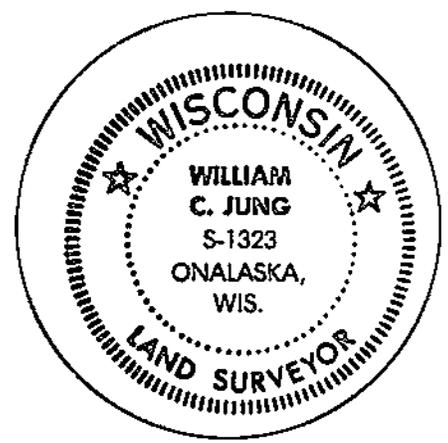

Seal