


U. S. PUBLIC LAND SURVEY MONUMENT RECORD

SECTION 1 T 16 N, R 7 W, TOWN OF MEDARY
 LA CROSSE COUNTY

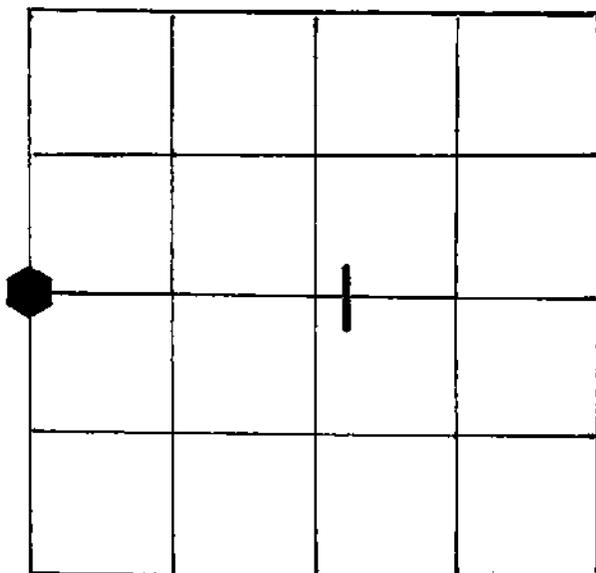

LOCATION OF LANDMARK

WISCONSIN COORDINATE SYSTEM
North
East
Theta Angle
Horiz. Order
Vert. Order
TYPE OF LANDMARK
Set Berntsen Top in exist. 1 1/4" I.P.
BEARINGS ARE REFERENCED TO

Crew: WILLIAM C. JUNG

Date: 7/22/1993

Describe any record evidence, monument evidence, testimonial evidence or any other material evidence you considered and whether the monument was found or restored through acceptance of an obliterated evidence location.

I found an old fence corner with an iron pipe at the corner. This pipe had been used as the corner in previous surveys. I accepted this location as the best available evidence of the original government corner position. I set a Berntsen top in the existing iron pipe.

Describe or show any material discrepancy between the location of the restored corner and that of the corner previously restored or reestablished.

None Known

