


21607022020

U. S. PUBLIC LAND SURVEY MONUMENT RECORD

SECTION 2 T 16 N, R 7 W, TOWN OF Medary

LA CROSSE COUNTY

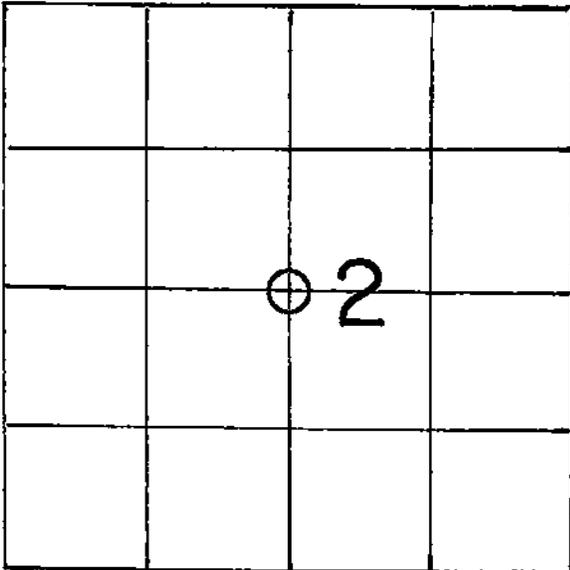

LOCATION OF LANDMARK

Crew: WILLIAM C. JUNG
 PETER F. FOLLANSBEE

Date: 8/03/1993

Describe any record evidence, monument evidence, testimonial evidence or any other material evidence you considered and whether the monument was found or restored through acceptance of an obliterated evidence location.

I found an iron pipe at the old occupied fence corner. This pipe had been used as the center of section in previous surveys by a number of surveyors, possibly four. This old corner is probably an old irregular center of section.

Describe or show any material discrepancy between the location of the restored corner and that of the corner previously restored or reestablished.

None Known

WISCONSIN COORDINATE SYSTEM
North
East
Theta Angle
Horiz. Order
Vert. Order
TYPE OF LANDMARK
Existing 1½" Iron Pipe
BEARINGS ARE REFERENCED TO

