


21607030020

U. S. PUBLIC LAND SURVEY MONUMENT RECORD

SECTION 10 T 16 N, R 7 W, CITY OF ONALASKA

LA CROSSE COUNTY

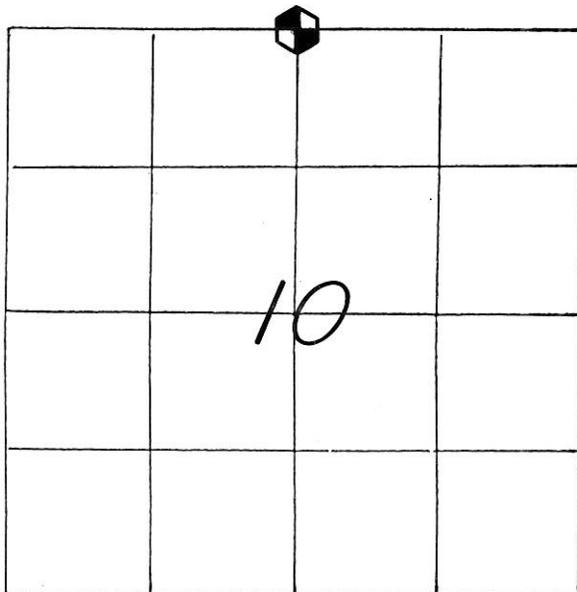

LOCATION OF LANDMARK

CREW: **WILLIAM C. JUNG**
PETER F. FOLLANSBEE
 DATE: **3/23/2000**

WISCONSIN COORDINATE SYSTEM

North

East

Theta Angle

Horiz. Order

Vert. Order

TYPE OF LANDMARK

BRASS CAP LUNDE MARKER.

BEARINGS ARE REFERENCED TO

Describe any record evidence, monument evidence, testimonial evidence or any other material evidence you considered and whether the monument was found or restored through acceptance of an obliterated evidence location.

The corner of record was disturbed during the construction of the new school.

The bearing trees were destroyed. I found the old iron pipe bent and buried.


I set a brass capped Lunde marker at the corner over the pipe.

Describe or show any material discrepancy between the location of the restored corner and that of the corner previously restored or reestablished.

NONE KNOWN.

RECORD OF DURABLE WITNESS MONUMENTS
Magnetic

NO	DESCRIPTION	BEARING	DISTANCE
1	SET A NAIL IN THE S.W.-SIDE OF A 15" ELM.	N 57° W	36.61 FT.
2	SET A NAIL IN THE N.E.-SIDE OF A 12" TREE.	N 73° W	42.23 FT.
3	CENTER OF NORTH POST OF BACK STOP FENCE	S 03° E	SL. = 62.63 FT.
4	MOST NORTHERLY CONCRETE COR. OF DROP INLET	S 12° E	SL. = 119.12'

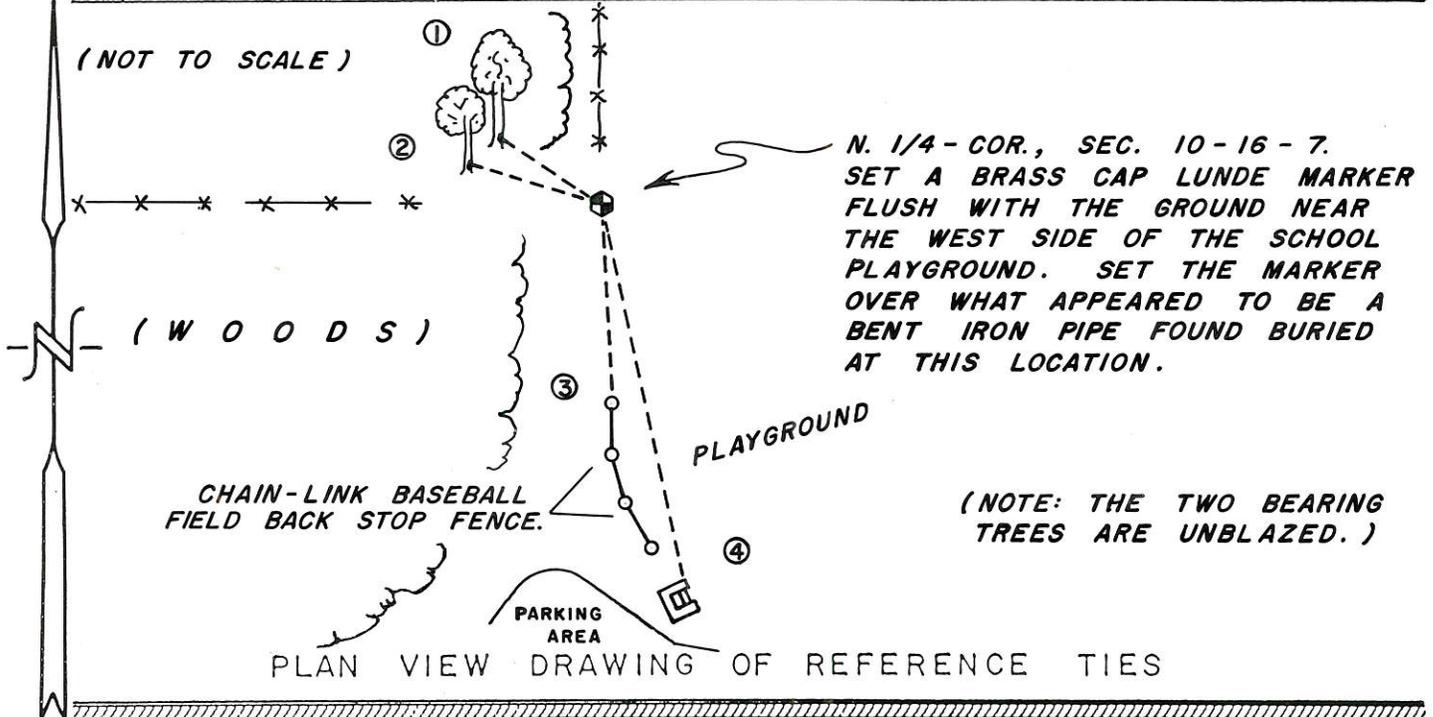

MAP SHOWING DISTANCE AND DIRECTION TO OTHER PUBLIC LAND SURVEY CORNERS USED FOR REESTABLISHING THE CORNER

No new section measurements were made by me at this time.

I, William C. Jung, County Surveyor,
HEREBY CERTIFY THAT THE CORNER LOCATION SHOWN ON THIS RECORD WAS DETERMINED BY ME OR UNDER MY DIRECTION AND CONTROL AND THAT THIS U. S. PUBLIC LAND SURVEY MONUMENT RECORD IS CORRECT AND COMPLETE TO THE BEST OF MY KNOWLEDGE AND BELIEF.

William C. Jung 5/12/00
Signature Date



Seal