


U. S. PUBLIC LAND SURVEY MONUMENT RECORD

SECTION 2 T 16 N, R 7 W, ~~TOWN OF~~ CITY OF ONALASKA

LA CROSSE COUNTY

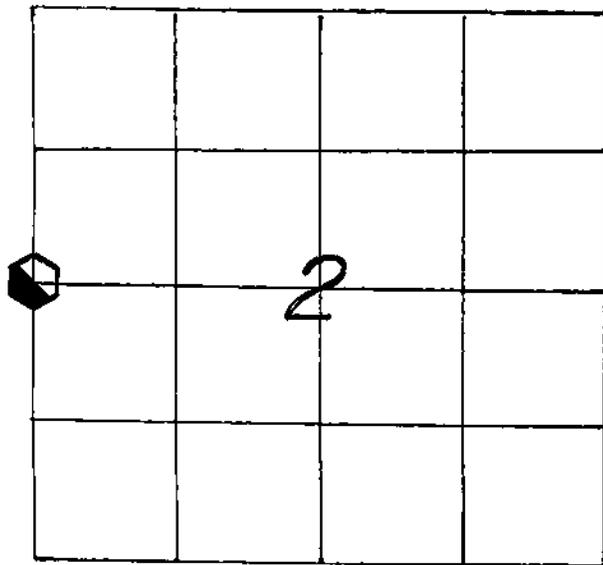

WISCONSIN COORDINATE SYSTEM

North

East

Theta Angle

Horiz. Order

Vert. Order

TYPE OF LANDMARK

30" ALUMINUM BERNTSEN MARKER.

BEARINGS ARE REFERENCED TO

ASSUMED NORTH AS PER SECTION DATA.

LOCATION OF LANDMARK

CREW: WILLIAM G. JUNG
 PETER F. FOLLANSBEE
 DATE: 01/05/2006

Describe any record evidence, monument evidence, testimonial evidence or any other material evidence you considered and whether the monument was found or restored through acceptance of an obliterated evidence location.


We found a pipe at the old occupied fence corner. This pipe had been used as the corner in several previous surveys. I accepted the pipe and this location as the best available evidence of the original government corner position. I removed the pipe and replaced it with Berntsen marker.

Describe or show any material discrepancy between the location of the restored corner and that of the corner previously restored or reestablished.


NONE KNOWN.

RECORD OF DURABLE WITNESS MONUMENTS

NO	DESCRIPTION	MAGNETIC	
		BEARING	DISTANCE
1	SET A NAIL IN N.-SIDE OF A 24" OAK	WESTERLY ±	12.68 FT.
2	SET A NAIL IN S.W.-SIDE OF A 7-1/4" OAK	N 30° W	27.52 FT.
3	SET A NAIL IN S.W.-SIDE OF A 7-1/2" WHITE OAK	N 05° W	SLOPE=52.14'
4	SET A 1" x 30" IRON PIPE 4' SOUTH OF THE FENCE	S 80° E	SLOPE=35.05'

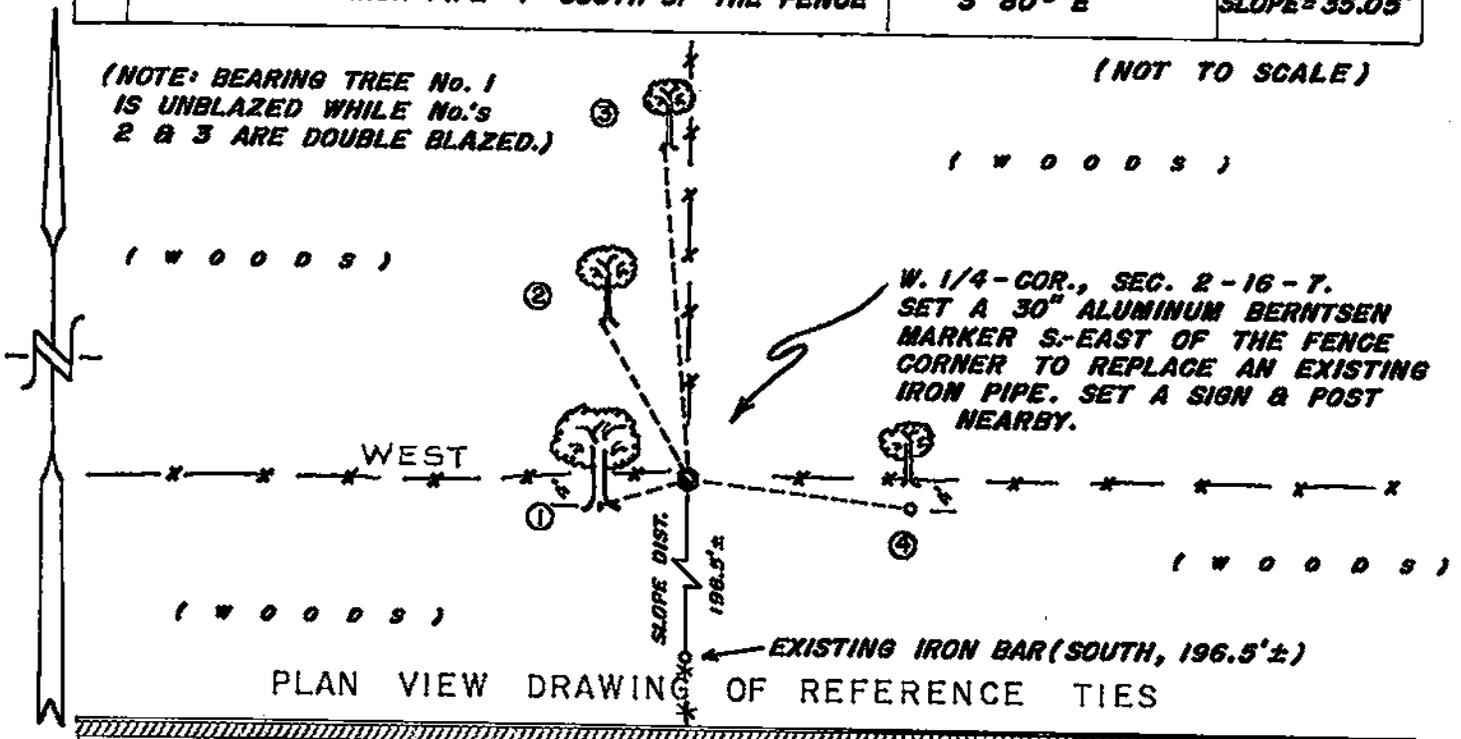

MAP SHOWING DISTANCE AND DIRECTION TO OTHER PUBLIC LAND SURVEY CORNERS USED FOR REESTABLISHING THE CORNER

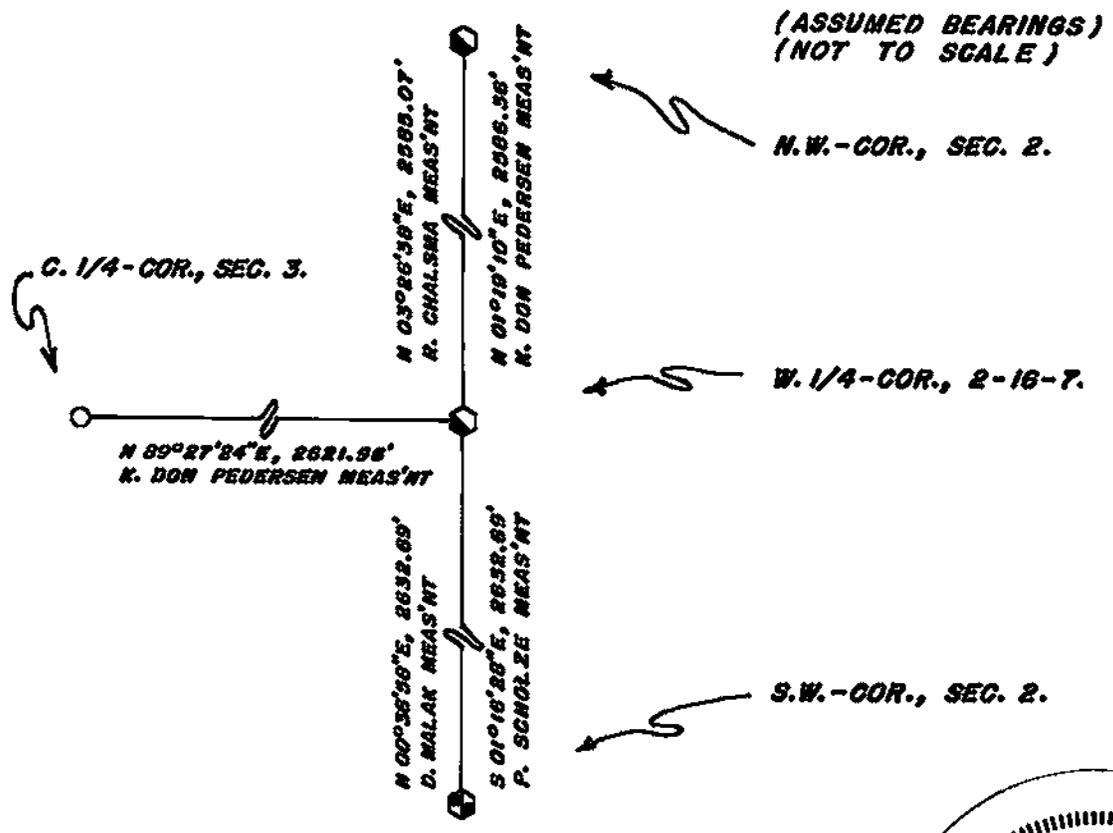

I, WILLIAM C. JUNG, COUNTY SURVEYOR
 HEREBY CERTIFY THAT THE CORNER LOCATION SHOWN ON THIS RECORD
 WAS DETERMINED BY ME OR UNDER MY DIRECTION AND CONTROL AND
 THAT THIS U. S. PUBLIC LAND SURVEY MONUMENT RECORD IS CORRECT
 AND COMPLETE TO THE BEST OF MY KNOWLEDGE AND BELIEF.

William C. Jung 1/19/06
 Signature Date



Seal