


U. S. PUBLIC LAND SURVEY MONUMENT RECORD

SECTION 10 T 16 N, R 7 W, CITY OF ONALASKA

LA CROSSE COUNTY

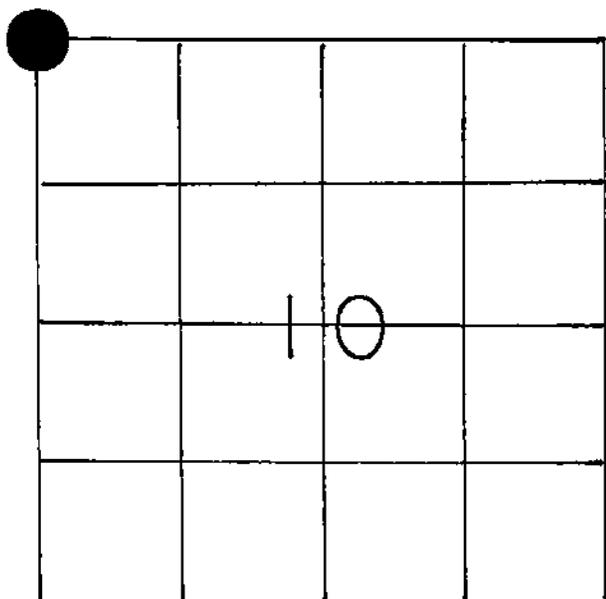

LOCATION OF LANDMARK

CREW: WILLIAM C. JUNG
PETER F. FOLLANSBEE
10-30-1987

WISCONSIN COORDINATE SYSTEM

North 689,032.820 (as per D.O.T.)

East 1,681,029.102

Theta Angle

Horiz. Order

Vert. Order

TYPE OF LANDMARK

CHISELED "X" IN CONC. GUTTER (RESET) **

BEARINGS ARE REFERENCED TO

True (as per Hofmeister survey)

** Note: 12/15/87
Bill Woodman, R.L.S., from the City Engineer's Office offsetted this cross and set a Berntsen top in concrete at this corner on 12/4/87.

Describe any record evidence, monument evidence, testimonial evidence or any other material evidence you considered and whether the monument was found or restored through acceptance of an obliterated evidence location.


Greg Hofmeister set a chiselled cross at this corner in 1980. This point was used in later surveys. This point was offsetted by the D.O.T. and then destroyed. The D.O.T. then set a railroad spike at the corner two years later but this point was also destroyed during construction. Using the D.O.T. reference points to the East and West, I reset the corner with a chiselled cross.

Describe or show any material discrepancy between the location of the restored corner and that of the corner previously restored or reestablished.

NONE KNOWN


RECORD OF DURABLE WITNESS MONUMENTS

NO	DESCRIPTION	BEARING	DISTANCE
1	EXISTING P.K. NAIL IN BITUMINOUS ISLAND	WEST ±	182.57 FT.
2	EXISTING P.K. NAIL IN BITUMINOUS ISLAND	WEST ±	117.83 FT.
3	EX. P.K. NAIL IN COULEE GOLF BOWL PARK. LOT	EAST ±	339.46 FT.
4	EX. P.K. NAIL IN COULEE GOLF BOWL PARK. LOT	EAST ±	440.99 FT.

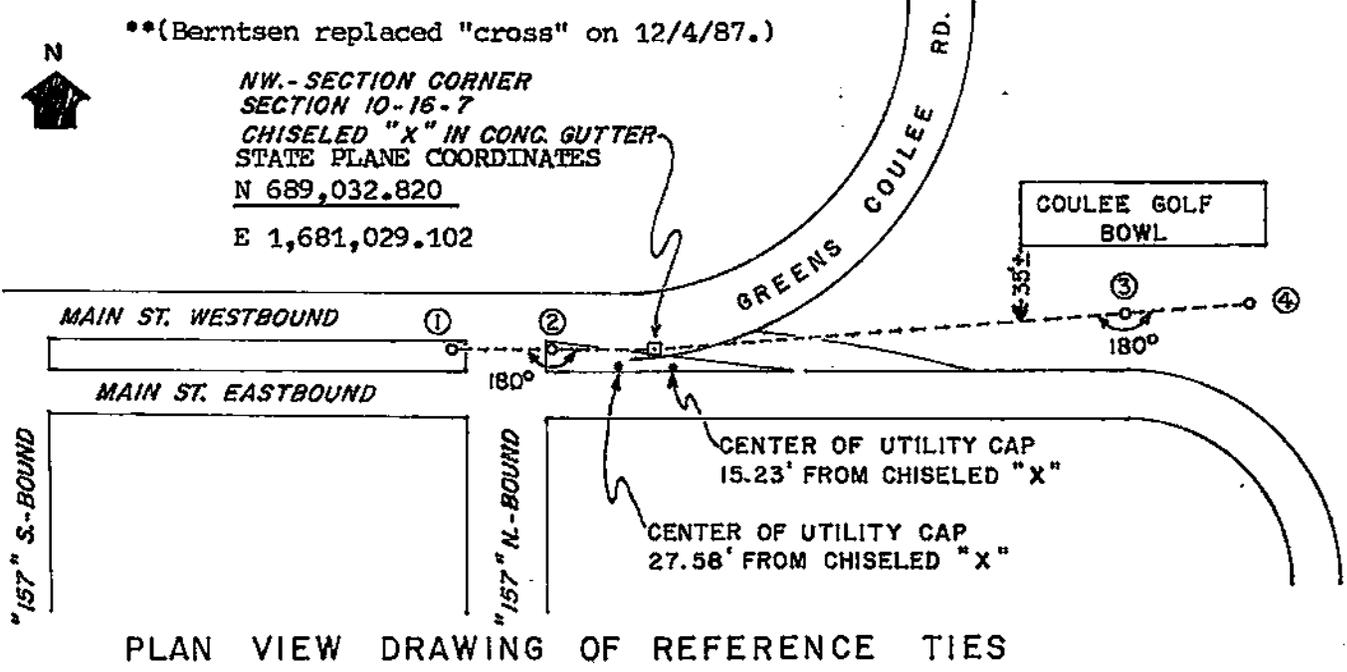

MAP SHOWING DISTANCE AND DIRECTION TO OTHER PUBLIC LAND SURVEY CORNERS USED FOR REESTABLISHING THE CORNER

(not to scale)

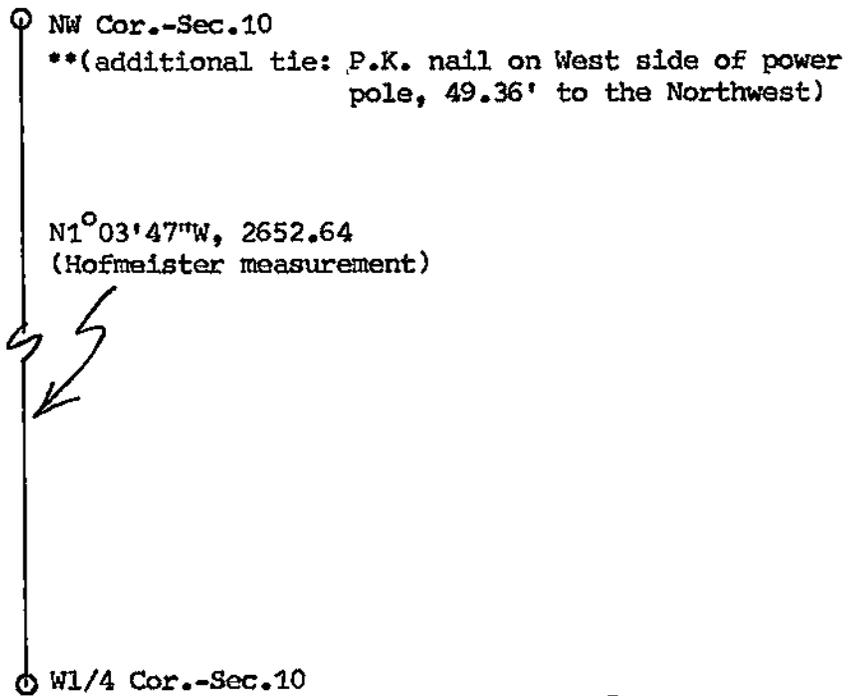

I, WILLIAM C. JUNG
 HEREBY CERTIFY THAT THE CORNER LOCATION SHOWN ON THIS RECORD
 WAS DETERMINED BY ME OR UNDER MY DIRECTION AND CONTROL AND
 THAT THIS U. S. PUBLIC LAND SURVEY MONUMENT RECORD IS CORRECT
 AND COMPLETE TO THE BEST OF MY KNOWLEDGE AND BELIEF.


William C. Jung Deputy County Surveyor, December 15, 1987
 Signature Date



DESIGN/FINAL COMPUTATIONS
E.D.408 7-79

Bill Woodman

State of Wisconsin / Department of Transportation

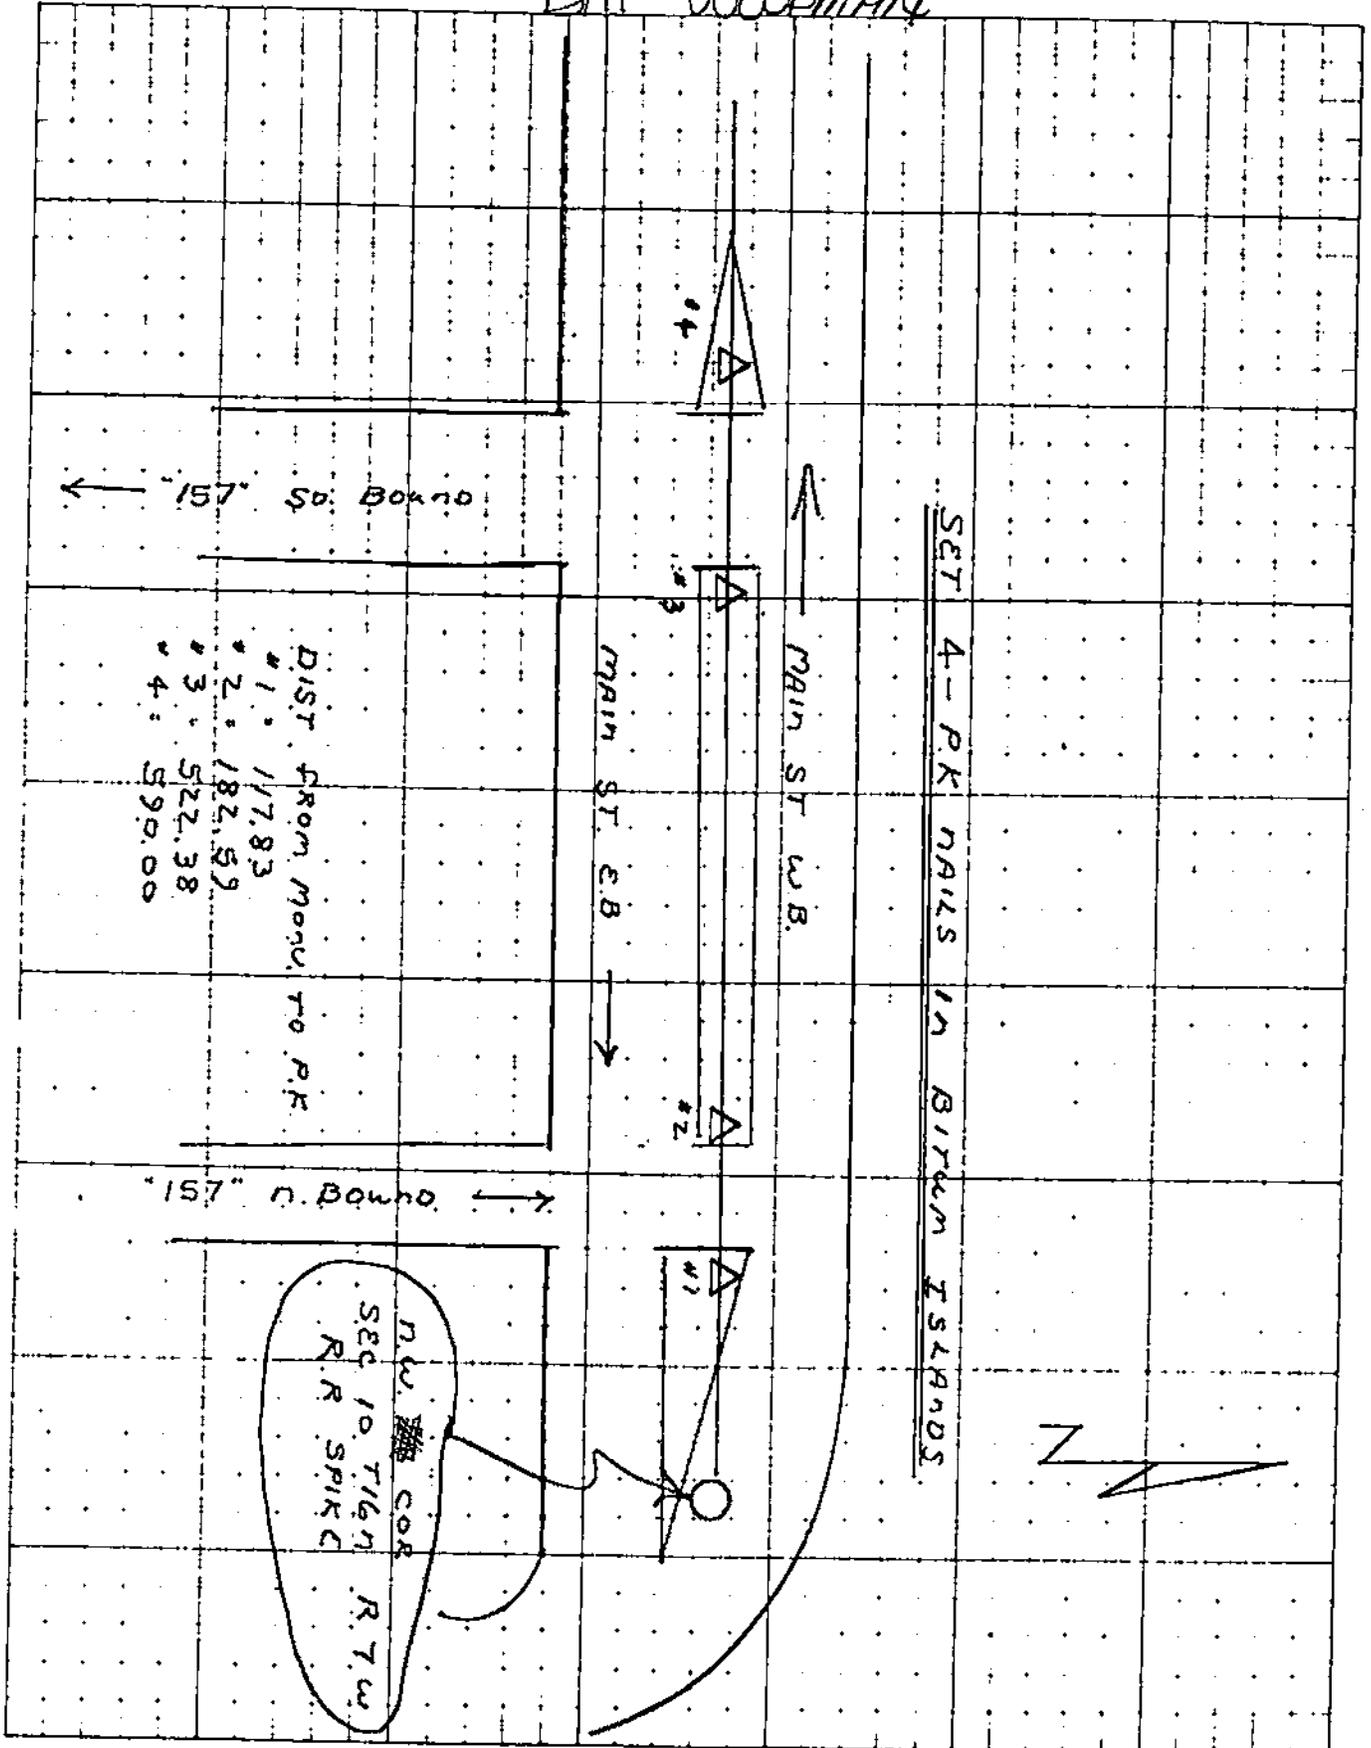

DIST. FROM MONU. TO P.K.
#1: 177.83
#2: 182.59
#3: 522.38
#4: 590.00


NEW COR
SEC 10 T16N
R.R. SPIKE
R.7W

Project/Structure No.	Hwy. No.	County	Computations by <i>MW</i>	Date 9-18-86
Name of Road ONALASKA - S.T.H. 93			Checked by	Date
Title/Item MONU. PRESERVATION - ONALASKA			Sheet	of


FIELD SURVEY NOTES
PRESERVATION OF LANDMARKS
 (Pursuant to Section 59.635(7) Wisconsin Statutes)

State Highway Commission of Wisconsin
 Form E-D-707-85


COUNTY LA CROSSE		
TOWN ONALASKA		
HIGHWAY S.T.H. 157 & C.T.H. "OS"		
SECTION 10	TOWNSHIP T 16 N	RANGE R 7 W
TYPE OF LANDMARK THIS "X" TOP CONC. BOX CULV. HEAD WALL. SET BY G. HOFMEISTER 1980		

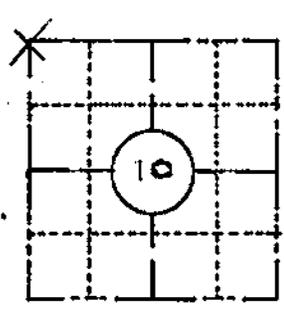

LOCATION SKETCH
 (Location of landmark indicated by "x")

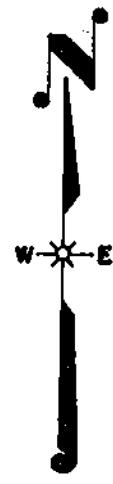

This space for copy of field notes or ties to the above described landmarks

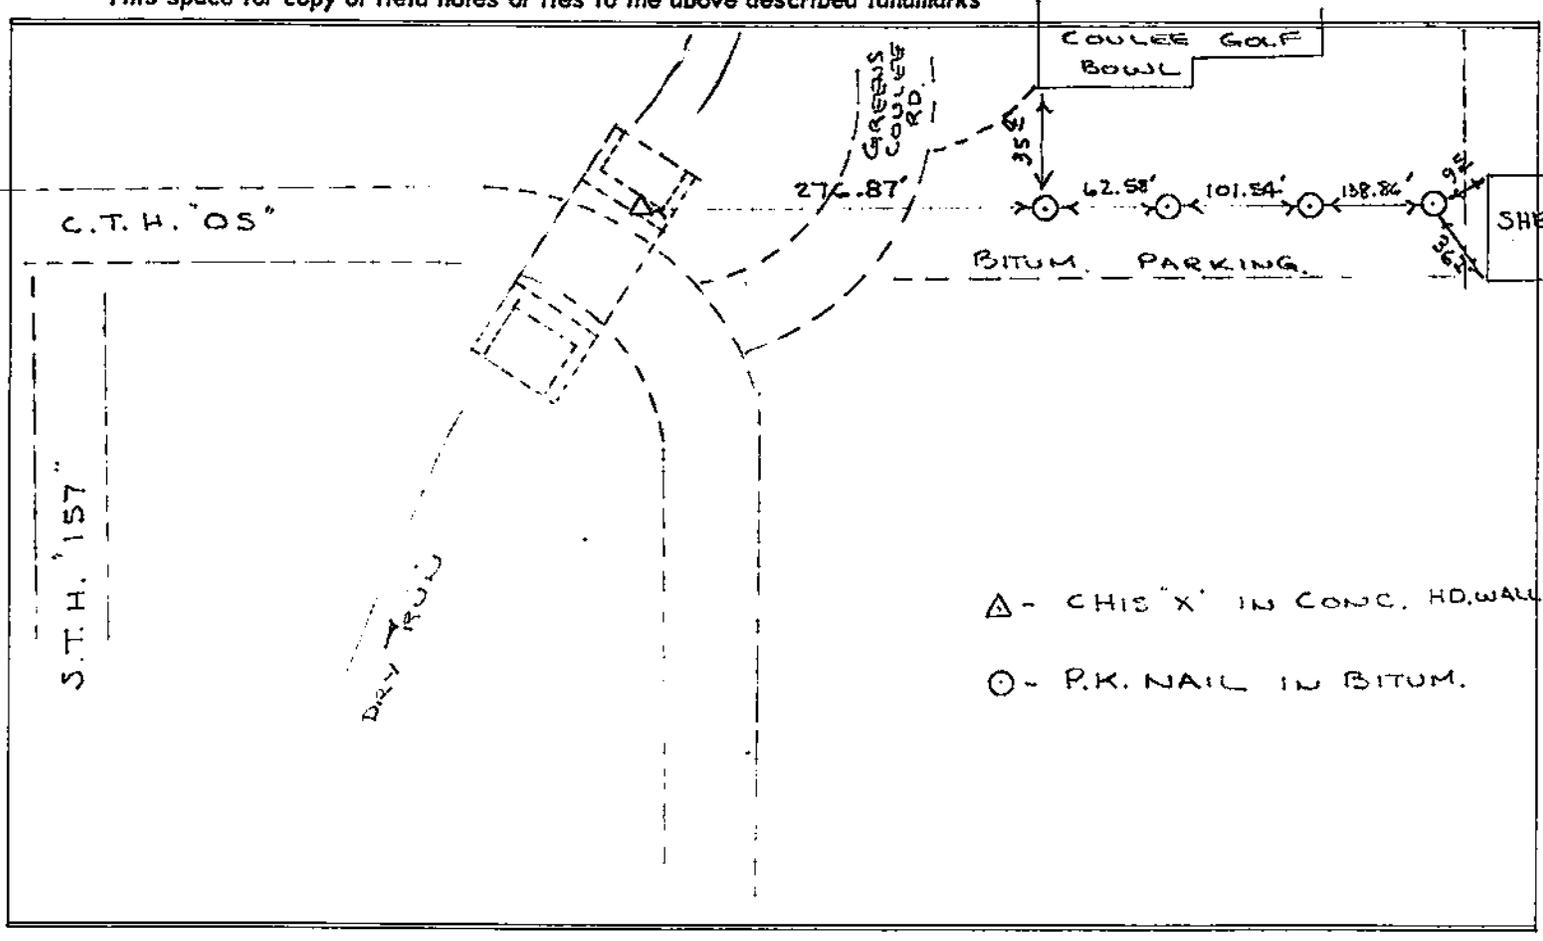

△ - THIS "X" IN CONC. HD. WALL.
 ○ - P.K. NAIL IN BITUM.

FILED UNDER PROJECT NUMBER 1070-04-74		
SHC DISTRICT OFFICE NUMBER # 5	CITY LACROSSE	COUNTY LACROSSE
LOCATED OR ESTABLISHED BY (PERPETUATED) NAME <u>DERALD E. KADING #1064</u> TITLE <u>SURVEY COORDINATOR</u> DATE <u>7-26-84</u>		

COUNTY CLERK'S OFFICE COUNTY OF WISCONSIN } 58	
DATE RECEIVED FOR RECORD	DATE COPY SENT TO COUNTY SURVEYOR
SIGNATURE OF COUNTY CLERK	