


21607040020

U. S. PUBLIC LAND SURVEY MONUMENT RECORD

SECTION 4 T 16 N, R 7 W, ~~TOWN OF~~ CITY OF ONALASKA

LA CROSSE COUNTY

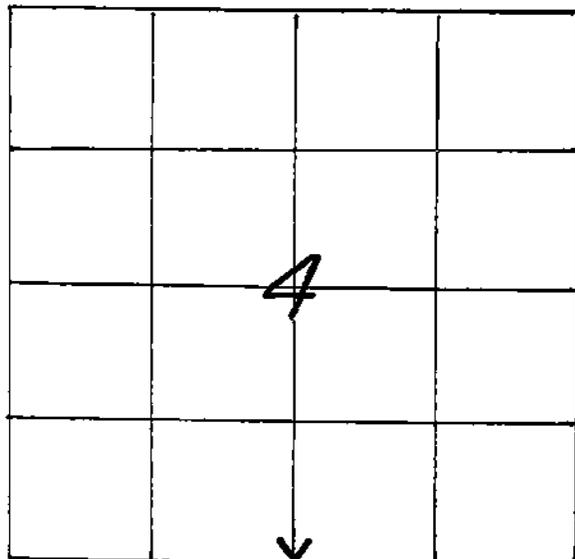

LOCATION OF LANDMARK

CREW: WILLIAM G. JUNG
 PETER F. FOLLANSBEE
 DATE: 6/10/2008

WISCONSIN COORDINATE SYSTEM

North 689,140.115

East 1,646,844.398

Theta Angle

Horiz. Order

Vert. Order

DATUM: 1983('91)

TYPE OF LANDMARK

COMPUTED LOCATION WITH TIES.

BEARINGS ARE REFERENCED TO

GRID NORTH AS PER SECTION DATA.

Describe any record evidence, monument evidence, testimonial evidence or any other material evidence you considered and whether the monument was found or restored through acceptance of an obliterated evidence location.


Woodman's P.K. nail from 1988 was knocked out by construction work. This is a very busy intersection, and as such I did not remonument the corner but instead set up tie points around it that can be measured into for corner computation purposes.

Describe or show any material discrepancy between the location of the restored corner and that of the corner previously restored or reestablished.

NONE KNOWN.

U. S. PUBLIC LAND SURVEY MONUMENT RECORD

SECTION 9 T 16 N, R 7 W, ^{CITY} ~~TOWN~~- OF Onalaska
LA CROSSE COUNTY

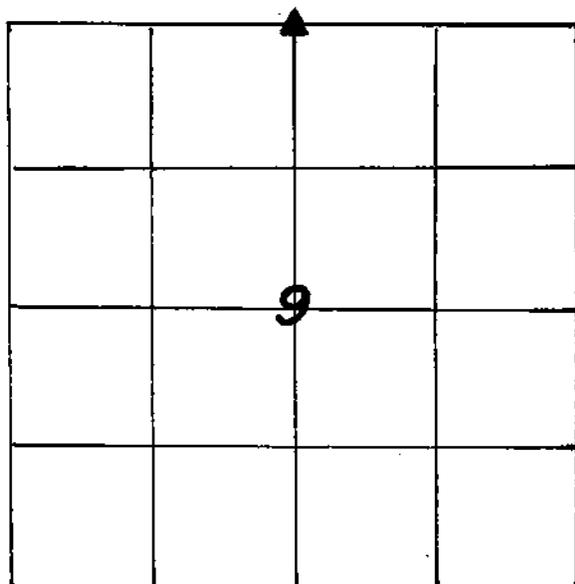

LOCATION OF LANDMARK

Crew: William Woodman - Crew Chief
William Jung
Peter Follansbee

Date: April 6, 1988

Describe any record evidence, monument evidence, testimonial evidence or any other material evidence you considered and whether the monument was found or restored through acceptance of an obliterated evidence location.

This corner, originally, was a stone, which was obliterated. Currently it shows up as a tie on numerous plats and other surveys. Greg Hofmeister, on a C.S.M. for R.B. Schaefer, calls for a broken PK. Nail (1982). Witness testimony from various surveyors, stated that there was a mark on the sewer manhole with a 1" iron pipe 33' south. These were obliterated during reconstruction of the Sand Lake RD.-Main ST. intersection. I reestablished the corner using the ties from the plats and surveys that showed the corner. I set a PK. nail on the north edge of the sanitary manhole on C-C Sand Lake RD.-Main ST., as the best available evidence of the original government corner location.


Describe or show any material discrepancy between the location of the restored corner and that of the corner previously restored or reestablished.

None known.


WISCONSIN COORDINATE SYSTEM
North
East
Theta Angle
Horiz. Order
Vert. Order
TYPE OF LANDMARK
PK. NAIL
BEARINGS ARE REFERENCED TO
The North line of the NE 1/4 of
Section 9, Recorded as S88°28' E

RECORD OF DURABLE WITNESS MONUMENTS

NO	DESCRIPTION	BEARING	DISTANCE
1	Bertsen Monument	S 30° 28' -36" E	40.04'
2	Chisel cross on lane divider	S 28° 18' -57" W	44.35'
3	Bertsen Monument	N51° 35' -03" W	58.63'
4	Chisel cross on lane divider	N09° 06' -15" W	39.34'

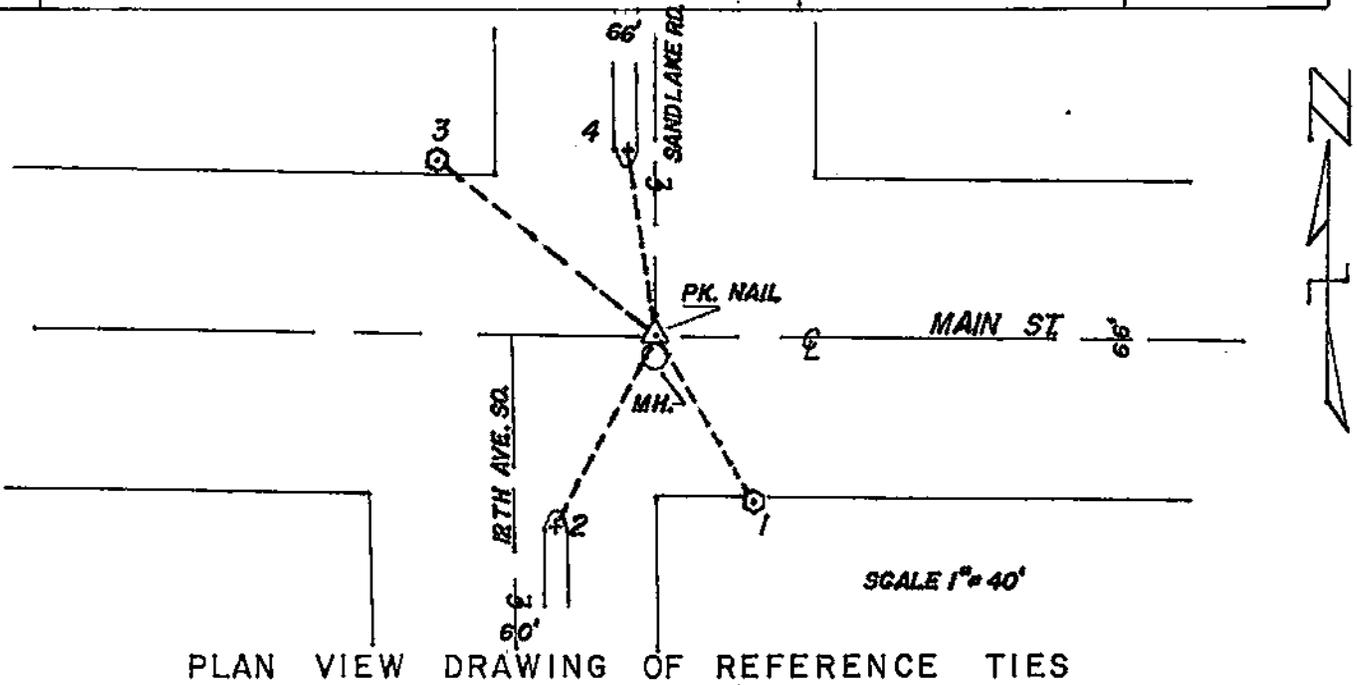


MAP SHOWING DISTANCE AND DIRECTION TO OTHER PUBLIC LAND SURVEY CORNERS USED FOR REESTABLISHING THE CORNER


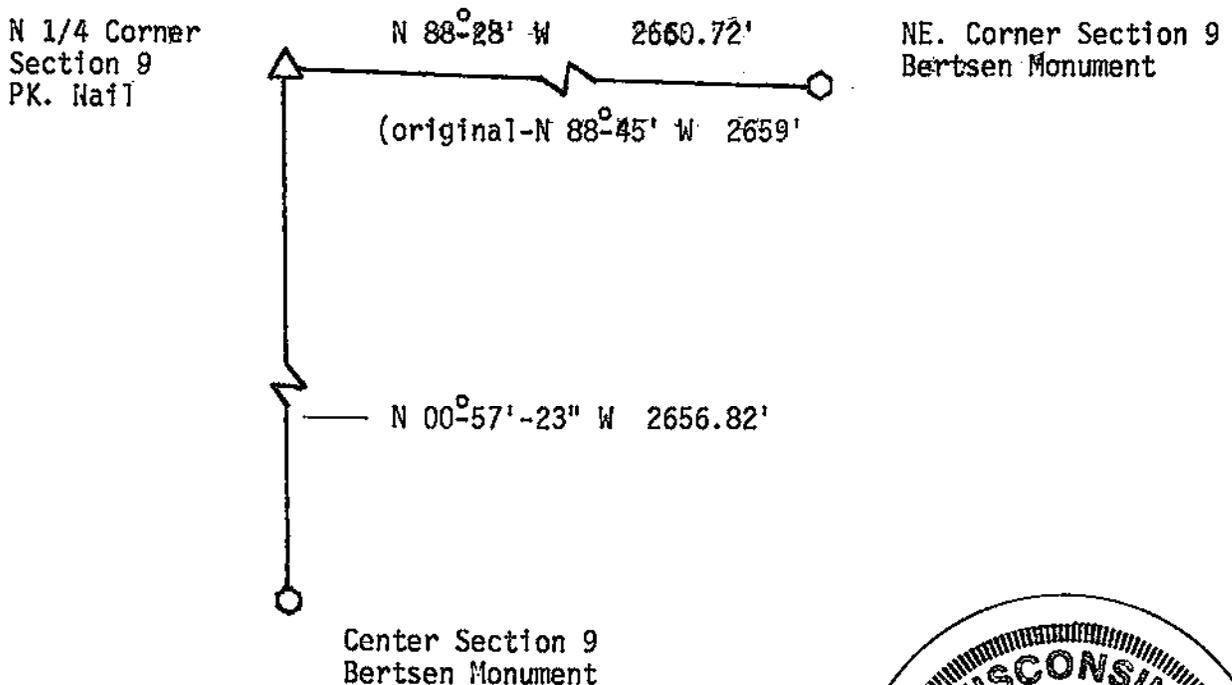


I, William S. Woodman R.L.S.-1796
 HEREBY CERTIFY THAT THE CORNER LOCATION SHOWN ON THIS RECORD
 WAS DETERMINED BY ME OR UNDER MY DIRECTION AND CONTROL AND
 THAT THIS U. S. PUBLIC LAND SURVEY MONUMENT RECORD IS CORRECT
 AND COMPLETE TO THE BEST OF MY KNOWLEDGE AND BELIEF.

William S. Woodman 4/15/88
 Signature Date

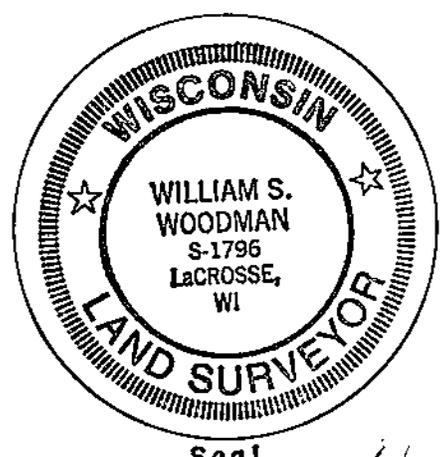

Seal

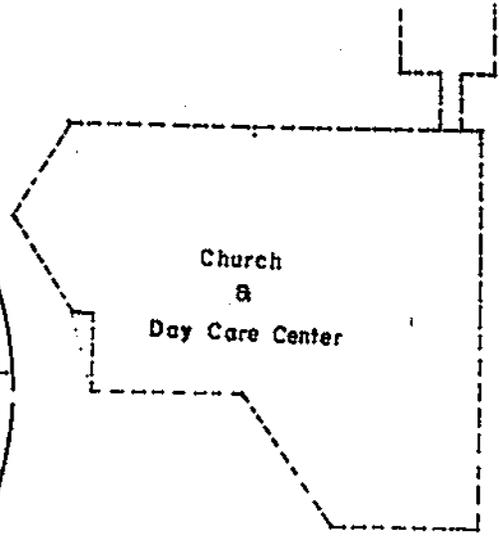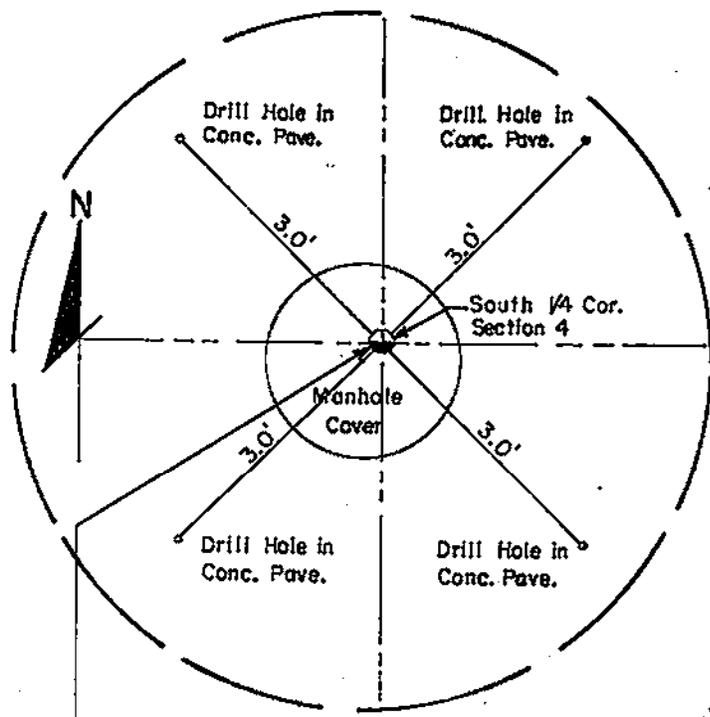

DETAIL OF SOUTH 1/4 COR. SEC. 4, T16N, R7W
Scale: 1" = 2'

