


21607042000

U. S. PUBLIC LAND SURVEY MONUMENT RECORD

SECTION 3 T 16 N, R 7 W, TOWN OF ONALASKA
 LA CROSSE COUNTY

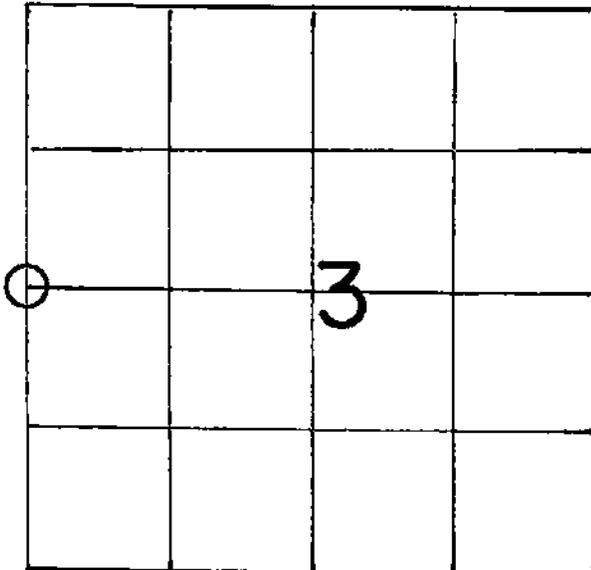

LOCATION OF LANDMARK

Crew: WILLIAM C. JUNG
 PETER F. FOLLANSBEE

Date: 7/21/1993

Describe any record evidence, monument evidence, testimonial evidence or any other material evidence you considered and whether the monument was found or restored through acceptance of an obliterated evidence location.

I found an iron pipe at the corner which I accepted as the best available evidence of the original government survey position. This pipe had been used as the corner in many previous surveys.

Describe or show any material discrepancy between the location of the restored corner and that of the corner previously restored or reestablished.

None Known

WISCONSIN COORDINATE SYSTEM

North

East

Theta Angle

Horiz. Order

Vert. Order

TYPE OF LANDMARK

Existing 1 1/4" Iron Pipe

BEARINGS ARE REFERENCED TO

