


21607050000

U. S. PUBLIC LAND SURVEY MONUMENT RECORD

SECTION 9 T 16 N, R 7 W, ~~TOWN~~ OF CITY OF ONALASKA
LA CROSSE COUNTY

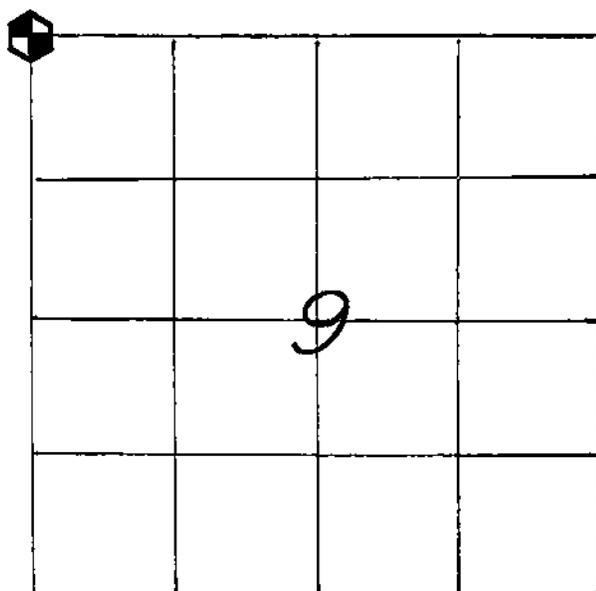

LOCATION OF LANDMARK

CREW: *WILLIAM C. JUNG*
PETER F. FOLLANSBEE
DATE: *8/18/2000*

WISCONSIN COORDINATE SYSTEM
North
East
Theta Angle
Horiz. Order
Vert. Order
TYPE OF LANDMARK
<i>BRASS CAP LUNDE MARKER.</i>
BEARINGS ARE REFERENCED TO

Describe any record evidence, monument evidence, testimonial evidence or any other material evidence you considered and whether the monument was found or restored through acceptance of an obliterated evidence location.


We reset this corner after it was lost to construction during the building of the new city hall. The corner was monumented with a Lunde marker.

Describe or show any material discrepancy between the location of the restored corner and that of the corner previously restored or reestablished.


NONE KNOWN.

RECORD OF DURABLE WITNESS MONUMENTS

NO	DESCRIPTION	BEARING	DISTANCE
1	CENTER OF EXISTING MANHOLE IN THE DRIVEWAY	SOUTHERLY ±	16.76 FT.
2	SET A NAIL AT THE BACK OF CURB	N. EASTERLY ±	68.00 FT.
3	SET A NAIL AT THE BACK OF CURB	N. EASTERLY ±	46.00 FT.
4	EXISTING 5/8" IRON PIPE IN A LAWN	EASTERLY ±	60.16 FT.

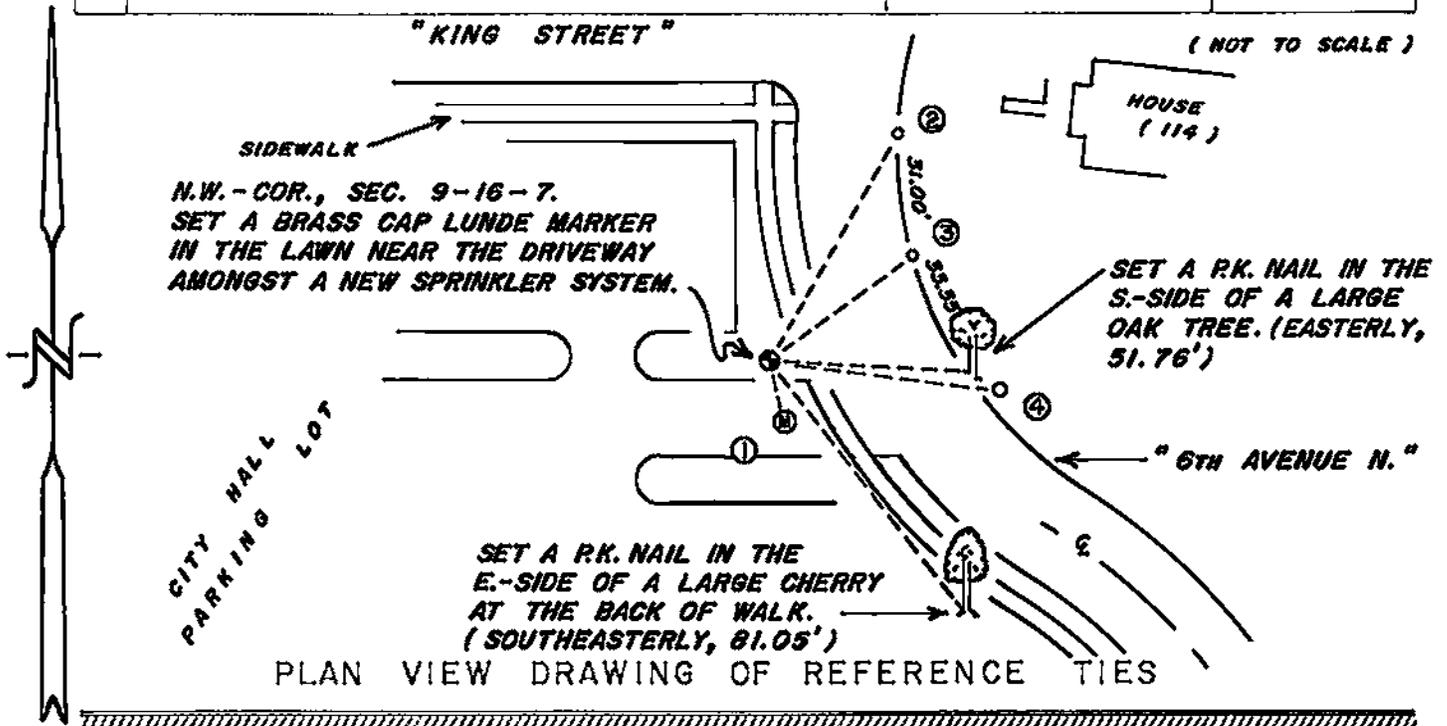

MAP SHOWING DISTANCE AND DIRECTION TO OTHER PUBLIC LAND SURVEY CORNERS USED FOR REESTABLISHING THE CORNER

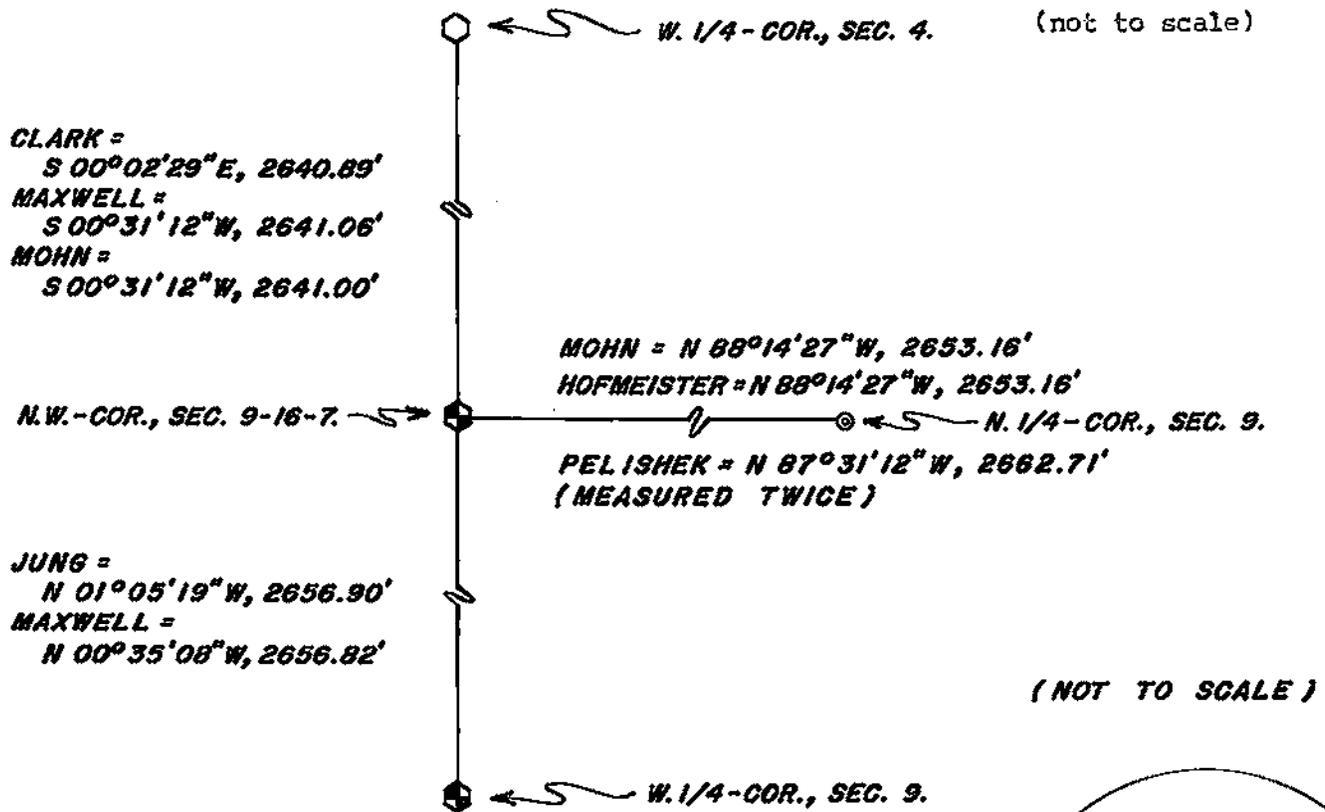

I, WILLIAM C. JUNG, COUNTY SURVEYOR
 HEREBY CERTIFY THAT THE CORNER LOCATION SHOWN ON THIS RECORD WAS DETERMINED BY ME OR UNDER MY DIRECTION AND CONTROL AND THAT THIS U. S. PUBLIC LAND SURVEY MONUMENT RECORD IS CORRECT AND COMPLETE TO THE BEST OF MY KNOWLEDGE AND BELIEF.

William C. Jung 5/3/01
 Signature Date




Seal

U. S. PUBLIC LAND SURVEY MONUMENT RECORD

SECTION 9 T 16 N, R 7 W, CITY Onalaska TOWN OF Onalaska

LA CROSSE COUNTY

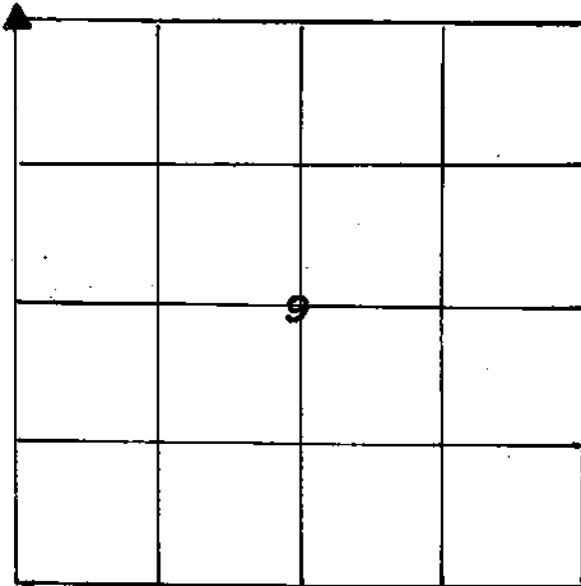

LOCATION OF LANDMARK

Crew: Roger R. Mohn - Crew Chief
Joseph J. Gavin

Date: May 20, 1988

Describe any record evidence, monument evidence, testimonial evidence or any other material evidence you considered and whether the monument was found or restored through acceptance of an obliterated evidence location.

This corner, originally, was marked with a stone as per plats of additions to Onalaska dated in the late 1800's and early 1900's. I could not find the stone. I did find a 1"Ø iron pipe at a location that was consistent with a survey by M.W. Vance in 1957 who reportedly had found the stone. This 1"Ø iron pipe was used as the section corner location by Gregory J. Hofmeister in a survey that he completed in 1982. I accepted the 1"Ø iron pipe as the section corner location.

Describe or show any material discrepancy between the location of the restored corner and that of the corner previously restored or reestablished.

none

WISCONSIN COORDINATE SYSTEM

North

East

Theta Angle

Horiz. Order

Vert. Order

TYPE OF LANDMARK

1"Ø IRON PIPE

BEARINGS ARE REFERENCED TO
The east line of Eleventh Ave.
So. as bearing N 00°-22'-33" E.

