


21607060000

U. S. PUBLIC LAND SURVEY MONUMENT RECORD

SECTION 7 T 16 N, R 7 W, TOWN OF CAMPBELL AND
 LA CROSSE COUNTY CITY OF LACROSSE.

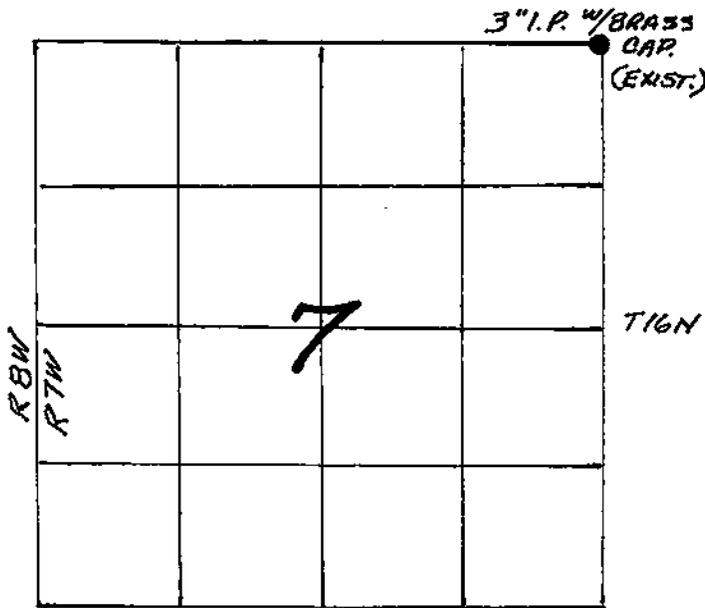

LOCATION OF LANDMARK

| |
|--|
| WISCONSIN COORDINATE SYSTEM |
| North |
| East |
| Theta Angle |
| Horiz. Order |
| Vert. Order |
| TYPE OF LANDMARK SET BY: U.S.C.E. 3" IRON PIPE W/BRASS CAP. (EXIST.) |
| BEARINGS ARE REFERENCED TO SEE → ENCLOSED SURVEY OF SECTION 7. |

Describe any record evidence, monument evidence, testimonial evidence or any other material evidence you considered and whether the monument was found or restored through acceptance of an obliterated evidence location.


SHOWN ON U.S.C.E. FLOWAGE MAPS.

Describe or show any material discrepancy between the location of the restored corner and that of the corner previously restored or reestablished.

N/A.

RECORD OF DURABLE WITNESS MONUMENTS

| NO | DESCRIPTION | BEARING | DISTANCE |
|----|-----------------|---------|----------|
| 1 | 3/4" IRON PIPE. | | 44.02' |
| 2 | - SAME - | | 55.71' |
| 3 | - SAME - | | 62.82' |
| 4 | - SAME - | | 52.18' |

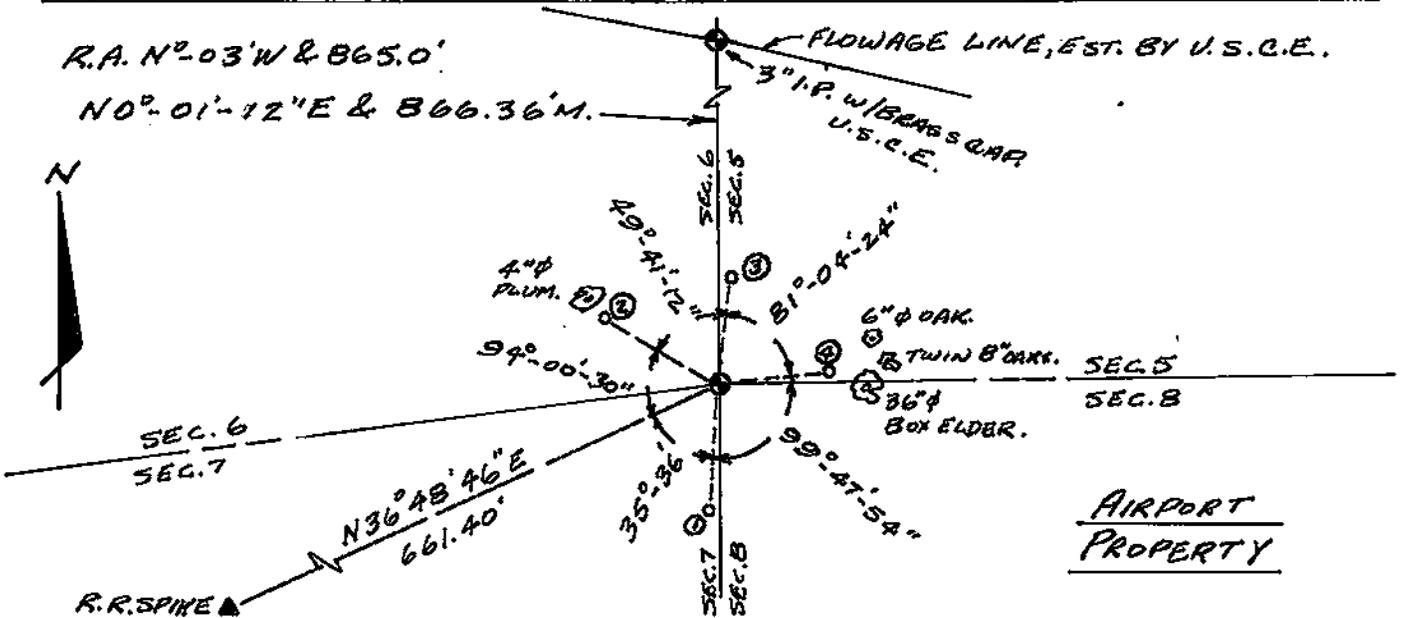

PLAN VIEW DRAWING OF REFERENCE TIES

MAP SHOWING DISTANCE AND DIRECTION TO OTHER PUBLIC LAND SURVEY CORNERS USED FOR REESTABLISHING THE CORNER

SEE → ENCLOSED SURVEY OF SECTION 7, T16N, R1W, 4TH P.M., CITY OF LA CROSSE, LA CROSSE COUNTY, WISCONSIN.

I, WILBUR L. CLARK, ENGR. DEPT. CITY OF LA CROSSE, HEREBY CERTIFY THAT THE CORNER LOCATION SHOWN ON THIS RECORD WAS DETERMINED BY ME OR UNDER MY DIRECTION AND CONTROL AND THAT THIS U. S. PUBLIC LAND SURVEY MONUMENT RECORD IS CORRECT AND COMPLETE TO THE BEST OF MY KNOWLEDGE AND BELIEF.

Wilbur L. Clark. 1-22-1987.
Signature Date



Seal

* CORNER WAS EXISTING.