


21607080000

U. S. PUBLIC LAND SURVEY MONUMENT RECORD

SECTION 8 T 16 N, R 7 W, CITY OF ONALASKA

LA CROSSE COUNTY

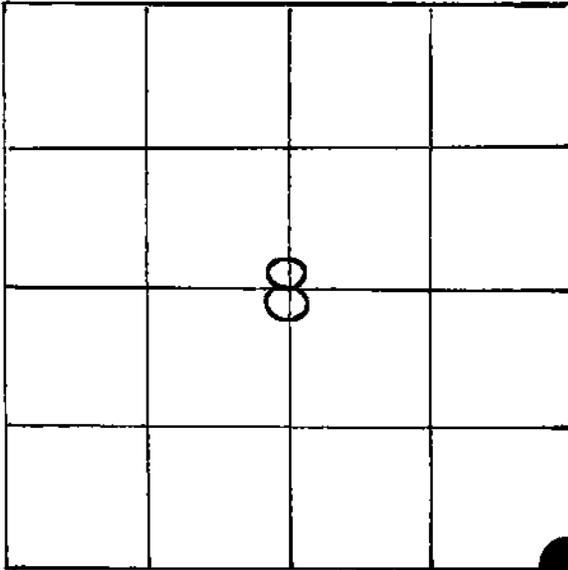

LOCATION OF LANDMARK

WISCONSIN COORDINATE SYSTEM

North

East

Theta Angle

Horiz. Order

Vert. Order

TYPE OF LANDMARK

SET BERNTSEN TOP IN EX. IRON PIPE (BURIED)

BEARINGS ARE REFERENCED TO

Assumed

CREW: WILLIAM C. JUNG
 PETER F. FOLLANSBEE

10-30-1987

Describe any record evidence, monument evidence, testimonial evidence or any other material evidence you considered and whether the monument was found or restored through acceptance of an obliterated evidence location.


Dick Berg found a 1½" iron pipe at this corner in 1981. I also found this pipe and accepted it as the best available evidence of the original government corner position. I set a Berntsen top in the iron pipe.

Describe or show any material discrepancy between the location of the restored corner and that of the corner previously restored or reestablished.

NONE KNOWN


RECORD OF DURABLE WITNESS MONUMENTS

NO	DESCRIPTION	BEARING	DISTANCE
1	EXISTING NAIL ON TOP OF GUARD POST	NORTHEAST \pm	10.53FT.
2	EXISTING NAIL IN WEST SIDE OF POWER POLE	SOUTH \pm	16.85 FT.
3	CENTER OF STORM SEWER MANHOLE	SOUTHEAST \pm	33.38 FT.
4	CENTER OF STORM SEWER MANHOLE	SOUTHEASE \pm	52.61 FT.

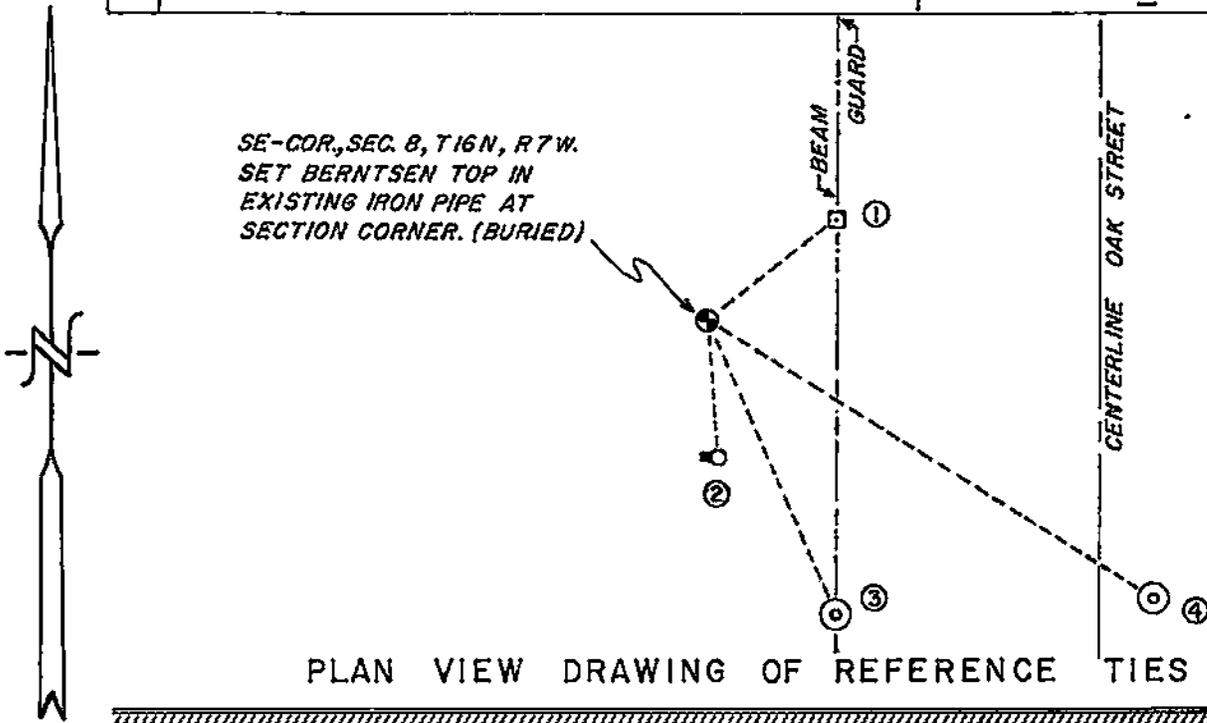

MAP SHOWING DISTANCE AND DIRECTION TO OTHER PUBLIC LAND SURVEY CORNERS USED FOR REESTABLISHING THE CORNER


(not to scale)

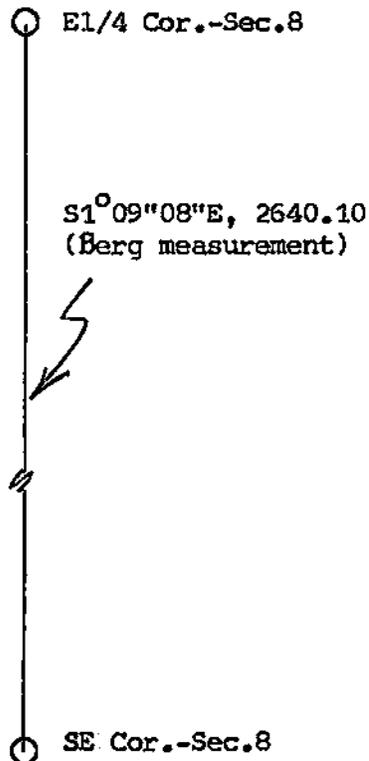

WILLIAM C. JUNG

I, _____
HEREBY CERTIFY THAT THE CORNER LOCATION SHOWN ON THIS RECORD
WAS DETERMINED BY ME OR UNDER MY DIRECTION AND CONTROL AND
THAT THIS U. S. PUBLIC LAND SURVEY MONUMENT RECORD IS CORRECT
AND COMPLETE TO THE BEST OF MY KNOWLEDGE AND BELIEF.

William C. Jung Deputy County Surveyor, December 15, 1987
Signature Date

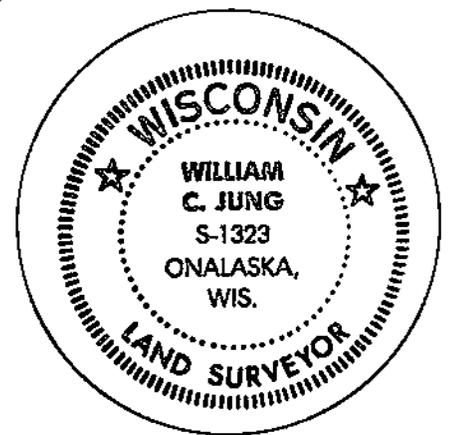

Seal