


21607082000

U. S. PUBLIC LAND SURVEY MONUMENT RECORD

SECTION 9 T 16 N, R 7 W, ~~TOWN~~ OF CITY OF ONALASKA
 LA CROSSE COUNTY

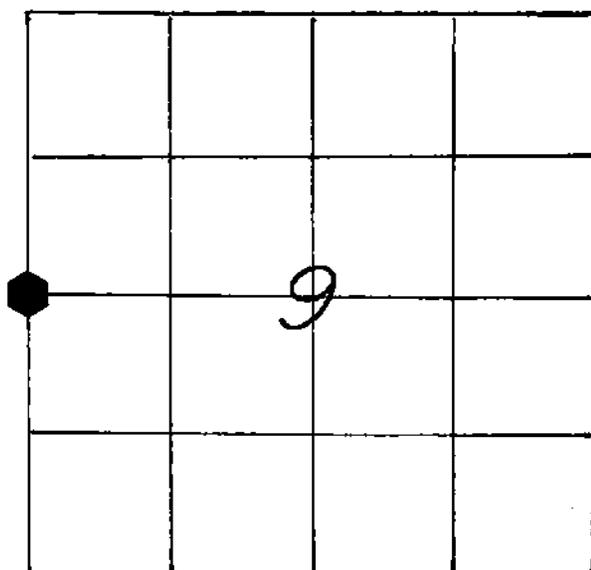

LOCATION OF LANDMARK

Crew: WILLIAM C. JUNG
 PETER F. FOLLANSBEE
 Date: 8/08/1996

WISCONSIN COORDINATE SYSTEM

North

East

Theta Angle

Horiz. Order

Vert. Order

TYPE OF LANDMARK

Brass cap Lunde marker.

BEARINGS ARE REFERENCED TO

Describe any record evidence, monument evidence, testimonial evidence or any other material evidence you considered and whether the monument was found or restored through acceptance of an obliterated evidence location.

In 1883, Middlebrook, County Surveyor, found an original bearing tree and from it set a "lime stone" at the corner with glass under the stone. In 1981 Ray Pelishek set a Berntsen marker in concrete on top of the stone. On May 7, 1996, Peter Follansbee and Mike Weibel were present when this corner was excavated and destroyed because of road construction. They found a Berntsen over a stone over glass and took photos. We set a Lunde at the old corner location on 8/8/96.
 Describe or show any material discrepancy between the location of the restored corner and that of the corner previously restored or reestablished.

None Known.

RECORD OF LAND CORNER PERPETUATION

No. _____

STATE OF WISCONSIN

County of La Crosse } ss.

I, Ray Pelishek, hereby certify that the information shown hereon correctly describes the original corner, resurvey information, evidence found, type of monument found or placed, and witness monuments and accessories used to perpetuate the location of the original or established corner.

Dated this 3rd day of November, 19 81

at La Crosse, Wisconsin.


Ray P. Pelishek
La Crosse County Surveyor
Title

COUNTY La Crosse		
TOWN City of Onalaska		
HIGHWAY Wilson St. & Oak St.		
SECTION 8 - 9	TOWNSHIP 16 N	RANGE 7 W
TYPE OF LANDMARK Berntsen set in concrete		

Date of Survey October 15, 1981


Drafted by Michael A. Weibel

Date November 3, 1981

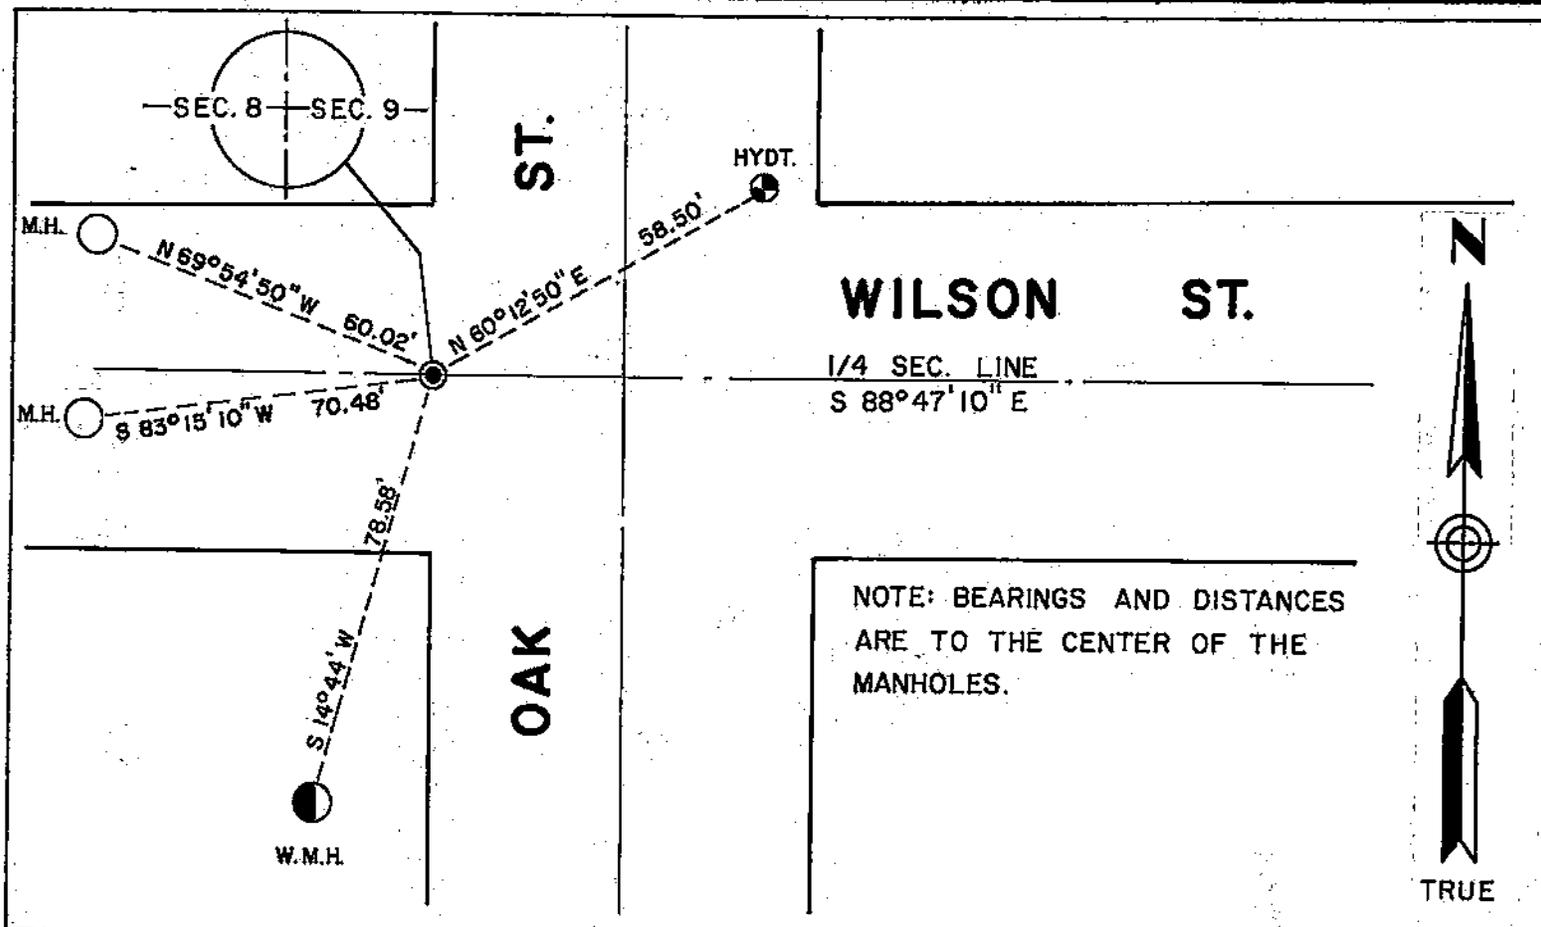

NOTE: BEARINGS AND DISTANCES ARE TO THE CENTER OF THE MANHOLES.

WISCONSIN COORDINATE SYSTEM	
North	Zone
East	
Elevation	Theta Angle
Vertical control order	
Horizontal control order	

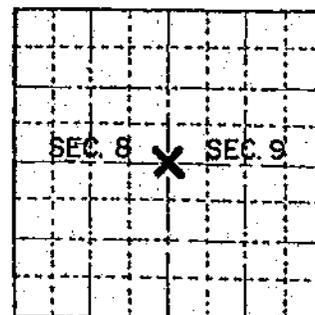

REMARKS: Located sq. limestone monument. Set Berntsen cast alum marker in concrete on top of stone.

LOCATION SKETCH
(Location of landmark indicated by "x")

(VOID)