


U. S. PUBLIC LAND SURVEY MONUMENT RECORD

SECTION 9 T 16 N, R 7 W, ~~TOWN~~ OF Onalaska City

LA CROSSE COUNTY

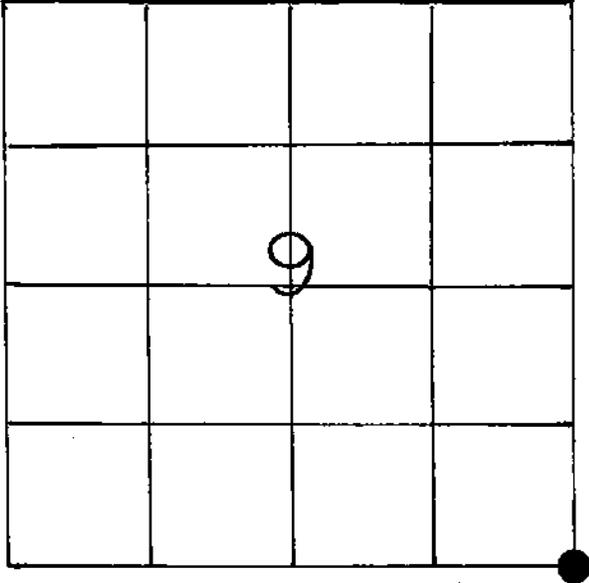

LOCATION OF LANDMARK

|                             |
|-----------------------------|
| WISCONSIN COORDINATE SYSTEM |
| North                       |
| East                        |
| Theta Angle                 |
| Horiz. Order                |
| Vert. Order                 |
| TYPE OF LANDMARK            |
| Berntsen top in concrete    |
| BEARINGS ARE REFERENCED TO  |
| Assumed                     |

Crew: William C. Jung  
 Peter F. Follansbee

Date: March 4, 1991

Describe any record evidence, monument evidence, testimonial evidence or any other material evidence you considered and whether the monument was found or restored through acceptance of an obliterated evidence location.


Because of construction it was necessary to take new ties. The corner is still a Berntsen top in concrete. A witness post with signs is 6" to the West of the corner.

Describe or show any material discrepancy between the location of the restored corner and that of the corner previously restored or reestablished.

None known.

RECORD OF DURABLE WITNESS MONUMENTS

| NO | DESCRIPTION                       | BEARING | DISTANCE |
|----|-----------------------------------|---------|----------|
| 1  | Existing nail in a power pole     | -----   | 35.52    |
| 2  | Center of a manhole cover (sewer) | -----   | 10.23    |
| 3  | " " " " " (water)                 | -----   | 30.31    |
| 4  | " " " " " "                       | -----   | 38.40    |

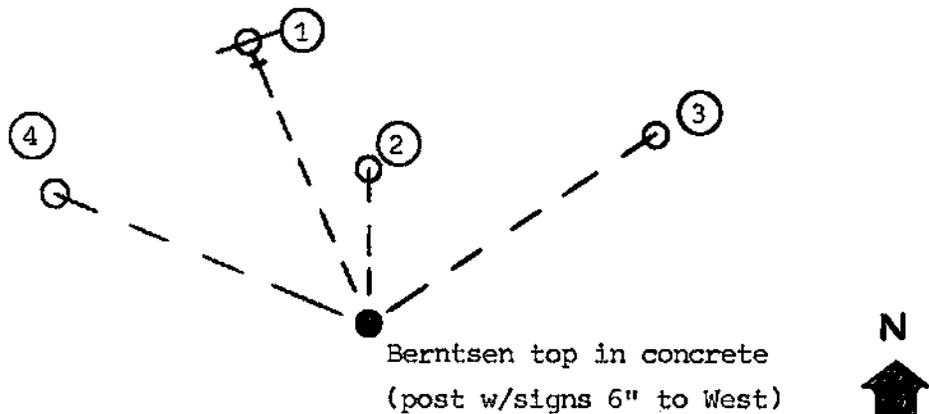


(not to scale)

PLAN VIEW DRAWING OF REFERENCE TIES

MAP SHOWING DISTANCE AND DIRECTION TO OTHER PUBLIC LAND SURVEY CORNERS USED FOR REESTABLISHING THE CORNER

(not to scale)

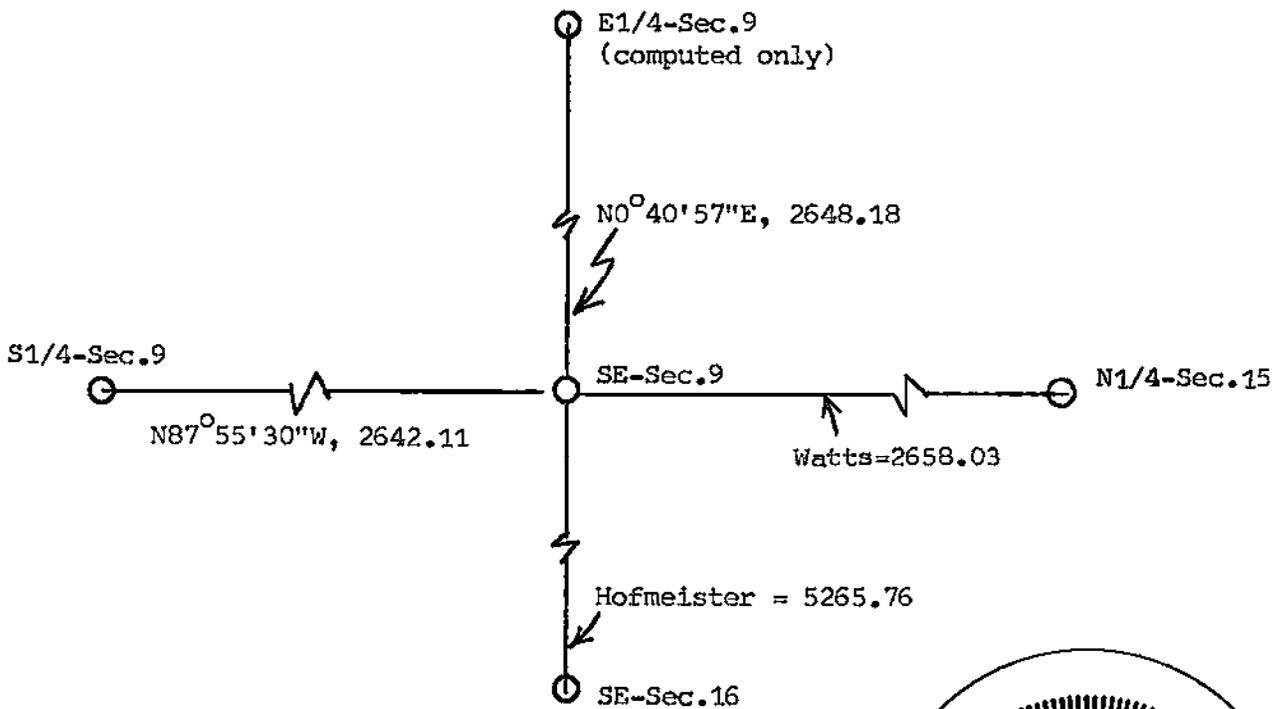

I, William C. Jung, Deputy County Surveyor,  
 HEREBY CERTIFY THAT THE CORNER LOCATION SHOWN ON THIS RECORD  
 WAS DETERMINED BY ME OR UNDER MY DIRECTION AND CONTROL AND  
 THAT THIS U. S. PUBLIC LAND SURVEY MONUMENT RECORD IS CORRECT  
 AND COMPLETE TO THE BEST OF MY KNOWLEDGE AND BELIEF.

William C. Jung December 4, 1991  
 Signature Date




Seal

**U. S. PUBLIC LAND SURVEY MONUMENT RECORD**

SECTION 9 T 16 N, R 7 W, CITY ONALASKA TOWN OF ONALASKA

LA CROSSE COUNTY

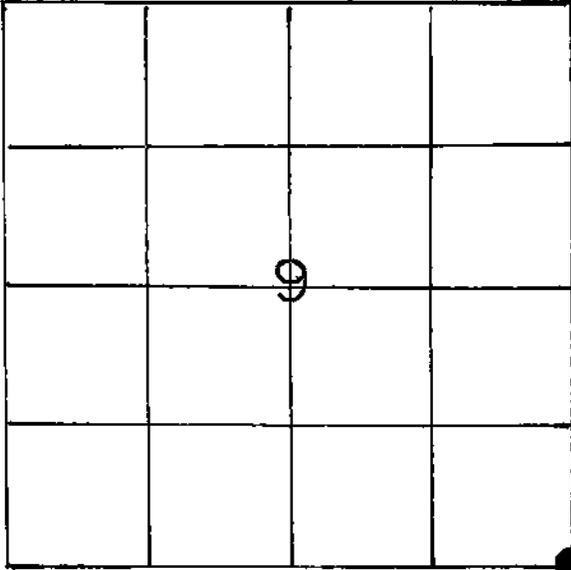

LOCATION OF LANDMARK

|                             |
|-----------------------------|
| WISCONSIN COORDINATE SYSTEM |
| North                       |
| East                        |
| Theta Angle                 |
| Horiz. Order                |
| Vert. Order                 |

TYPE OF LANDMARK P.K. nail offset, 0.08' West & 0.07' North of true cor.

BEARINGS ARE REFERENCED TO

Assumed Berntsen top at the corner

Crew: William Jung  
Perry Dahl  
11/26/85

Revised:  
Crew: Bill Jung  
Bill Woodman and Perry Dahl  
7/1/86

Describe any record evidence, monument evidence, testimonial evidence or any other material evidence you considered and whether the monument was found or restored through acceptance of an obliterated evidence location.

This corner shows up as a tie on numerous surveys. Greg Hofmeister set an iron bar at this corner in 1979. This bar was destroyed during construction. The existing P.K. nail was set by the City of Onalaska Engineering Department. Bill Woodman, from that department, thought that there might be some error in the P.K. and there is. My traversing and calculations indicate that it is 0.08' West and 0.07' North of the true corner. The true corner will be monumented with a permanent marker at a later date.


Describe or show any material discrepancy between the location of the restored corner and that of the corner previously restored or reestablished.

None known.

VOID


RECORD OF DURABLE WITNESS MONUMENTS  
(TO P.K. OFFSET)

| NO | DESCRIPTION                   | BEARING     | DISTANCE |
|----|-------------------------------|-------------|----------|
| 1  | Existing nail in a power pole | N28°11'36"W | 35.44    |
| 2  | Existing pipe, down 5"        | N88°52'36"W | 32.93    |
| 3  |                               |             |          |
| 4  |                               |             |          |

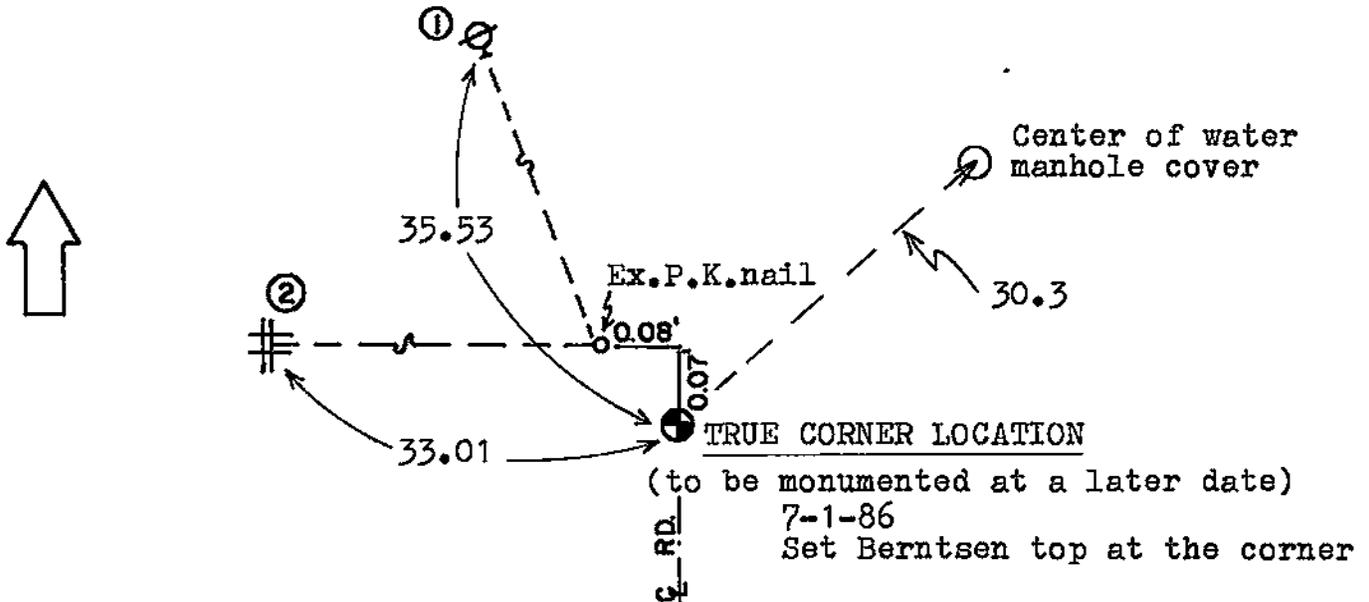

PLAN VIEW DRAWING OF REFERENCE TIES

MAP SHOWING DISTANCE AND DIRECTION TO OTHER PUBLIC LAND SURVEY CORNERS USED FOR REESTABLISHING THE CORNER

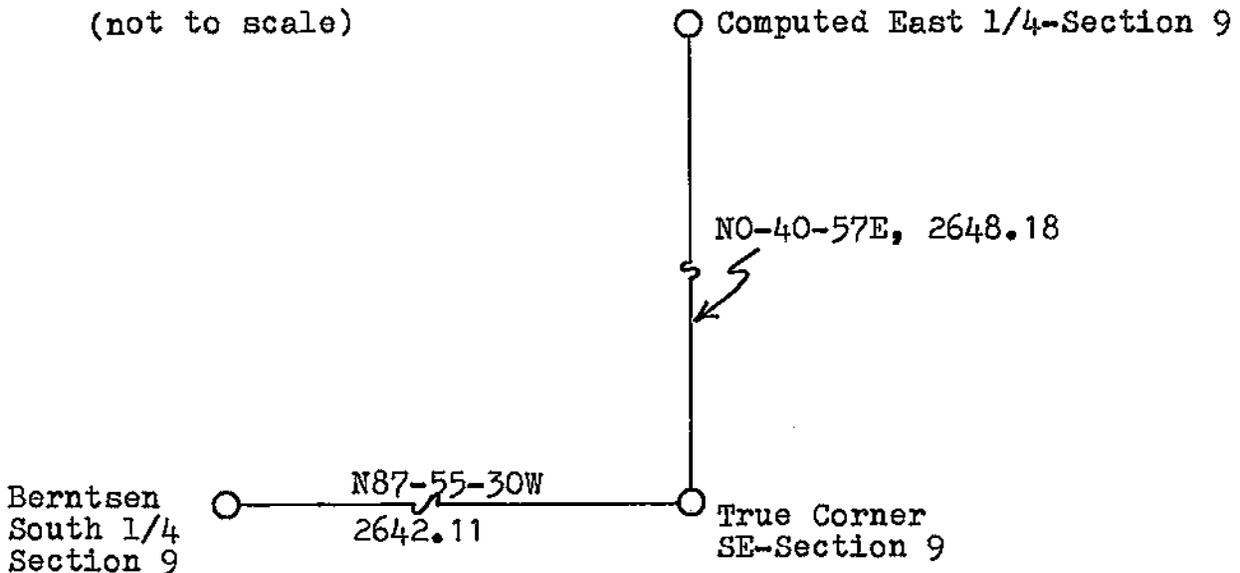

I, William C. Jung, Deputy County Surveyor,  
 HEREBY CERTIFY THAT THE CORNER LOCATION SHOWN ON THIS RECORD  
 WAS DETERMINED BY ME OR UNDER MY DIRECTION AND CONTROL AND  
 THAT THIS U. S. PUBLIC LAND SURVEY MONUMENT RECORD IS CORRECT  
 AND COMPLETE TO THE BEST OF MY KNOWLEDGE AND BELIEF.

*William C. Jung*  
 Signature

1/12/87  
 3/7/86  
 Date



Seal