


21607090020

U. S. PUBLIC LAND SURVEY MONUMENT RECORD

SECTION 9 T 16 N, R 7 W, CITY OF ONALASKA

LA CROSSE COUNTY

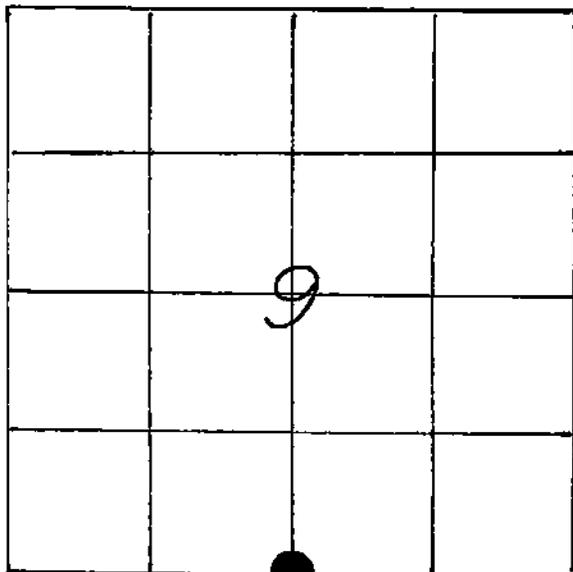

LOCATION OF LANDMARK

DATE: 11-26-85
 CREW: BILL JUNG
 PERRY DAHL

WISCONSIN COORDINATE SYSTEM

North

East

Theta Angle

Horiz. Order

Vert. Order

TYPE OF LANDMARK

BERNTSEN

BEARINGS ARE REFERENCED TO

Assumed

Describe any record evidence, monument evidence, testimonial evidence or any other material evidence you considered and whether the monument was found or restored through acceptance of an obliterated evidence location.

Greg Hofmeister set an iron pipe at this corner in 1979. I found the pipe, removed it, and replaced it with a Berntsen marker. I accepted this monument as the best available evidence of the original government corner position. The corner falls within the bounds of the Interstate R/W as shown on the Interstate maps.

(Brice, the old County Surveyor, set a stone at this corner.)
 I did not find a stone. It was probably destroyed during construction.

Describe or show any material discrepancy between the location of the restored corner and that of the corner previously restored or reestablished.

None known.

