


21607092000

U. S. PUBLIC LAND SURVEY MONUMENT RECORD

SECTION 9 T 16 N, R 7 W, ^{City}~~TOWN~~ OF Onalaska

LA CROSSE COUNTY

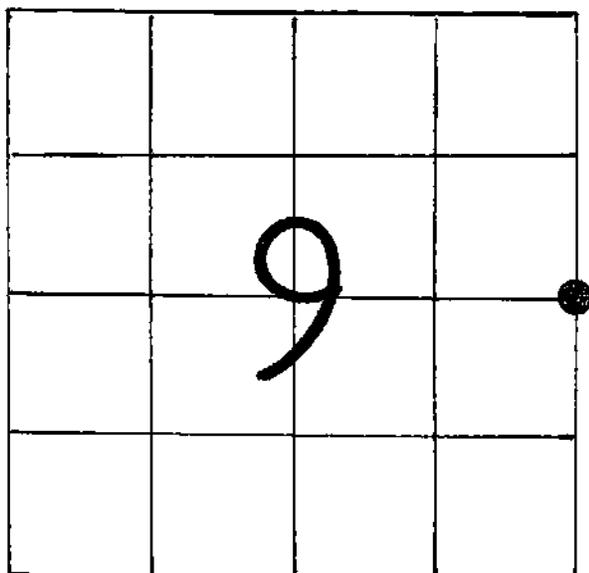

LOCATION OF LANDMARK

WISCONSIN COORDINATE SYSTEM

North

East

Theta Angle

Horiz. Order

Vert. Order

TYPE OF LANDMARK

Plastic capped rebar

BEARINGS ARE REFERENCED TO

Crew: William C. Jung
Peter F. Follansbee

Date: March 30, 1992

Describe any record evidence, monument evidence, testimonial evidence or any other material evidence you considered and whether the monument was found or restored through acceptance of an obliterated evidence location.

I found a plastic capped rebar at the corner. It is buried in the East gravel shoulder and 7" East of the East asphalt edge of the Southbound lane. The old corner had been destroyed during highway construction.


Describe or show any material discrepancy between the location of the restored corner and that of the corner previously restored or reestablished.

None known.

RECORD OF DURABLE WITNESS MONUMENTS

NO	DESCRIPTION	BEARING	DISTANCE
1			
2			
3			
4			

Note: All (5) points are on line.

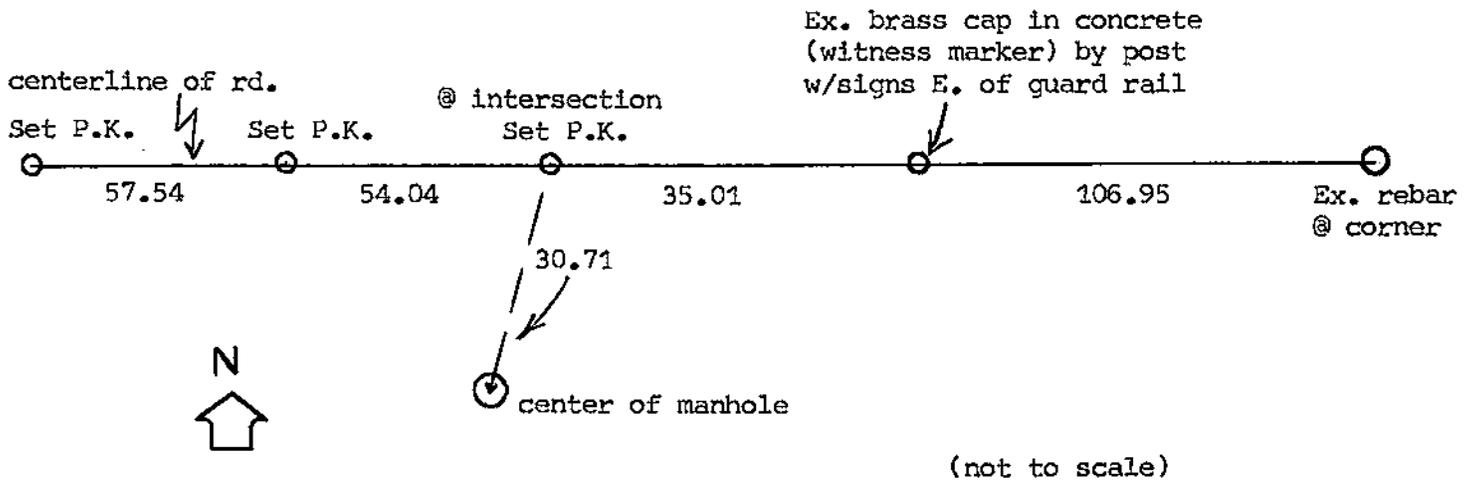

PLAN VIEW DRAWING OF REFERENCE TIES


MAP SHOWING DISTANCE AND DIRECTION TO OTHER PUBLIC LAND SURVEY CORNERS USED FOR REESTABLISHING THE CORNER

No section measurements made by me at this time.

I, William C. Jung, Deputy County Surveyor,
 HEREBY CERTIFY THAT THE CORNER LOCATION SHOWN ON THIS RECORD
 WAS DETERMINED BY ME OR UNDER MY DIRECTION AND CONTROL AND
 THAT THIS U. S. PUBLIC LAND SURVEY MONUMENT RECORD IS CORRECT
 AND COMPLETE TO THE BEST OF MY KNOWLEDGE AND BELIEF.

William C. Jung
 Signature

June 9, 1992
 Date

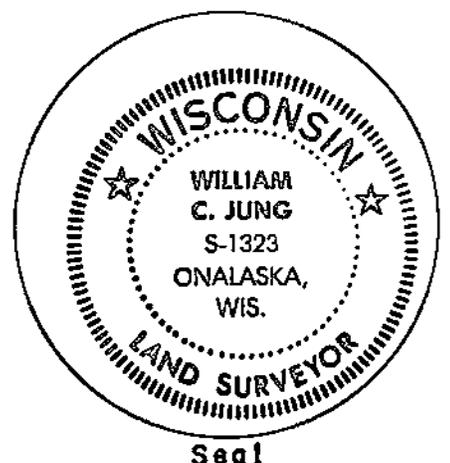


Seal

FIELD SURVEY NOTES
PRESERVATION OF LANDMARKS
 (Pursuant to Section 59.635(7) Wisconsin Statutes)


State Highway Commission of Wisconsin
 Form E-D-707-66

COUNTY <i>La Crosse</i>		
TOWN <i>City of Onalaska</i>		
HIGHWAY <i>S.T.H. 157</i>		
SECTION <i>9</i>	TOWNSHIP <i>T16N</i>	RANGE <i>R7W</i>
TYPE OF LANDMARK <i>Brass Disk in 8" Concrete</i>		

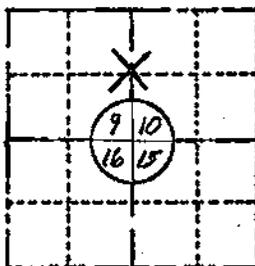

LOCATION SKETCH
 (Location of landmark indicated by "x")

This space for copy of field notes or ties to the above described landmarks

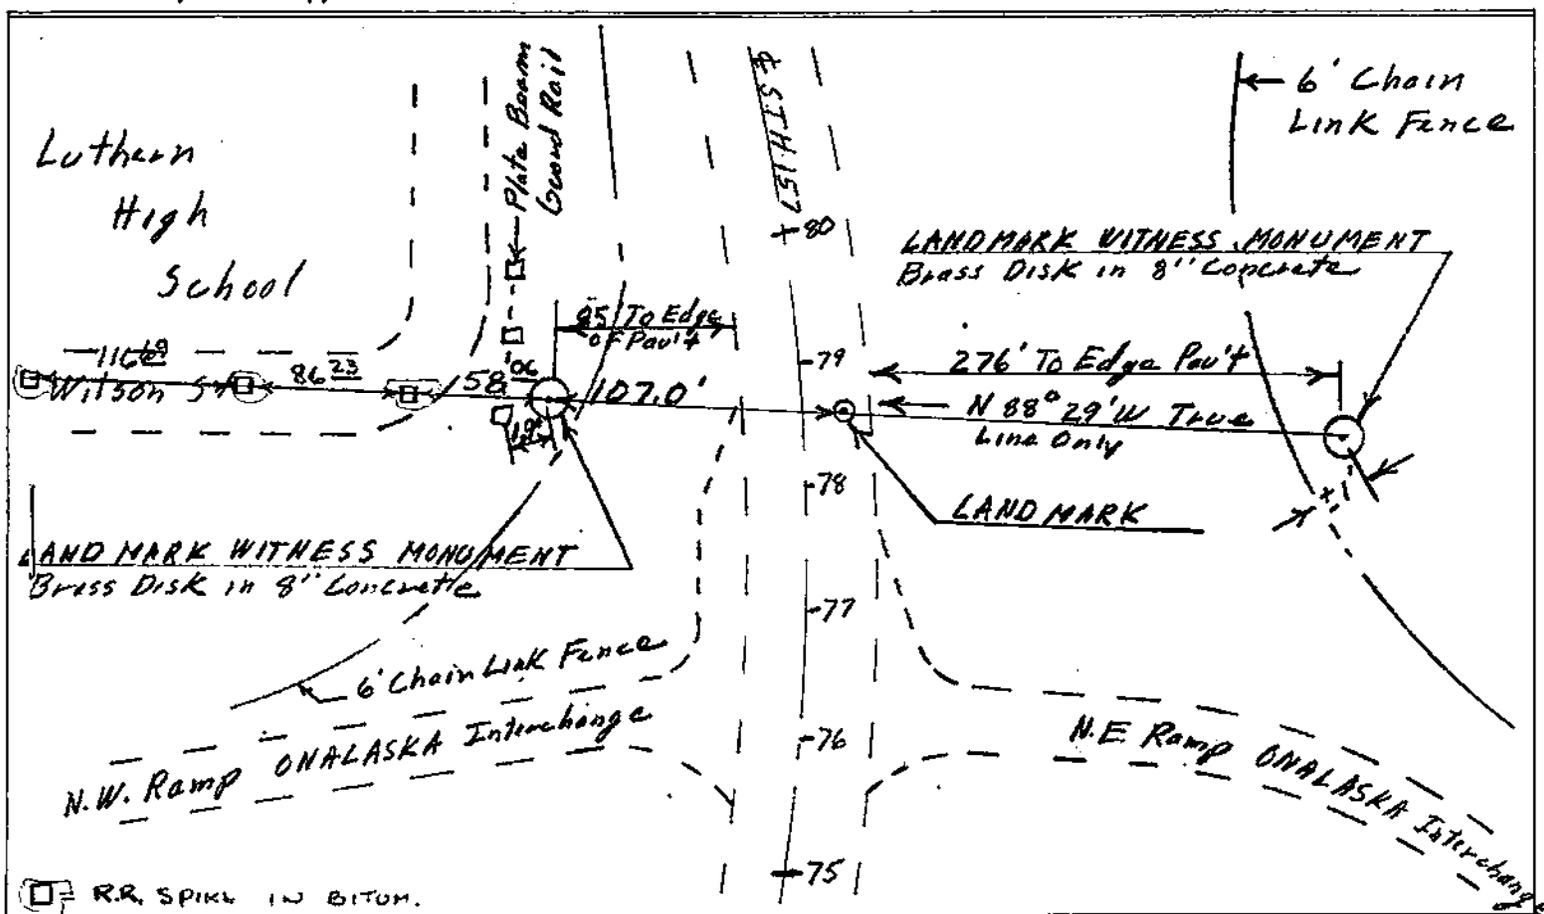

R.R. SPIKE IN BITUM.
 SET BY M.E.W. 5-16-82
 CREW CHIEF.

FILED UNDER PROJECT NUMBER <i>T0614(4)</i>			COUNTY CLERK'S OFFICE COUNTY OF <i>WISCONSIN</i> } 85	
SBC DISTRICT OFFICE NUMBER <i>5</i>	CITY <i>LaCrosse</i>	COUNTY <i>LaCrosse</i>	DATE RECEIVED FOR RECORD	DATE COPY SENT TO COUNTY SURVEYOR
LOCATED OR ESTABLISHED BY NAME <i>Gilbert O. Bennett</i> TITLE <i>Engineer III</i> DATE <i>10/5/67</i>			SIGNATURE OF COUNTY CLERK	