


21607092020

U. S. PUBLIC LAND SURVEY MONUMENT RECORD

SECTION 9 T 16 N, R 7 W, ~~TOWN~~ OF CITY OF ONALASKA
 LA CROSSE COUNTY

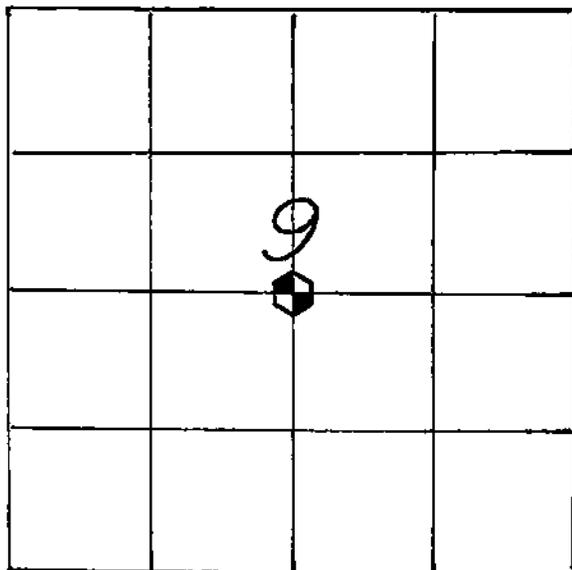

LOCATION OF LANDMARK

Crew: WILLIAM C. JUNG
 PETER F. FOLLANSBEE
 Date: 9/03/1996

WISCONSIN COORDINATE SYSTEM
North
East
Theta Angle
Horiz. Order
Vert. Order
TYPE OF LANDMARK
Brass cap Lunde marker.
BEARINGS ARE REFERENCED TO

Describe any record evidence, monument evidence, testimonial evidence or any other material evidence you considered and whether the monument was found or restored through acceptance of an obliterated evidence location.

The Berntsen that I set back in 1986 was destroyed because of road construction. I set a brass capped Lunde marker at the old corner location.


Describe or show any material discrepancy between the location of the restored corner and that of the corner previously restored or reestablished.

None Known.

U. S. PUBLIC LAND SURVEY MONUMENT RECORD

SECTION 9 T 16 N, R 7 W, CITY OF ONALASKA

LA CROSSE COUNTY

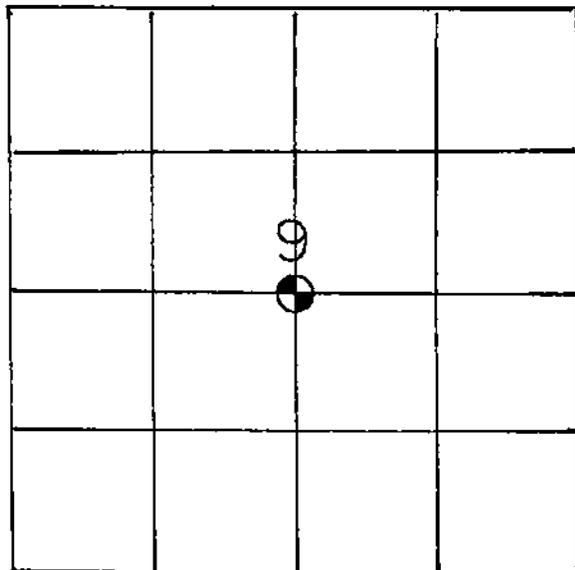

WISCONSIN COORDINATE SYSTEM
North
East
Theta Angle
Horiz. Order
Vert. Order
TYPE OF LANDMARK BERNTSEN
BEARINGS ARE REFERENCED TO

LOCATION OF LANDMARK

CREW:
 BILL JUNG
 PERRY DAHL
 BILL WOODMAN
 DATE: 7-1-86

Describe any record evidence, monument evidence, testimonial evidence or any other material evidence you considered and whether the monument was found or restored through acceptance of an obliterated evidence location.

I found an existing iron pipe at the corner. This point has been used as the Center 1/4 Corner in previous surveys. I accepted this location and set a Berntsen top over the iron pipe.


Describe or show any material discrepancy between the location of the restored corner and that of the corner previously restored or reestablished.

I do not know at this time if this corner falls at the true center of section. Considering the number of surveys tied to it, I feel that it should be accepted as the Center 1/4 Corner.

VOID
aweg

RECORD OF DURABLE WITNESS MONUMENTS

NO	DESCRIPTION	BEARING	DISTANCE
1	TOP BOLT OF FIRE HYDRANT	-----	25.4'
2	CENTER OF STORM SEWER MANHOLE	-----	12.2'
3	CENTER OF MANHOLE	-----	14.71'
4	CENTER OF WATER SHUT-OFF	-----	33.96'

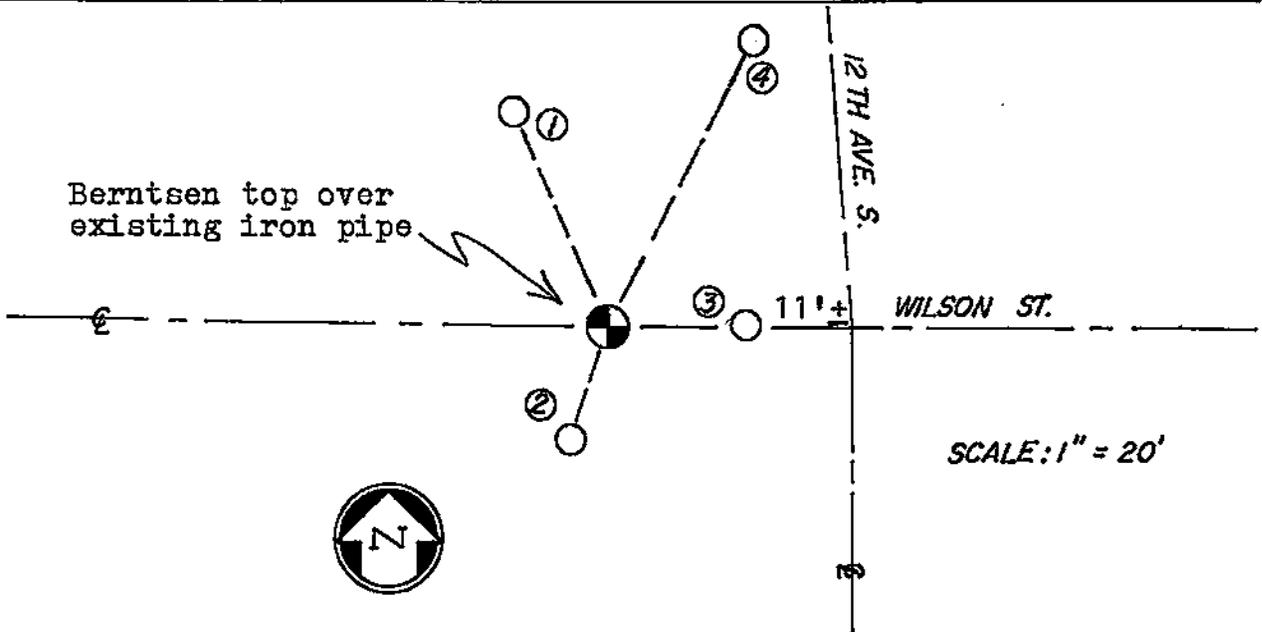

PLAN VIEW DRAWING OF REFERENCE TIES


MAP SHOWING DISTANCE AND DIRECTION TO OTHER PUBLIC LAND SURVEY CORNERS USED FOR REESTABLISHING THE CORNER

(no measurements made by me at this time)

I, William C. Jung, Deputy County Surveyor,
 HEREBY CERTIFY THAT THE CORNER LOCATION SHOWN ON THIS RECORD
 WAS DETERMINED BY ME OR UNDER MY DIRECTION AND CONTROL AND
 THAT THIS U. S. PUBLIC LAND SURVEY MONUMENT RECORD IS CORRECT
 AND COMPLETE TO THE BEST OF MY KNOWLEDGE AND BELIEF.

William C. Jung
 Signature

January 12, 1987
 Date

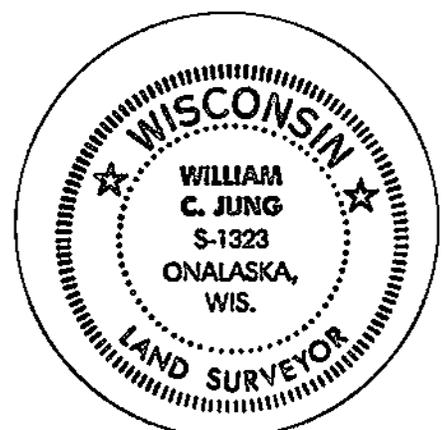

Seal