


21607100020

U. S. PUBLIC LAND SURVEY MONUMENT RECORD

SECTION 10 T 16 N, R 7 W, ^{CITY}~~TOWN~~ OF ONALASKA

LA CROSSE COUNTY

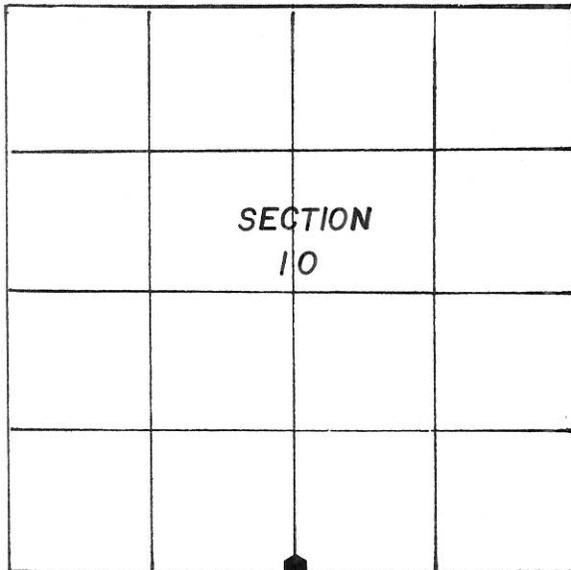

LOCATION OF LANDMARK

WISCONSIN COORDINATE SYSTEM

North

East

Theta Angle

Horiz. Order

Vert. Order

TYPE OF LANDMARK

Berntsen MONUMENT

BEARINGS ARE REFERENCED TO

South Line of the SW $\frac{1}{4}$ of Section 10,
T16N, R7W

Crew: Bill Woodman, RLS 1796
 Bill Jung, RLS 1323, Deputy County Surveyor
 Perry Dahl
 11/21/85

Describe any record evidence, monument evidence, testimonial evidence or any other material evidence you considered and whether the monument was found or restored through acceptance of an obliterated evidence location.


Found monument of record, axle hub, replaced with **Berntsen** Monument

Describe or show any material discrepancy between the location of the restored corner and that of the corner previously restored or reestablished.

Zoning and Planning Department

LA CROSSE COUNTY, WISCONSIN

COURTHOUSE, LA CROSSE, WISCONSIN 54601

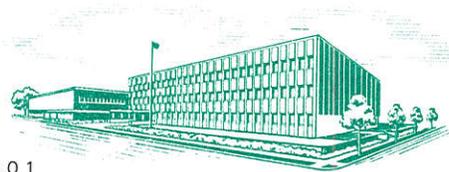

Telephone: 785-9722

To Whom It May Concern:

This is to certify that on May 13, 1992, Peter Follansbee and I replaced a broken and rotted Berntsen at the South 1/4 of Section 10-T16N-R7W with a brass capped Lunde marker.

A handwritten signature in cursive script that reads "William C. Jung".

William C. Jung

Deputy County Surveyor

June 9, 1992

