


U. S. PUBLIC LAND SURVEY MONUMENT RECORD

SECTION 10 T 16 N, R 7 W, ~~TOWN~~ OF Onalaska ^{City}

LA CROSSE COUNTY

SECTION 10

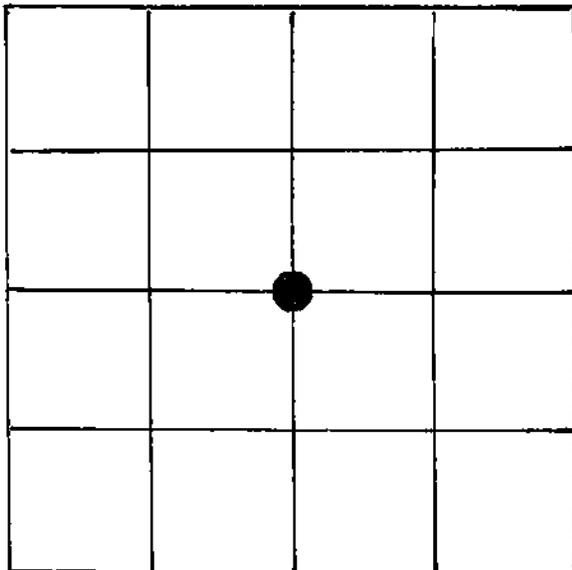

LOCATION OF LANDMARK

WISCONSIN COORDINATE SYSTEM

North

East

Theta Angle

Horiz. Order

Vert. Order

TYPE OF LANDMARK

Berntsen marker

BEARINGS ARE REFERENCED TO

Assumed

Crew: William C. Jung
Peter F. Follansbee

Date: July 9, 1990

Describe any record evidence, monument evidence, testimonial evidence or any other material evidence you considered and whether the monument was found or restored through acceptance of an obliterated evidence location.


The interstate map shows a 2" iron pipe at this corner. In January of 1973 Ron Blummer shows a Berntsen at this corner. Did he replace the pipe with the Berntsen? I think so. This was used as the Center 1/4 for the plats of Country Air Estates and Sandalwood. Logan and Scholze have also used this monument as the corner. It is very close to being on line between the North and South 1/4 corners. I accepted this corner by "common report" as the corner has obviously been used in many previous surveys.

Describe or show any material discrepancy between the location of the restored corner and that of the corner previously restored or reestablished.

It does not appear that Hofmeister used this corner in 1980. I am not sure if it is at the true Center 1/4 corner.

RECORD OF DURABLE WITNESS MONUMENTS

NO	DESCRIPTION	BEARING	DISTANCE
1	Iron pipe as per Scholze map 3/14/90	---	144.35
2	Existing witness pipe	-----	15.71
3			
4			

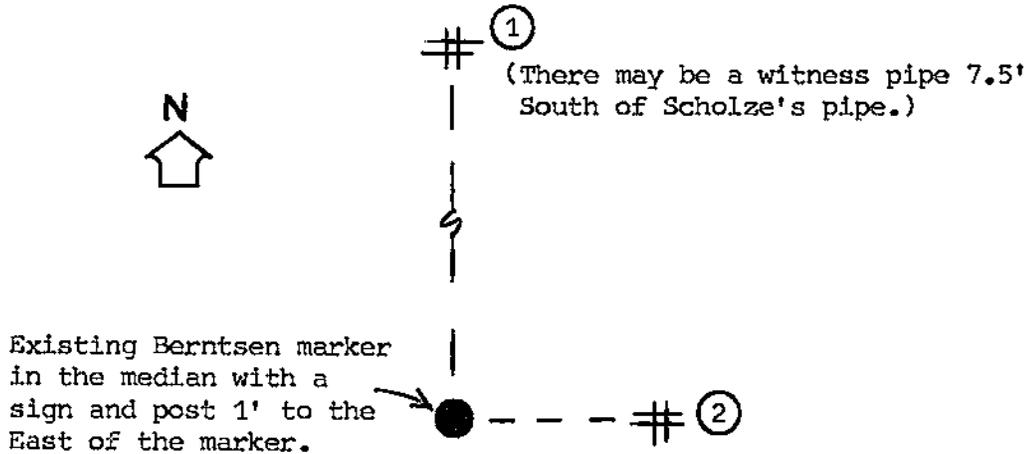

Note: see additional ties below

(not to scale)


PLAN VIEW DRAWING OF REFERENCE TIES



MAP SHOWING DISTANCE AND DIRECTION TO OTHER PUBLIC LAND SURVEY CORNERS USED FOR REESTABLISHING THE CORNER

(as per data of record)


(not to scale)

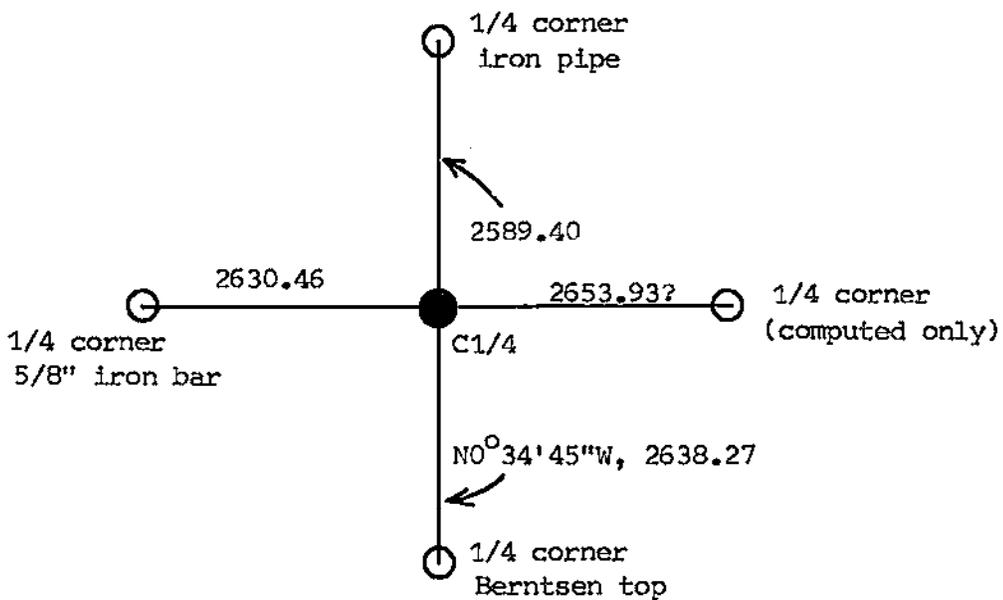


I, William C. Jung, Deputy County Surveyor,
 HEREBY CERTIFY THAT THE CORNER LOCATION SHOWN ON THIS RECORD
 WAS DETERMINED BY ME OR UNDER MY DIRECTION AND CONTROL AND
 THAT THIS U. S. PUBLIC LAND SURVEY MONUMENT RECORD IS CORRECT
 AND COMPLETE TO THE BEST OF MY KNOWLEDGE AND BELIEF.

William C. Jung
 Signature

February 14, 1991
 Date

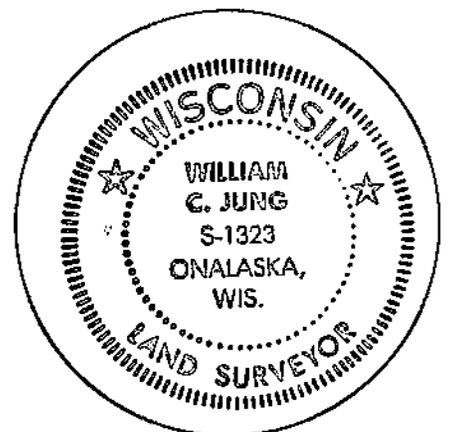

Seal

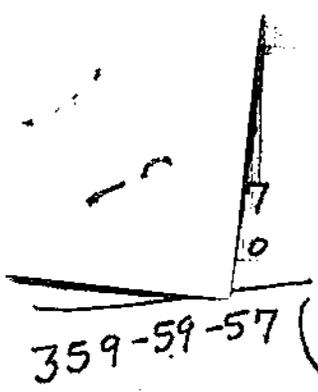

359-59-57 (High shot!)

Ex. I.P., 88" N. of Fence



H=144.29
S=144.30
S=144.30
V=0-16



S=237.29, H=237.28
S=237.26, H=237.31
S=237.28
V=0-31

5' S. of Fence

51° 21.5'

(on line)
11' 10" N. of concrete

(under sign)



242.05

Storm Drain

297-01

Ex. Berntsen

C/4 10-16-7

S=122.99
S=123.00
V=1-52.5
H=122.92
11° 37.45'
V=0-21.2
S=242.63
S=242.62
H=242.61

(Hot
+80°F)

8/7/95

P.E.B

o = Set 17" long bolt

6/15/99 P.E.B

Fd. the Berntsen, buried some, in good condition. Set sign and post to the N. of it. I.P. to the E. was knocked out.