


U. S. PUBLIC LAND SURVEY MONUMENT RECORD

SECTION 11 T 16 N, R 7 W, CITY ONALASKA OF LA CROSSE COUNTY

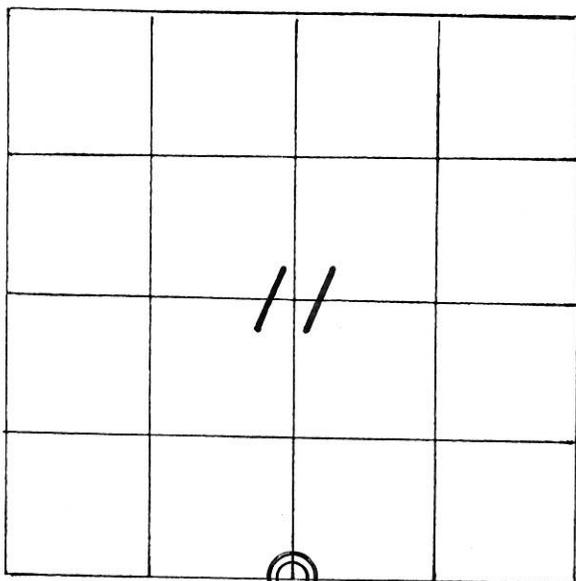

LOCATION OF LANDMARK

CREW: **WILLIAM C. JUNG**
PETER F. FOLLANSBEE
 DATE: **9/22/2003**

WISCONSIN COORDINATE SYSTEM
North
East
Theta Angle
Horiz. Order
Vert. Order
TYPE OF LANDMARK
1-1/2" (O.D.) IRON PIPE WITH PLASTIC PLUG.
BEARINGS ARE REFERENCED TO

Describe any record evidence, monument evidence, testimonial evidence or any other material evidence you considered and whether the monument was found or restored through acceptance of an obliterated evidence location.


I found an iron pipe at the corner that had been used as the corner in previous surveys of record. I accepted the pipe as the best available evidence of the original government position. I set one of my red plastic plugs in the pipe.

Describe or show any material discrepancy between the location of the restored corner and that of the corner previously restored or reestablished.

NONE KNOWN.

RECORD OF DURABLE WITNESS MONUMENTS

NO	DESCRIPTION	MAGNETIC	
		BEARING	DISTANCE
1	SET A 3/4"x30" IRON BAR WITH RED PLASTIC CAP	S 88° W	34.26 FT.
2	SET A NAIL IN WEST SIDE OF A 39-1/2" MAPLE	NORTH ±	35.46 FT.
3	EXISTING 1-3/4" (O.D.) IRON PIPE	N 88° E	35.15 FT.
4	SET A 3/4"x30" IRON BAR WITH RED PLASTIC CAP	S 06° E	32.70 FT.

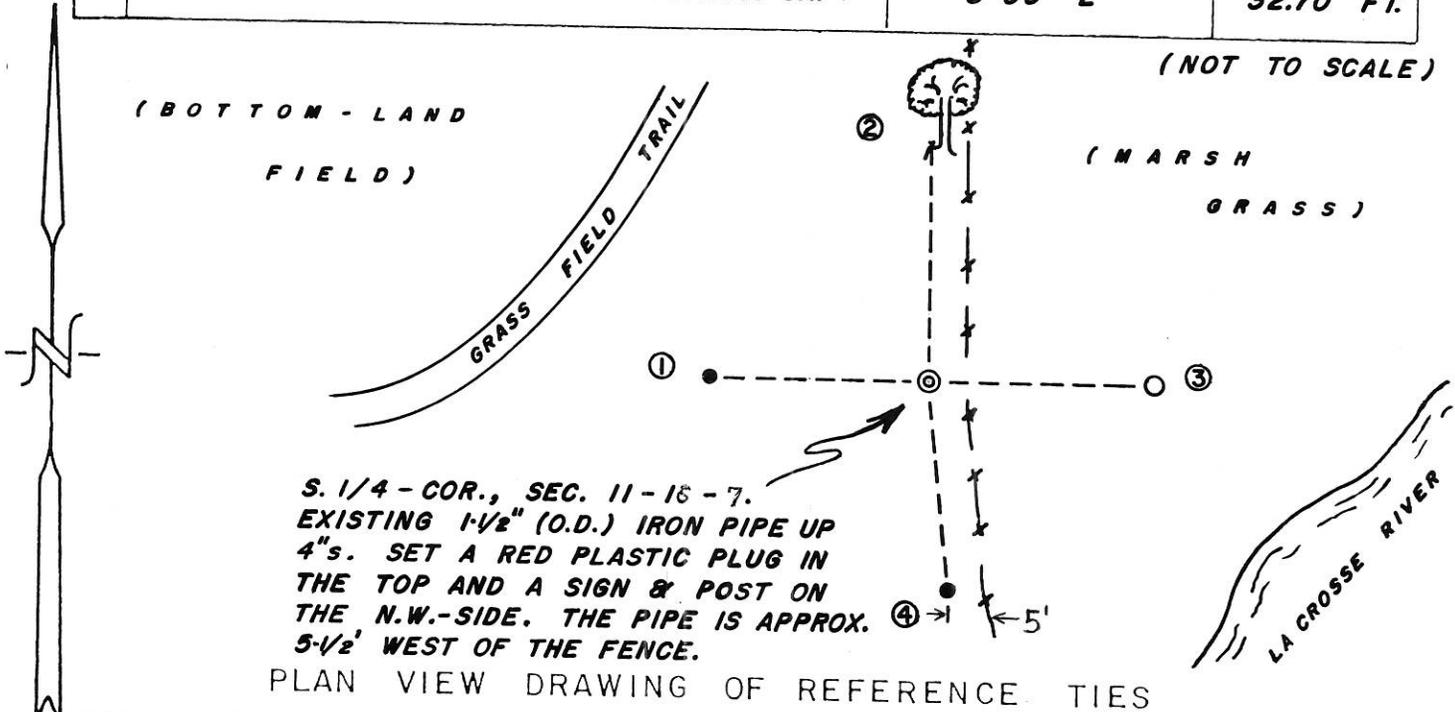

MAP SHOWING DISTANCE AND DIRECTION TO OTHER PUBLIC LAND SURVEY CORNERS USED FOR REESTABLISHING THE CORNER

No further section measurements were made by me at this time. The correct location of this corner was confirmed by previous section measurements of record.

I, WILLIAM C. JUNG, COUNTY SURVEYOR
HEREBY CERTIFY THAT THE CORNER LOCATION SHOWN ON THIS RECORD WAS DETERMINED BY ME OR UNDER MY DIRECTION AND CONTROL AND THAT THIS U. S. PUBLIC LAND SURVEY MONUMENT RECORD IS CORRECT AND COMPLETE TO THE BEST OF MY KNOWLEDGE AND BELIEF.

William C. Jung 2/5/04
Signature Date

