


21607120000

## U. S. PUBLIC LAND SURVEY MONUMENT RECORD

SECTION 12 T 16 N, R 7 W, TOWN OF MEDARY

LA CROSSE COUNTY

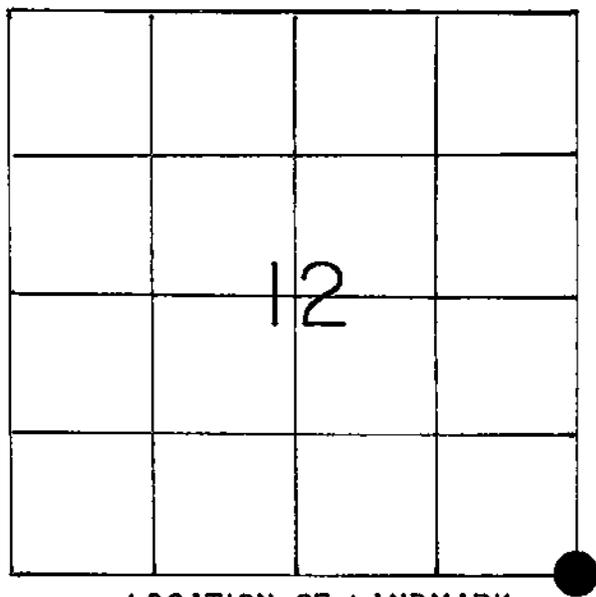

LOCATION OF LANDMARK

WISCONSIN COORDINATE SYSTEM

North

East

Theta Angle

Horiz. Order

Vert. Order

TYPE OF LANDMARK

**BERNTSEN**

BEARINGS ARE REFERENCED TO

Crew: William Jung  
8/9/84

Describe any record evidence, monument evidence, testimonial evidence or any other material evidence you considered and whether the monument was found or restored through acceptance of an obliterated evidence location.


The Interstate R/W map shows a fence corner at the section corner. It also shows that the R/W bends at the section corner. I found a R/W post at the fence corner. I also found a broken stone on the South side of the R/W post. It could have been an old corner stone. I accepted this occupied corner as the best available evidence of the original corner and set a Berntsen monument on the North side of the R/W post. I discarded the stone. The corner has since been used by Bob Chalsma when he was surveying in Section 18 of T16N-R6W

Describe or show any material discrepancy between the location of the restored corner and that of the corner previously restored or reestablished.

None known.

RECORD OF DURABLE WITNESS MONUMENTS

NO	DESCRIPTION	BEARING	DISTANCE
1	SET 1/4" IRON PIPE	NORTH	16.5'
2	SET 1/4" IRON PIPE	WEST	16.5'
3	SET 1/4" IRON PIPE	SOUTH	16.5'
4	SET 1/4" IRON PIPE	EAST	14.5'

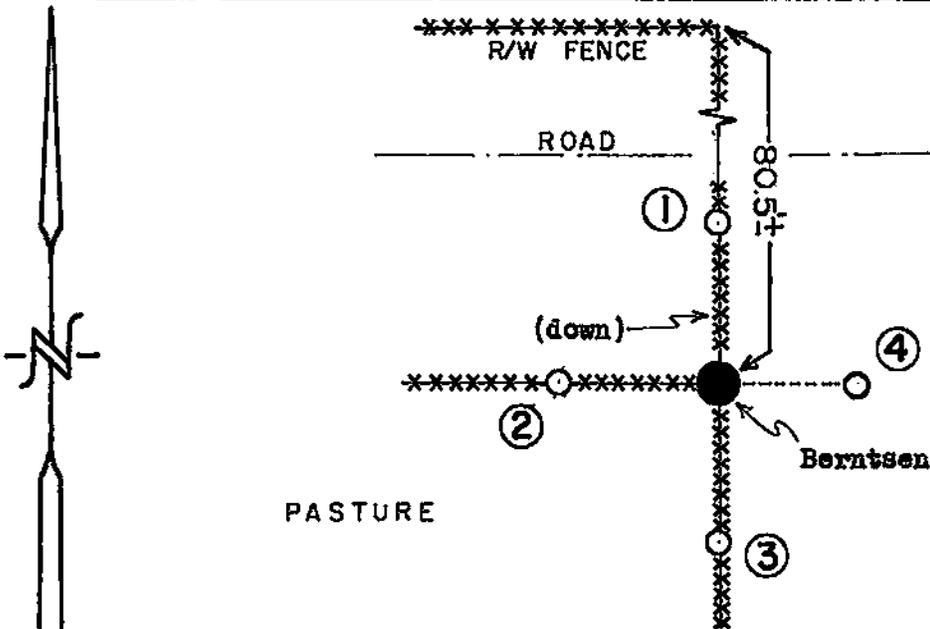


PLAN VIEW DRAWING OF REFERENCE TIES

MAP SHOWING DISTANCE AND DIRECTION TO OTHER PUBLIC LAND SURVEY CORNERS USED FOR REESTABLISHING THE CORNER

I, William C. Jung, Deputy County Surveyor,  
 HEREBY CERTIFY THAT THE CORNER LOCATION SHOWN ON THIS RECORD  
 WAS DETERMINED BY ME OR UNDER MY DIRECTION AND CONTROL AND  
 THAT THIS U. S. PUBLIC LAND SURVEY MONUMENT RECORD IS CORRECT  
 AND COMPLETE TO THE BEST OF MY KNOWLEDGE AND BELIEF.

William C. Jung  
 Signature

December 6, 1985  
 Date

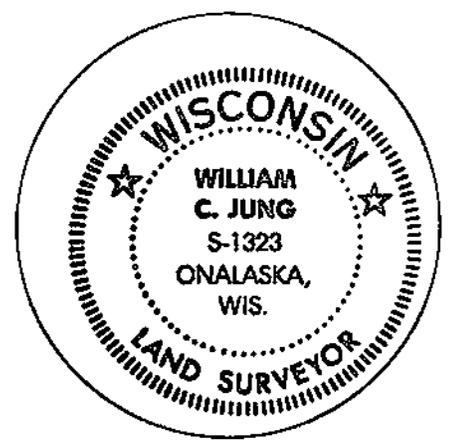

Seal