


U. S. PUBLIC LAND SURVEY MONUMENT RECORD

SECTION 12 T 16 N, R 7 W, City Onalaska TOWN OF MEDARY

LA CROSSE COUNTY

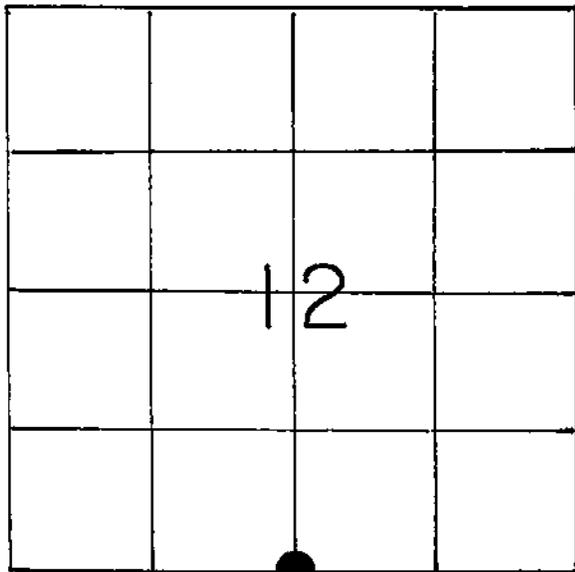

LOCATION OF LANDMARK

WISCONSIN COORDINATE SYSTEM	
North	
East	
Theta Angle	
Horiz. Order	
Vert. Order	
TYPE OF LANDMARK	P.K. nail & cap
IRON ROD	2" iron pipe
BEARINGS ARE REFERENCED TO	
True	

Crew: William Jung

8/9/84

Crew: William C. Jung

Peter Follansbee

5/22/95

Crew: William Jung

Peter Follansbee

3/17/98 and 8/19/98 &

5/3/07

Describe any record evidence, monument evidence, testimonial evidence or any other material evidence you considered and whether the monument was found or restored through acceptance of an obliterated evidence location.

I found a railroad spike at the corner. I removed the spike and excavated a 7" square hole to a depth of 7" where I found a 1 1/2" pipe. The pavement was new and the digging hard, so I drove a 5/8"x18" reinforcing rod into the center of the pipe. The rod is the corner. I also set nails with plastic caps 1' East and 1' South of the corner. The corner is 0.02' North and 0.02' East of the railroad spike. To the West of the corner at a distance of 33 feet I found a pipe bent over. This 1/4 corner location has been used as the corner in previous surveys done by Clayton Connell.

Describe or show any material discrepancy between the location of the restored corner and that of the corner previously restored or reestablished.

None known.

***** 5/22/95

I found the iron rod (rebar) inside of an iron pipe. The rod was bent so I removed it. An iron pipe is now at the corner.

***** 8/19/98 & 5/3/07

The corner of record was knocked out during construction. We set a P.K. nail & cap at the corner.


RECORD OF DURABLE WITNESS MONUMENTS

NO	DESCRIPTION	BEARING	DISTANCE
1	CENTER OF EXISTING UTILITY BOX @ BASE	---	33'
2	CENTER OF EXISTING UTILITY BOX	---	31.6'
3	EXISTING 2" IRON PIPE (1 1/8")	EAST	33'
4	OVERGROWN NAIL IN 8 1/2" NORWAY PINE, UNBLAZED	N60°E ±	34.94'


set new nail in NW side of Norway (10 1/2")

(0.66' South is an ex. nail and cap)
Existing 2" iron pipe at the corner
(22.66' E-SE is a "hole" in the "T"
on the center of a water shutoff cap)

Note: 25.74' to the East of the P.K. is a hydrant

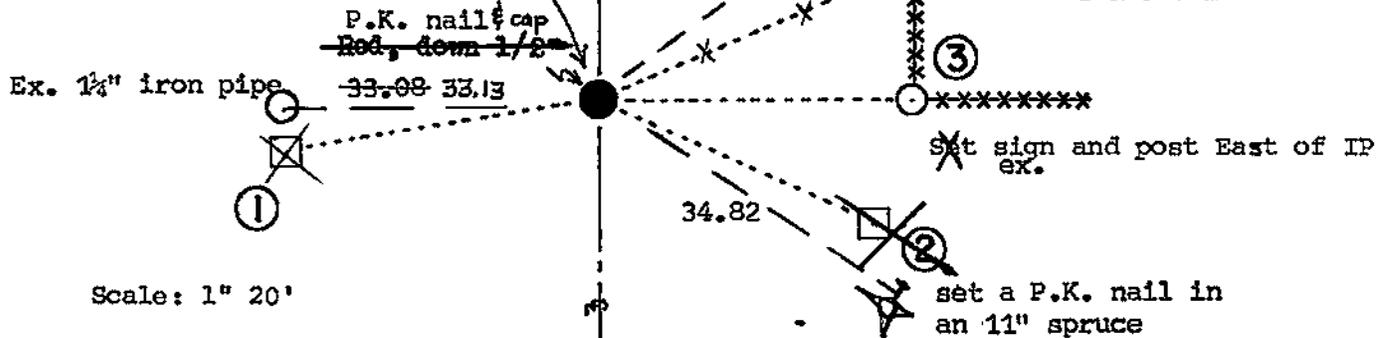

MAP SHOWING DISTANCE AND DIRECTION TO OTHER PUBLIC LAND SURVEY CORNERS USED FOR REESTABLISHING THE CORNER

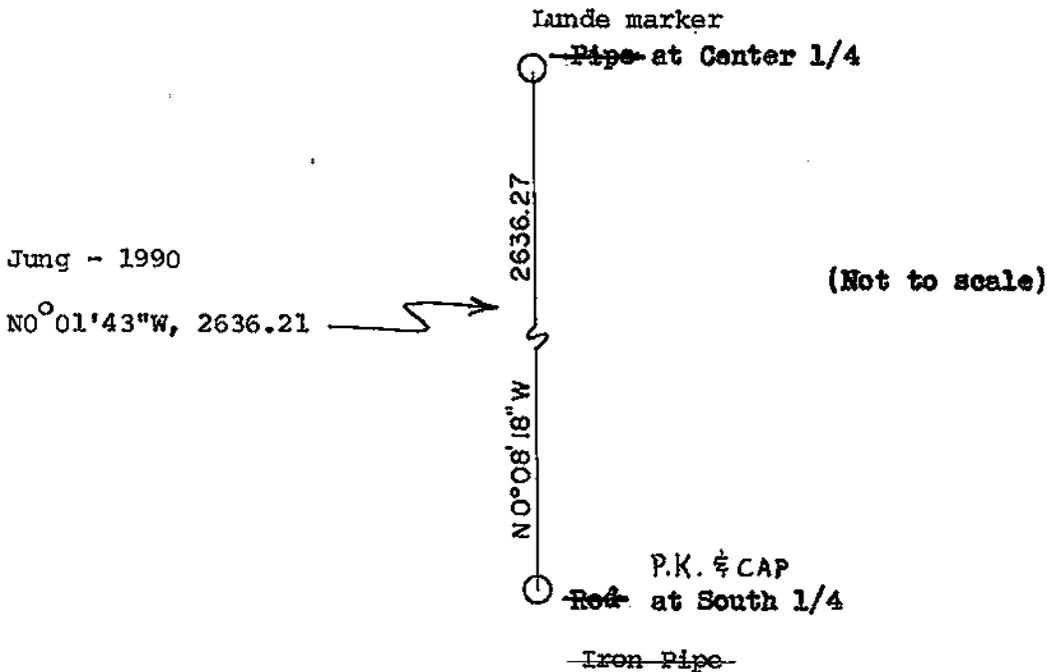

William C. Jung, ~~Deputy~~ County Surveyor, R.L.S. 1323
I, _____
HEREBY CERTIFY THAT THE CORNER LOCATION SHOWN ON THIS RECORD
WAS DETERMINED BY ME OR UNDER MY DIRECTION AND CONTROL AND
THAT THIS U. S. PUBLIC LAND SURVEY MONUMENT RECORD IS CORRECT
AND COMPLETE TO THE BEST OF MY KNOWLEDGE AND BELIEF.

William C. Jung
Signature

December 5, 1985
Date

Revised: 3/25/99 *wcj*

Revised: 8/21/95 *asej*
" 7/19/07 *asej*

