


21607122000

## U. S. PUBLIC LAND SURVEY MONUMENT RECORD

SECTION 12 T 16 N, R 7 W, TOWN OF MEDARY / HAMILTON

LA CROSSE COUNTY

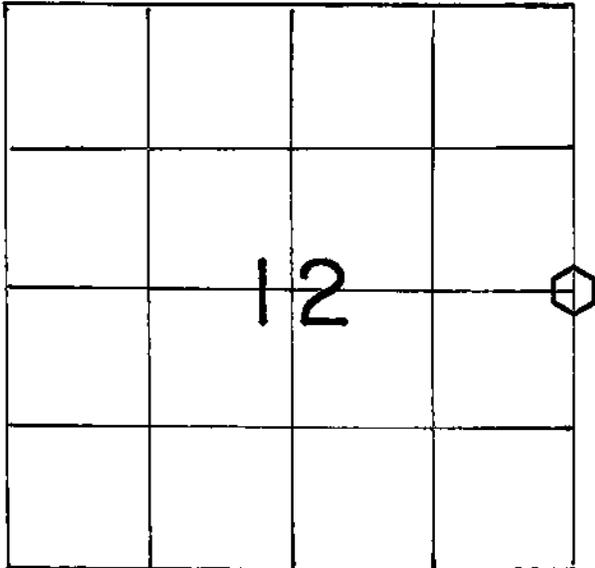

LOCATION OF LANDMARK

Crew: WILLIAM C. JUNG  
PETER F. FOLLANSBEE

Date: 3/23/1994

Describe any record evidence, monument evidence, testimonial evidence or any other material evidence you considered and whether the monument was found or restored through acceptance of an obliterated evidence location.

Ray Pelishek set a Berntsen marker at this corner in October of 1975. I found this marker broken in two pieces and replaced it with a brass capped Lunde marker. The marker is at the old occupied corner.

Describe or show any material discrepancy between the location of the restored corner and that of the corner previously restored or reestablished.

None Known.

## WISCONSIN COORDINATE SYSTEM

North

East

Theta Angle

Horiz. Order

Vert. Order

## TYPE OF LANDMARK

Set brass cap Lunde marker.

BEARINGS ARE REFERENCED TO



VOID

RECORD OF LAND CORNER PERPETUATION

No. \_\_\_\_\_

STATE OF WISCONSIN

County of La Crosse } ss.

I, Ray Pelishek, hereby certify that the information shown hereon correctly describes the original corner, resurvey information, evidence found, type of monument found or placed, and witness monuments and accessories used to perpetuate the location of the original or established corner.

Dated this 5th day of November, 19 81

at La Crosse, Wisconsin.


Ray Pelishek  
La Crosse County Surveyor  
Title

COUNTY	La Crosse		
TOWN	Medary - Hamilton		
HIGHWAY			
SECTION	7 12	TOWNSHIP	16 16
RANGE	6 7		
TYPE OF LANDMARK	Berntsen Alum.		

Date of Survey Oct. 7, 1975


Drafted by M. Weibel

Date Nov. 4, 1981

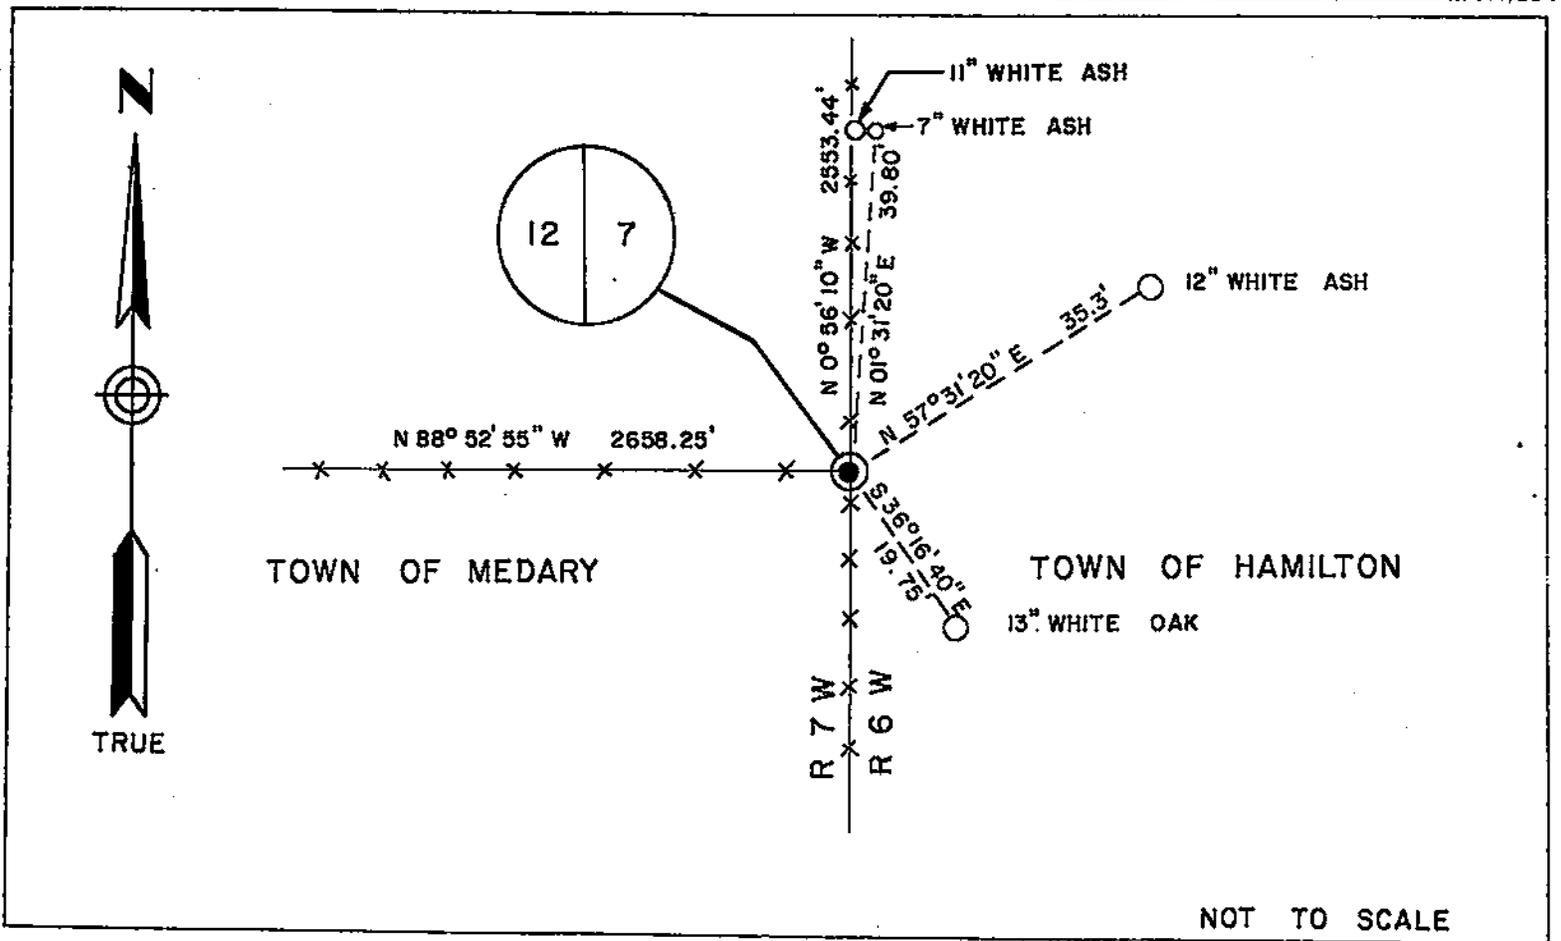

NOT TO SCALE

WISCONSIN COORDINATE SYSTEM	
North	Zone
East	
Elevation	Theta Angle
Vertical control order	
Horizontal control order	

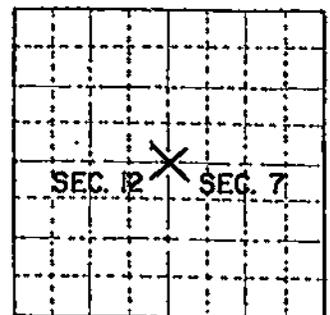

REMARKS:

LOCATION SKETCH  
(Location of landmark indicated by "x")