


U. S. PUBLIC LAND SURVEY MONUMENT RECORD

SECTION 12 T 16 N, R 7 W, TOWN OF MEDARY

LA CROSSE COUNTY

Section 12

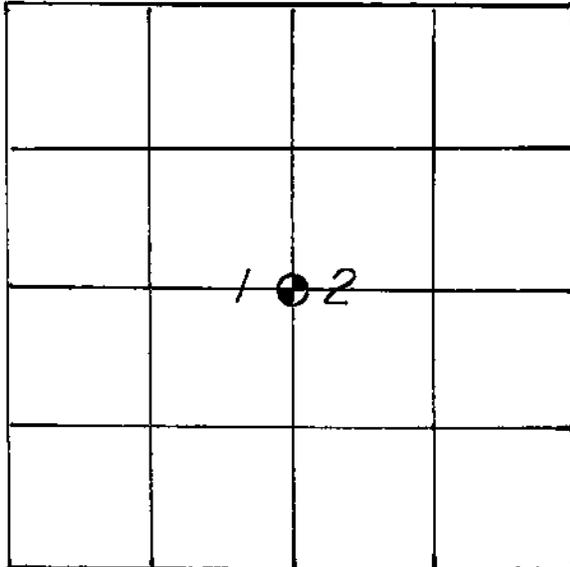

LOCATION OF LANDMARK

CREW:
 BILL JUNG
 PERRY DAHL
 DATE: 8-4-86

Crew:
 William C. Jung
 Peter F. Follansbee
 Date: July and August, 1990

Describe any record evidence, monument evidence, testimonial evidence or any other material evidence you considered and whether the monument was found or restored through acceptance of an obliterated evidence location.

I found an iron pipe at the occupied corner, removed it, and replaced it with a Lunde Marker. This iron pipe had been used in previous surveys and was the accepted Center 1/4 Corner.

7/24/90 I found the Lunde buried in a fill slope. The line fences to the East, West, and South were torn out. I set a wood hub over the Lunde. A bottle with a shell casing was buried to the North, and a post with a sign was also set to the North. The fence guard post was moved.

Describe or show any material discrepancy between the location of the restored corner and that of the corner previously restored or reestablished.

None known.

WISCONSIN COORDINATE SYSTEM

North

East

Theta Angle

Horiz. Order

Vert. Order

TYPE OF LANDMARK


BRASS CAPPED LUNDE MARKER

BEARINGS ARE REFERENCED TO

True North


RECORD OF DURABLE WITNESS MONUMENTS

NO	DESCRIPTION	BEARING	DISTANCE
1	IRON PIPE IN FENCELINE (1990-Gone!)	WEST±	29.24'
2	IRON PIPE IN FENCELINE	SOUTH±	32.30'
3	Set an iron pipe on the North R/W of North Kinney Coulee Road	(1990) = S0°01'43"E True = S0-08-18E	1213.81
4	Existing iron pipe	S0°01'43"E	519.74

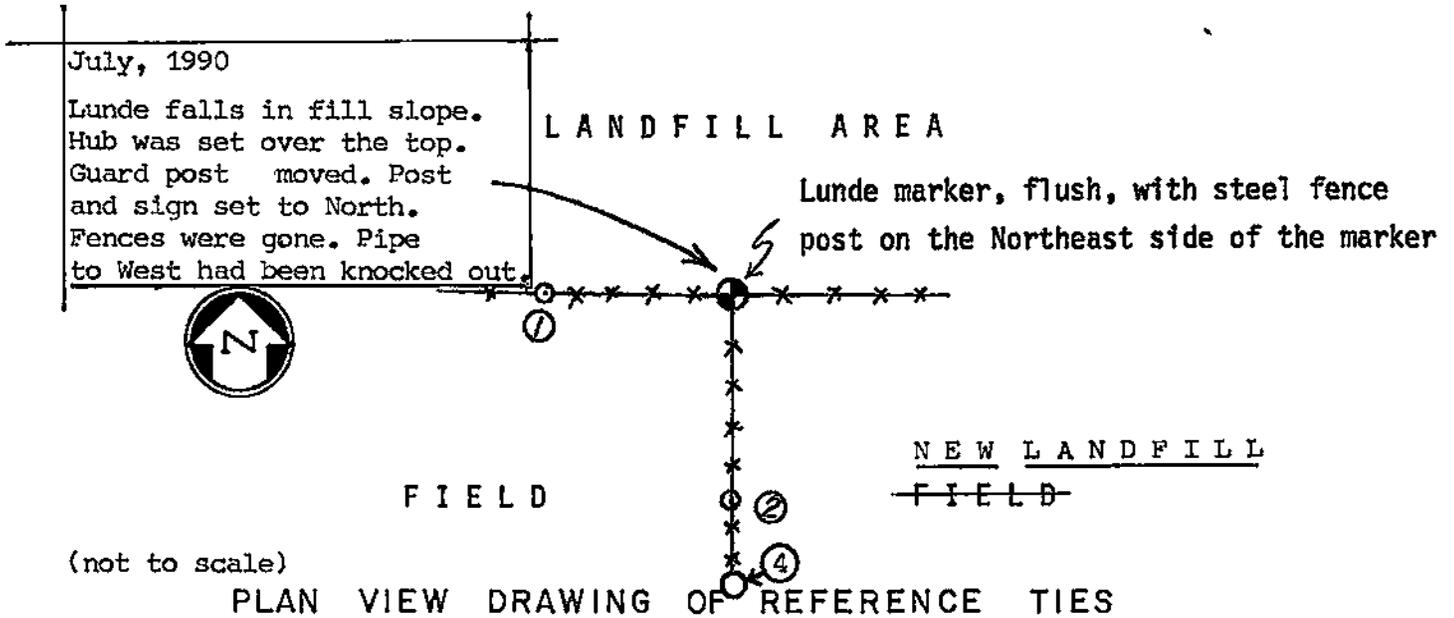

MAP SHOWING DISTANCE AND DIRECTION TO OTHER PUBLIC LAND SURVEY CORNERS USED FOR REESTABLISHING THE CORNER


(not to scale)

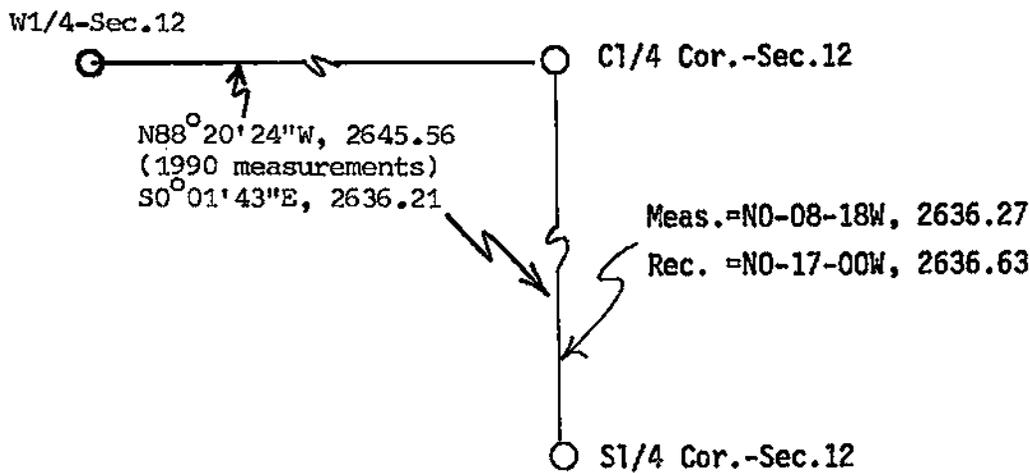

I, William C. Jung, Deputy County Surveyor.
 HEREBY CERTIFY THAT THE CORNER LOCATION SHOWN ON THIS RECORD
 WAS DETERMINED BY ME OR UNDER MY DIRECTION AND CONTROL AND
 THAT THIS U. S. PUBLIC LAND SURVEY MONUMENT RECORD IS CORRECT
 AND COMPLETE TO THE BEST OF MY KNOWLEDGE AND BELIEF.

William C. Jung August 4, 1986
 Signature Date

Revised: January 10, 1991
wcj

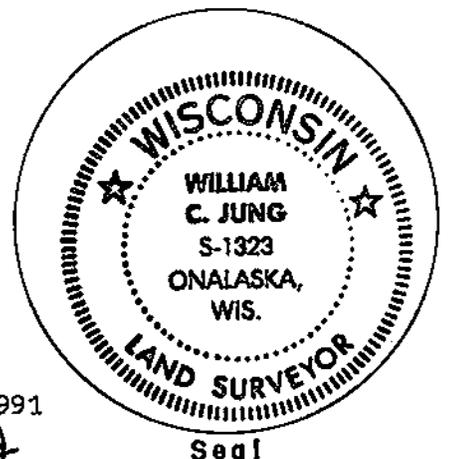


Seal

U. S. PUBLIC LAND SURVEY MONUMENT RECORD

SECTION 12 T 16 N, R 7 W, TOWN OF MEDARY
LA CROSSE COUNTY

Section 12

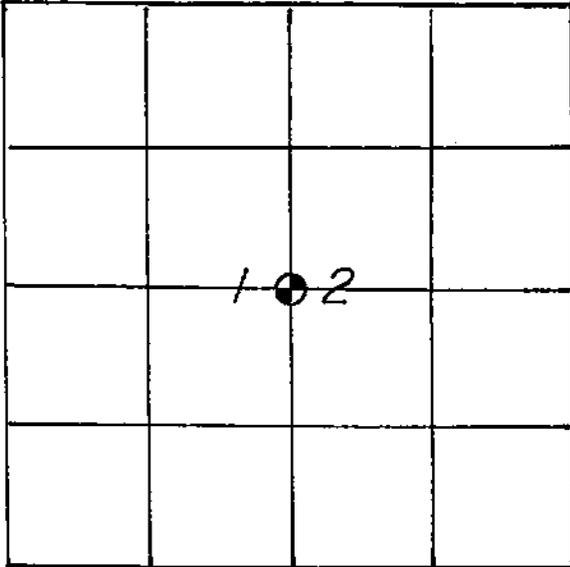

LOCATION OF LANDMARK

CREW:
BILL JUNG
PERRY DAHL
DATE: 8-4-86

WISCONSIN COORDINATE SYSTEM
North
East
Theta Angle
Horiz. Order
Vert. Order
TYPE OF LANDMARK
BRASS CAPPED LUNDE MARKER
BEARINGS ARE REFERENCED TO
True North

Describe any record evidence, monument evidence, testimonial evidence or any other material evidence you considered and whether the monument was found or restored through acceptance of an obliterated evidence location.

I found an iron pipe at the occupied corner, removed it, and replaced it with a Lunde Marker. This iron pipe had been used in previous surveys and was the accepted Center 1/4 Corner.

Describe or show any material discrepancy between the location of the restored corner and that of the corner previously restored or reestablished.


None known.

VOID

RECORD OF DURABLE WITNESS MONUMENTS

NO	DESCRIPTION	BEARING	DISTANCE
1	IRON PIPE IN FENCELINE	WEST±	29.24'
2	IRON PIPE IN FENCELINE	SOUTH±	32.30'
3	Set an iron pipe on the North R/W of North Kinney Coulee Road	True = S0-08-18E	693.96
4			


LANDFILL AREA

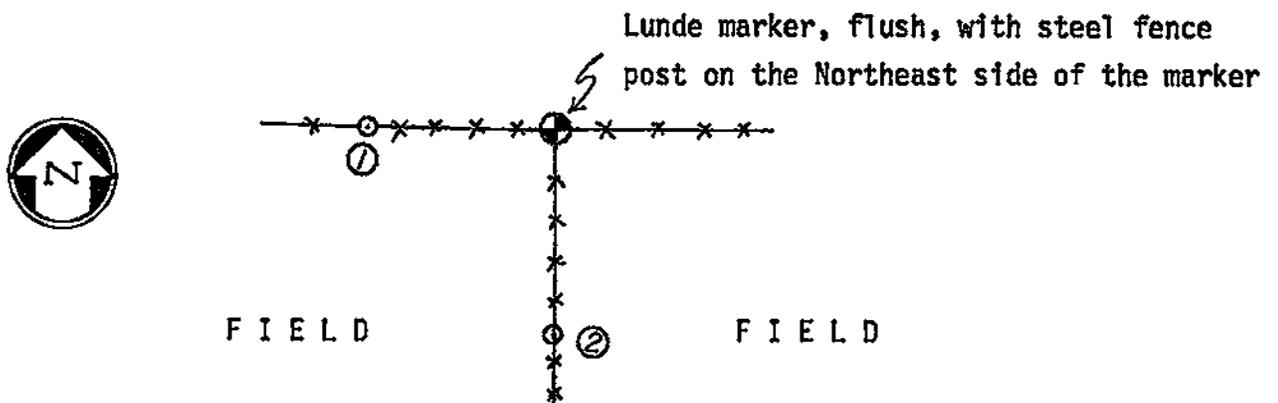

PLAN VIEW DRAWING OF REFERENCE TIES

MAP SHOWING DISTANCE AND DIRECTION TO OTHER PUBLIC LAND SURVEY CORNERS USED FOR REESTABLISHING THE CORNER


(not to scale)

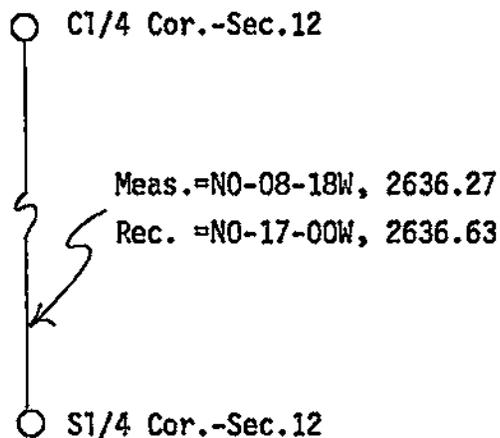

I, William C. Jung, Deputy County Surveyor,
 HEREBY CERTIFY THAT THE CORNER LOCATION SHOWN ON THIS RECORD
 WAS DETERMINED BY ME OR UNDER MY DIRECTION AND CONTROL AND
 THAT THIS U. S. PUBLIC LAND SURVEY MONUMENT RECORD IS CORRECT
 AND COMPLETE TO THE BEST OF MY KNOWLEDGE AND BELIEF.

William C. Jung
 Signature

August 4, 1986
 Date

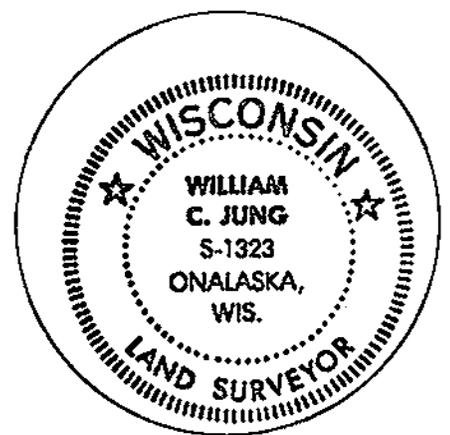

Seal