


U. S. PUBLIC LAND SURVEY MONUMENT RECORD

SECTION 13 T 16 N, R 7 W, TOWN OF MEDARY

LA CROSSE COUNTY

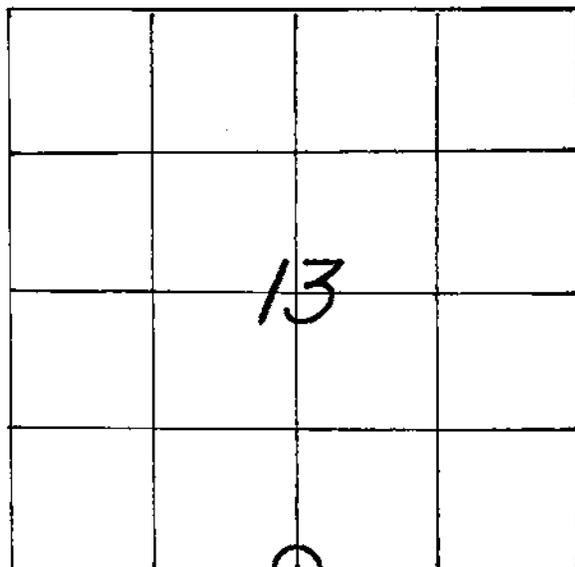

LOCATION OF LANDMARK

CREW: WILLIAM C. JUNG
 PETER F. FOLLANSBEE
 DATE: 2/28/2008

| | |
|-------------------------------------|---------------|
| WISCONSIN COORDINATE SYSTEM | |
| North | 678,425.816 |
| East | 1,662,618.936 |
| Theta Angle | |
| Horiz. Order | |
| Vert. Order | |
| DATUM: | 1983('91) |
| TYPE OF LANDMARK | |
| 1-3/8" IRON PIPE WITH A 2-1/8" TOP. | |
| BEARINGS ARE REFERENCED TO | |
| GRID NORTH AS PER SECTION DATA. | |

Describe any record evidence, monument evidence, testimonial evidence or any other material evidence you considered and whether the monument was found or restored through acceptance of an obliterated evidence location.

We found an iron pipe that had been used in previous survey work as the corner. I accepted it as the best available evidence of the original government corner. The pipe appears to fit the occupied conditions.


Describe or show any material discrepancy between the location of the restored corner and that of the corner previously restored or reestablished.

NONE KNOWN.

RECORD OF DURABLE WITNESS MONUMENTS


ASSUMED

| NO | DESCRIPTION | BEARING | DISTANCE |
|----|--|----------------|------------|
| 1 | EX. 3/4" IRON BAR PROPERTY CORNER | N 89°38'01" W | 841.00 FT. |
| 2 | EX. 1" IRON PIPE PROPERTY CORNER | N 00°42'14" W | 730.99 FT. |
| 3 | SET A PK. NAIL IN N.W.-SIDE OF A 7" ASPEN | N 45° E (MAG.) | 152.10 FT. |
| 4 | EX. 3" THIN WALLED IRON PIPE BY A FENCE POST | SOUTH ± | 184.25 FT. |

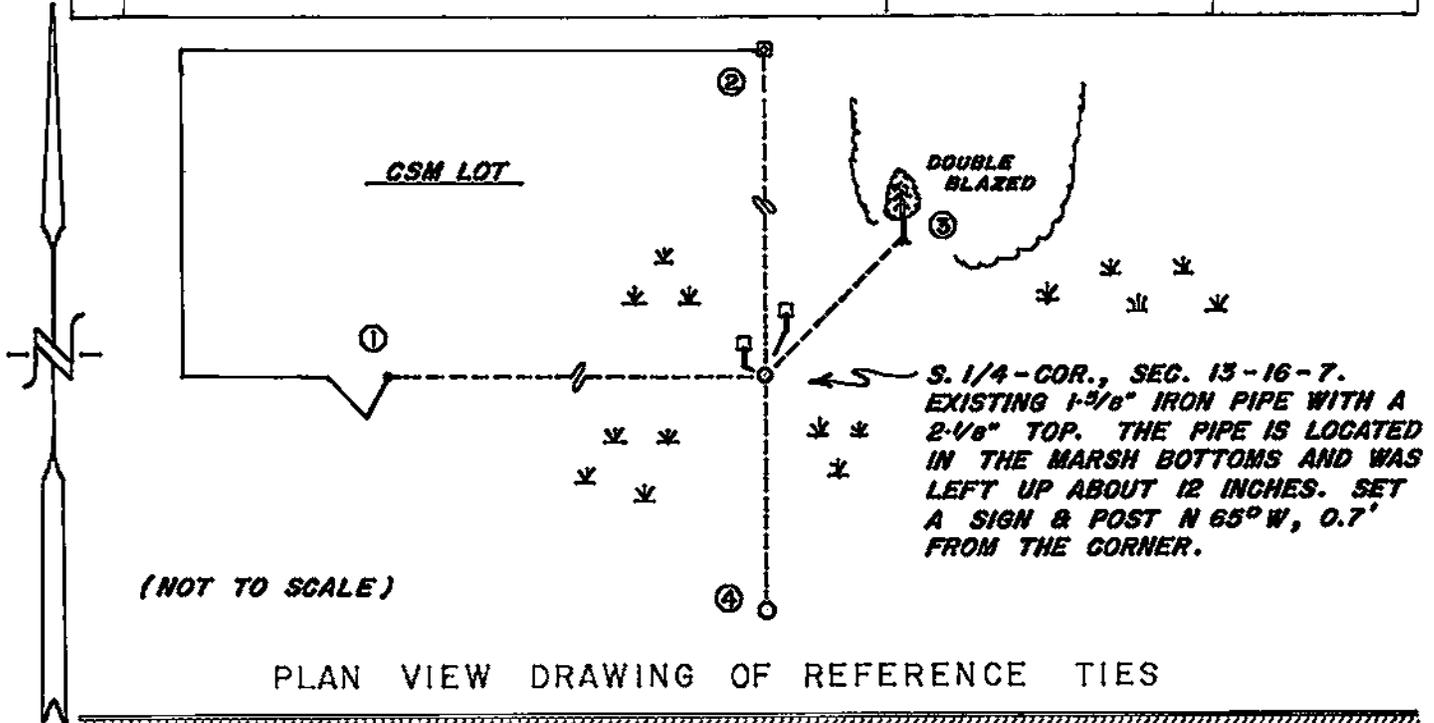


MAP SHOWING DISTANCE AND DIRECTION TO OTHER PUBLIC LAND SURVEY CORNERS USED FOR REESTABLISHING THE CORNER

(GRID BEARINGS AND DISTANCES)
(GRID FACTOR: 0.99994)
(NOT TO SCALE)

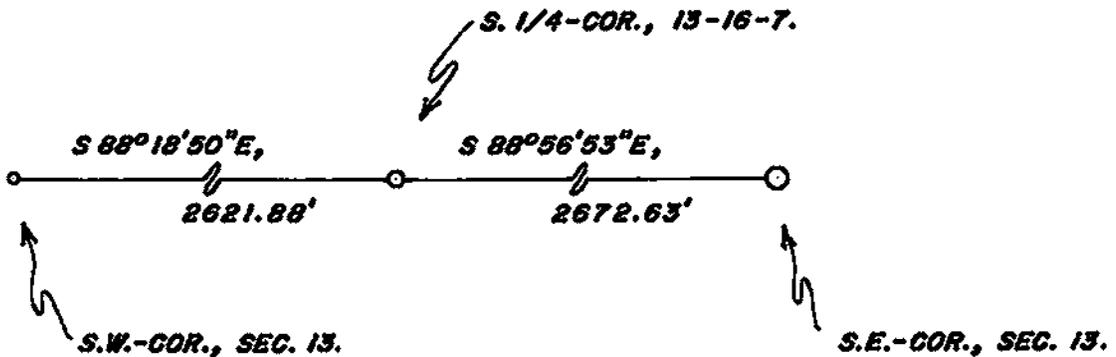

I, WILLIAM C. JUNG, COUNTY SURVEYOR
HEREBY CERTIFY THAT THE CORNER LOCATION SHOWN ON THIS RECORD WAS DETERMINED BY ME OR UNDER MY DIRECTION AND CONTROL AND THAT THIS U. S. PUBLIC LAND SURVEY MONUMENT RECORD IS CORRECT AND COMPLETE TO THE BEST OF MY KNOWLEDGE AND BELIEF.

William C. Jung 11/5/08
Signature Date

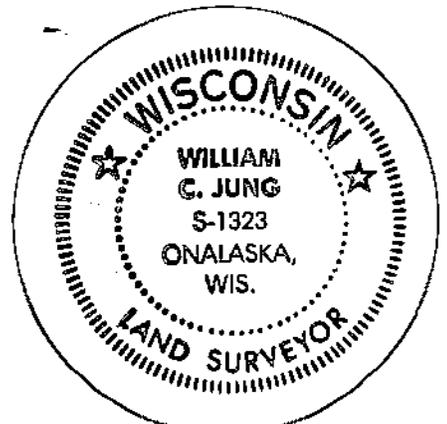

Seal