


## U. S. PUBLIC LAND SURVEY MONUMENT RECORD

SECTION 14 T 16 N, R 7 W, TOWN OF MEDARY  
 LA CROSSE COUNTY

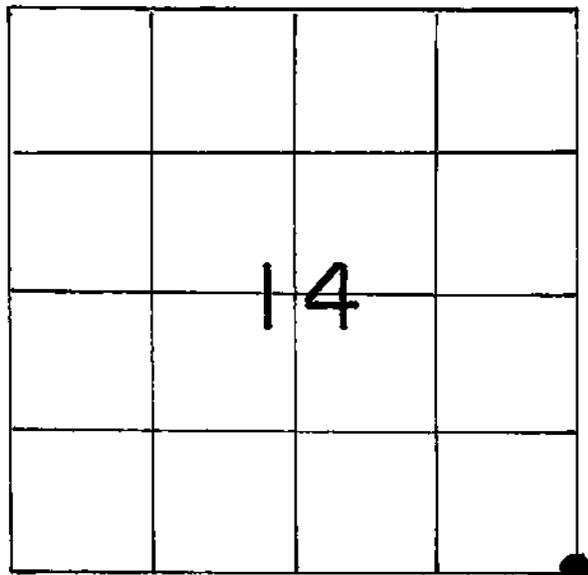

LOCATION OF LANDMARK

Crew: William Jung  
 Perry Dahl  
 11/12/84

## WISCONSIN COORDINATE SYSTEM

North

East

Theta Angle

Horiz. Order

Vert. Order

## TYPE OF LANDMARK

1 1/2" IRON PIPE

BEARINGS ARE REFERENCED TO

Describe any record evidence, monument evidence, testimonial evidence or any other material evidence you considered and whether the monument was found or restored through acceptance of an obliterated evidence location.


I found an iron pipe at the corner that had been used in previous surveys and was of record. I accepted the pipe at the occupied corner as the best available evidence of the original government corner position. I did not set a Berntsen because the pipe is at the North base of the tree. There was supposed to have been a pipe 5 feet North of the corner, but I could not find it. I also found a 18" rotted stump, S16°W, 67.6' (to center), from the corner. It did not however prove to be a bearing tree.

Describe or show any material discrepancy between the location of the restored corner and that of the corner previously restored or reestablished.

None known.

RECORD OF DURABLE WITNESS MONUMENTS  
MAGNETIC

NO	DESCRIPTION	BEARING	DISTANCE
1	Nail in Single-Blazed 17" White Oak	S87°W	26.6'
2	P.K. in Single-Blazed 16" White Oak	-----	.45'
3	Nail in Double-Blazed 9" Hickory	S60°E	36.56'
4	Existing 1 3/4" Iron Pipe	N89°E	84.9'

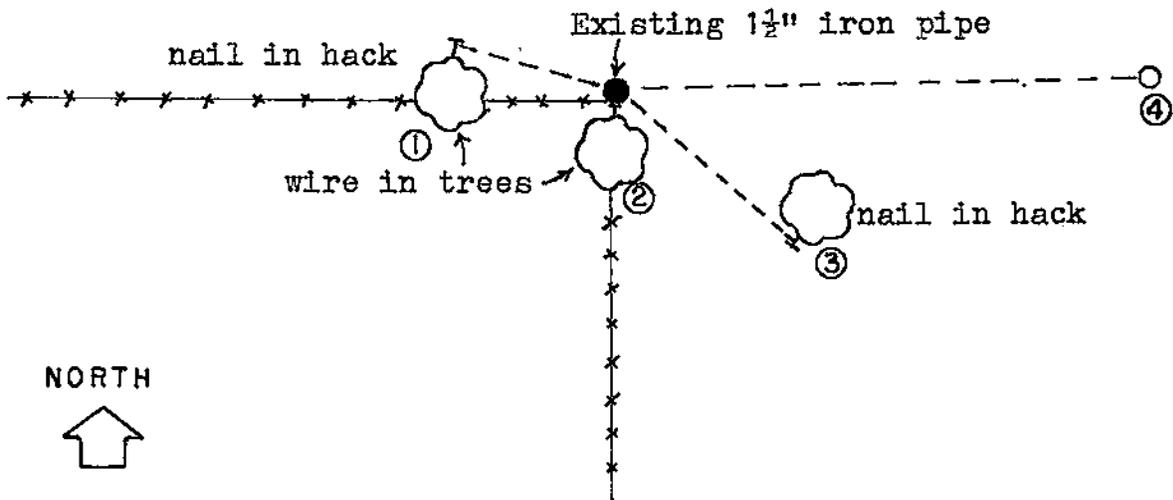

PLAN VIEW DRAWING OF REFERENCE TIES


MAP SHOWING DISTANCE AND DIRECTION TO OTHER PUBLIC LAND SURVEY CORNERS USED FOR REESTABLISHING THE CORNER

No measurements made by me at this time. Refer to maps of record.

I, William C. Jung, Deputy County Surveyor,  
 HEREBY CERTIFY THAT THE CORNER LOCATION SHOWN ON THIS RECORD  
 WAS DETERMINED BY ME OR UNDER MY DIRECTION AND CONTROL AND  
 THAT THIS U. S. PUBLIC LAND SURVEY MONUMENT RECORD IS CORRECT  
 AND COMPLETE TO THE BEST OF MY KNOWLEDGE AND BELIEF.

William C. Jung  
 Signature

2/13/86  
 Date

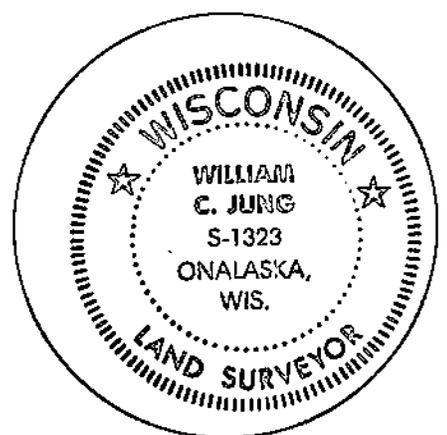

Seal