


## U. S. PUBLIC LAND SURVEY MONUMENT RECORD

SECTION 23 T 16 N, R 7 W, TOWN OF MEDARY  
 LA CROSSE COUNTY

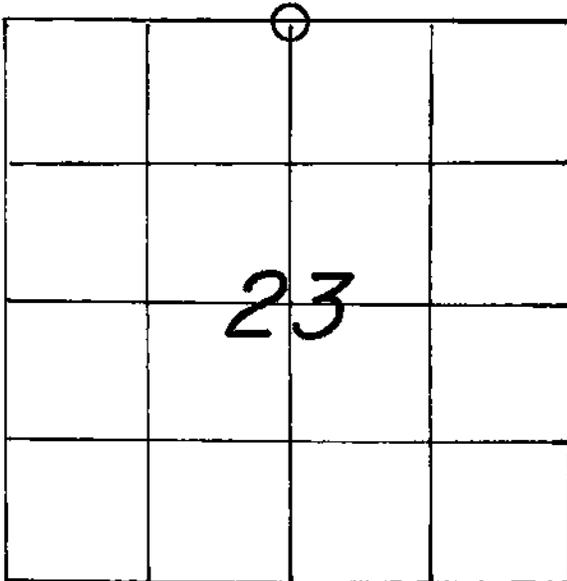

LOCATION OF LANDMARK

## WISCONSIN COORDINATE SYSTEM

North

East

Theta Angle

Horiz. Order

Vert. Order

## TYPE OF LANDMARK

Existing 1½" Iron Pipe in concr.

BEARINGS ARE REFERENCED TO

Crew: WILLIAM C. JUNG  
 PETER F. FOLLANSBEE  
 Date: 5/17/1996

Describe any record evidence, monument evidence, testimonial evidence or any other material evidence you considered and whether the monument was found or restored through acceptance of an obliterated evidence location.

I found an iron pipe at the corner that had been used in many previous surveys as the corner. I accepted this pipe as the best available evidence of the original government corner position.

Describe or show any material discrepancy between the location of the restored corner and that of the corner previously restored or reestablished.


None Known.

**RECORD OF DURABLE WITNESS MONUMENTS  
MAGNETIC**

NO	DESCRIPTION	BEARING	DISTANCE
1	Set P.K. Nail in N.-side 22" Burr Oak	N 84°W	33.39 Ft.
2	Set P.K. Nail in E.-side 7" Burr Oak	N 08°E	42.41 Ft.
3	Set P.K. Nail in NE-side 7" Nut tree	S 36°E	15.82 Ft.
4	Set P.K. Nail in NE-side 8" Nut tree	S 26°E	31.29 Ft.

(Note: the Bearing Trees are unblazed with a P.K. Nail set in a hack mark near the base.)

(Scale: 1" = 30')

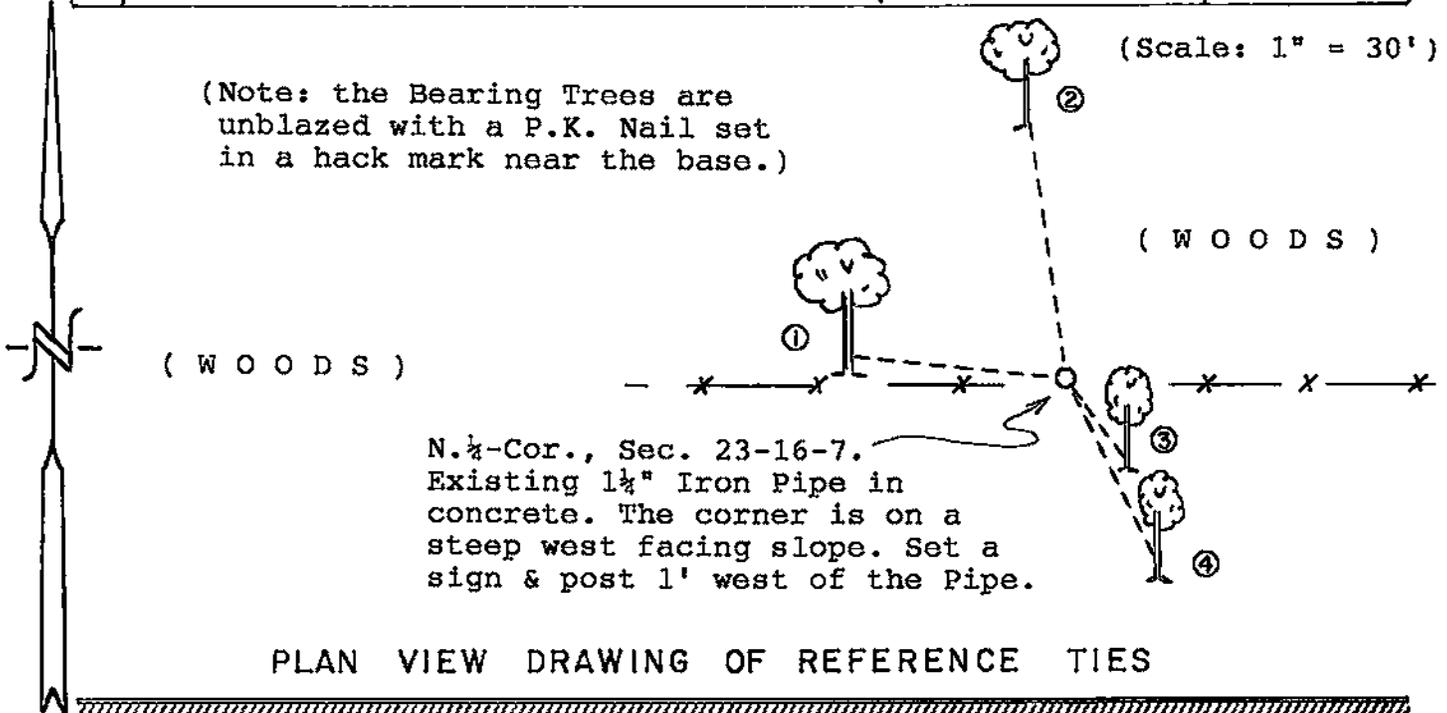


**MAP SHOWING DISTANCE AND DIRECTION TO OTHER PUBLIC LAND SURVEY CORNERS USED FOR REESTABLISHING THE CORNER**

No section measurements were made by me at this time. This position was confirmed by others with previous section measurements.

I, William C. Jung, County Surveyor  
HEREBY CERTIFY THAT THE CORNER LOCATION SHOWN ON THIS RECORD WAS DETERMINED BY ME OR UNDER MY DIRECTION AND CONTROL AND THAT THIS U. S. PUBLIC LAND SURVEY MONUMENT RECORD IS CORRECT AND COMPLETE TO THE BEST OF MY KNOWLEDGE AND BELIEF.

William C. Jung                      10/30/96  
Signature                                      Date

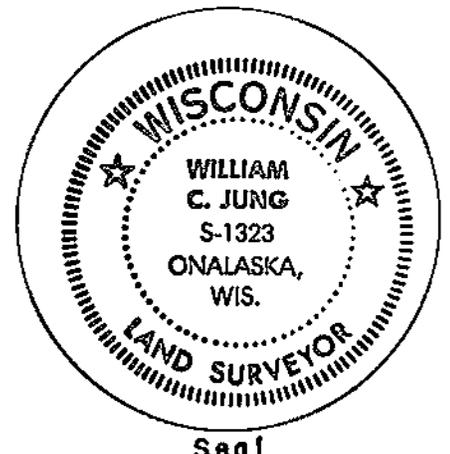

Seal