


U. S. PUBLIC LAND SURVEY MONUMENT RECORD

SECTION 14 T 16 N, R 7 W, TOWN OF MEDARY
LA CROSSE COUNTY

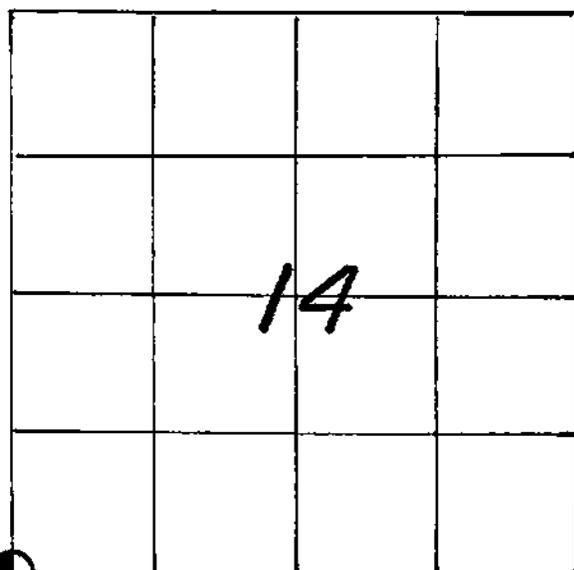

LOCATION OF LANDMARK

Crew: WILLIAM C. JUNG
PETER F. FOLLANSBEE
Date: 5/15/1996

Describe any record evidence, monument evidence, testimonial evidence or any other material evidence you considered and whether the monument was found or restored through acceptance of an obliterated evidence location.

I found an iron pipe at the corner that had been used in many previous surveys as the corner. I accepted this pipe as the best available evidence of the original government corner position and capped it with a brass Lunde marker top.

Describe or show any material discrepancy between the location of the restored corner and that of the corner previously restored or reestablished.

None Known.

WISCONSIN COORDINATE SYSTEM
North
East
Theta Angle
Horiz. Order
Vert. Order
TYPE OF LANDMARK
Brass cap Lunde Top on 2" I.P.
BEARINGS ARE REFERENCED TO

