


21607150020

U. S. PUBLIC LAND SURVEY MONUMENT RECORD

SECTION 15 T 16 N, R 7 W, TOWN OF MEDARY
 LA CROSSE COUNTY

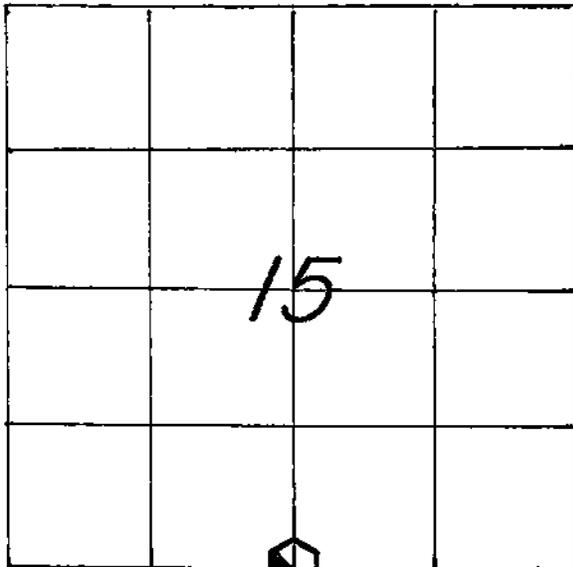

LOCATION OF LANDMARK

CREW: WILLIAM C. JUNG
 PETER F. FOLLANSBEE
 DATE: 8/26/2008

WISCONSIN COORDINATE SYSTEM

North 678,446.032

East 1,652,035.958

Theta Angle

Horiz. Order

Vert. Order

DATUM: 1983('91)

TYPE OF LANDMARK

30" ALUMINUM BERNTSEN MARKER.

BEARINGS ARE REFERENCED TO
 GRID NORTH AS PER SECTION DATA.

Describe any record evidence, monument evidence, testimonial evidence or any other material evidence you considered and whether the monument was found or restored through acceptance of an obliterated evidence location.

There was no evidence of the original government corner. Other surveys of record had assumed a computed single proportionate position for this corner. I agree and set a Berntsen marker at the corner at the single proportionate position.

Describe or show any material discrepancy between the location of the restored corner and that of the corner previously restored or reestablished.

NONE KNOWN.

RECORD OF DURABLE WITNESS MONUMENTS

MAGNETIC

NO	DESCRIPTION	BEARING	DISTANCE
1	SET A NAIL IN S.W.-SIDE OF A 10-1/2" ASPEN	N 45° W	9.37 FT.
2	SET A NAIL IN N.W.-SIDE OF A 10" ASPEN	N 28° E	22.82 FT.
3	SET A NAIL IN N.W.-SIDE OF A 14-1/2" OAK	N 62° E	41.48 FT.
4	SET A NAIL IN S.-SIDE OF A 12-1/2" OAK	EAST ±	30.37 FT.

(NOTE: THE FOUR BEARING TREES ARE DOUBLE BLAZED.)

(W O O D S)

(W O O D S)


S. 1/4-COR., SEC. 15-16-7.
 SET A 30" ALUMINUM BERNTSEN
 MARKER UP APPROX.'LY 12"
 BECAUSE OF ROOTS. SET A SIGN
 & POST TO THE WEST.

(NOT TO SCALE)

PLAN VIEW DRAWING OF REFERENCE TIES

MAP SHOWING DISTANCE AND DIRECTION TO OTHER PUBLIC LAND SURVEY CORNERS USED FOR REESTABLISHING THE CORNER

(GRID BEARINGS AND DISTANCES)
 (GRID FACTOR: 0.99993)
 (NOT TO SCALE)

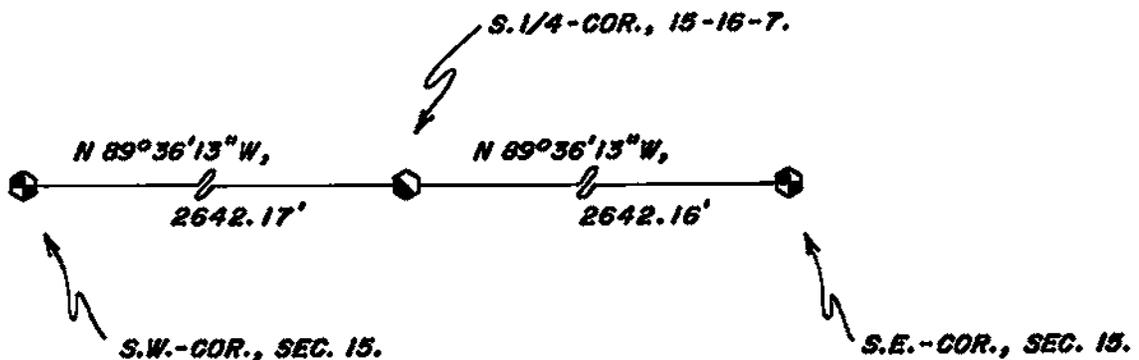

I, WILLIAM C. JUNG, COUNTY SURVEYOR
 HEREBY CERTIFY THAT THE CORNER LOCATION SHOWN ON THIS RECORD
 WAS DETERMINED BY ME OR UNDER MY DIRECTION AND CONTROL AND
 THAT THIS U. S. PUBLIC LAND SURVEY MONUMENT RECORD IS CORRECT
 AND COMPLETE TO THE BEST OF MY KNOWLEDGE AND BELIEF.

William C Jung
 Signature

11/19/08
 Date



Seal