


21607152000

U. S. PUBLIC LAND SURVEY MONUMENT RECORD

SECTION 15 T 16 N, R 7 W, TOWN OF MEDARY

LA CROSSE COUNTY

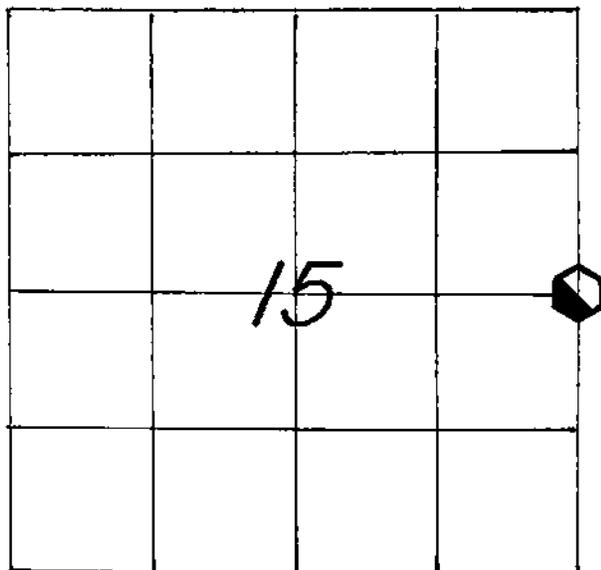

LOCATION OF LANDMARK

CREW: **WILLIAM C. JUNG**
PETER F. FOLLANSBEE
 DATE: **11/03/2008**

WISCONSIN COORDINATE SYSTEM	
North	681,071.118
East	1,654,723.674
Theta Angle	
Horiz. Order	
Vert. Order	
DATUM:	1983('91)
TYPE OF LANDMARK	
30" ALUMINUM BERNTSEN MARKER.	
BEARINGS ARE REFERENCED TO	
GRID NORTH AS PER SECTION DATA.	

Describe any record evidence, monument evidence, testimonial evidence or any other material evidence you considered and whether the monument was found or restored through acceptance of an obliterated evidence location.

This corner is lost and falls in the golf course. I reset it by reconstructing the location of the E1/16SE corner and doubling it over from the southeast corner of Section 15. A Berntsen was set at the corner.

Describe or show any material discrepancy between the location of the restored corner and that of the corner previously restored or reestablished.

NONE KNOWN.


RECORD OF DURABLE WITNESS MONUMENTS

GRID BEARINGS

NO	DESCRIPTION	BEARING	DISTANCE
1	SET A NAIL IN S.-SIDE OF A 46" MAPLE	N 03°43'48" W	73.03 FT.
2	SET A NAIL IN S.W.-SIDE OF A MULTI-TRUNK MAPLE	N 62°57'31" E	157.09 FT.
3	CENTER OF A MANHOLE	N 73°27'04" E	26.68 FT.
4	SET 12" SPIKE AT CENTER NORTH EDGE YARDAGE MARKER	S 55°03'51" E	158.25 FT.

(NOTE: THE TWO BEARING TREES ARE UNBLAZED.)

(NOT TO SCALE)

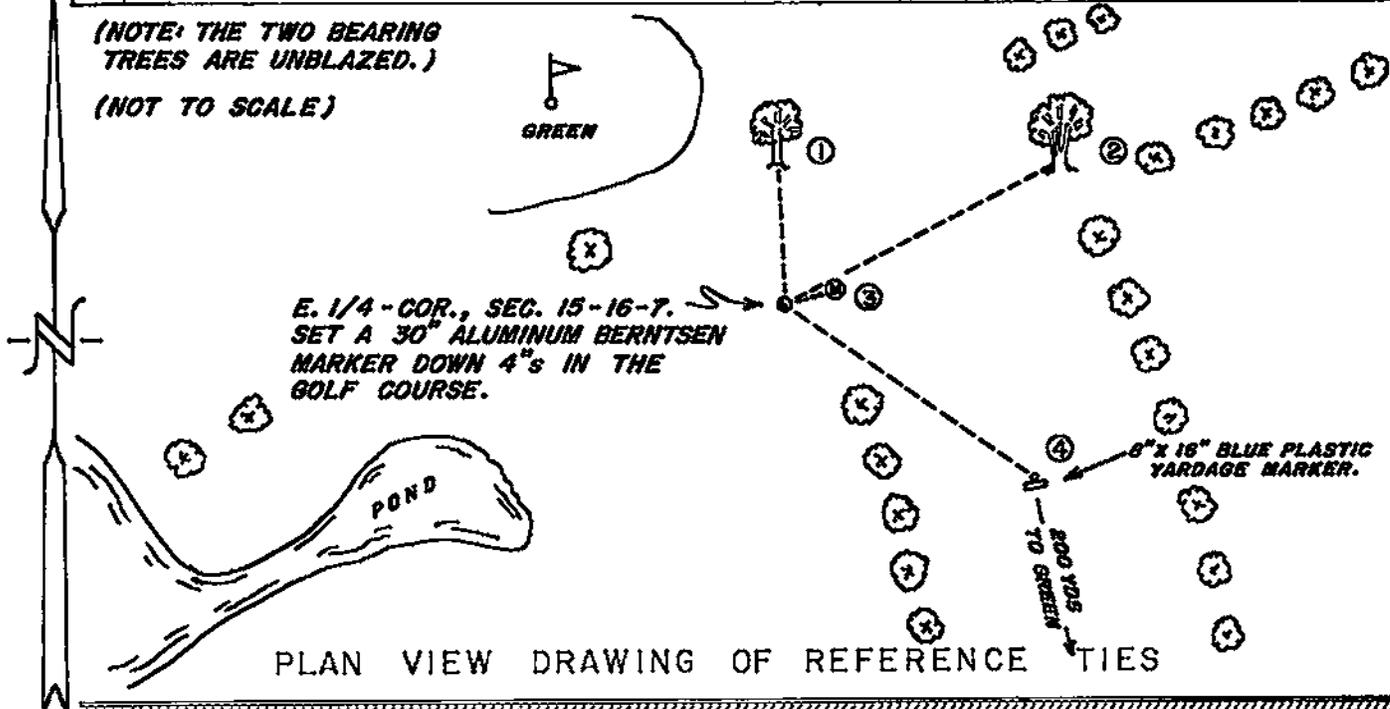


E. 1/4-COR., SEC. 15-16-7.
SET A 30" ALUMINUM BERNTSEN
MARKER DOWN 4" IN THE
GOLF COURSE.

8" x 16" BLUE PLASTIC
YARDAGE MARKER.

PLAN VIEW DRAWING OF REFERENCE TIES

MAP SHOWING DISTANCE AND DIRECTION TO OTHER PUBLIC LAND SURVEY CORNERS USED FOR REESTABLISHING THE CORNER


(GRID BEARINGS AND DISTANCES)
(GRID FACTOR: 0.99993)
(NOT TO SCALE)

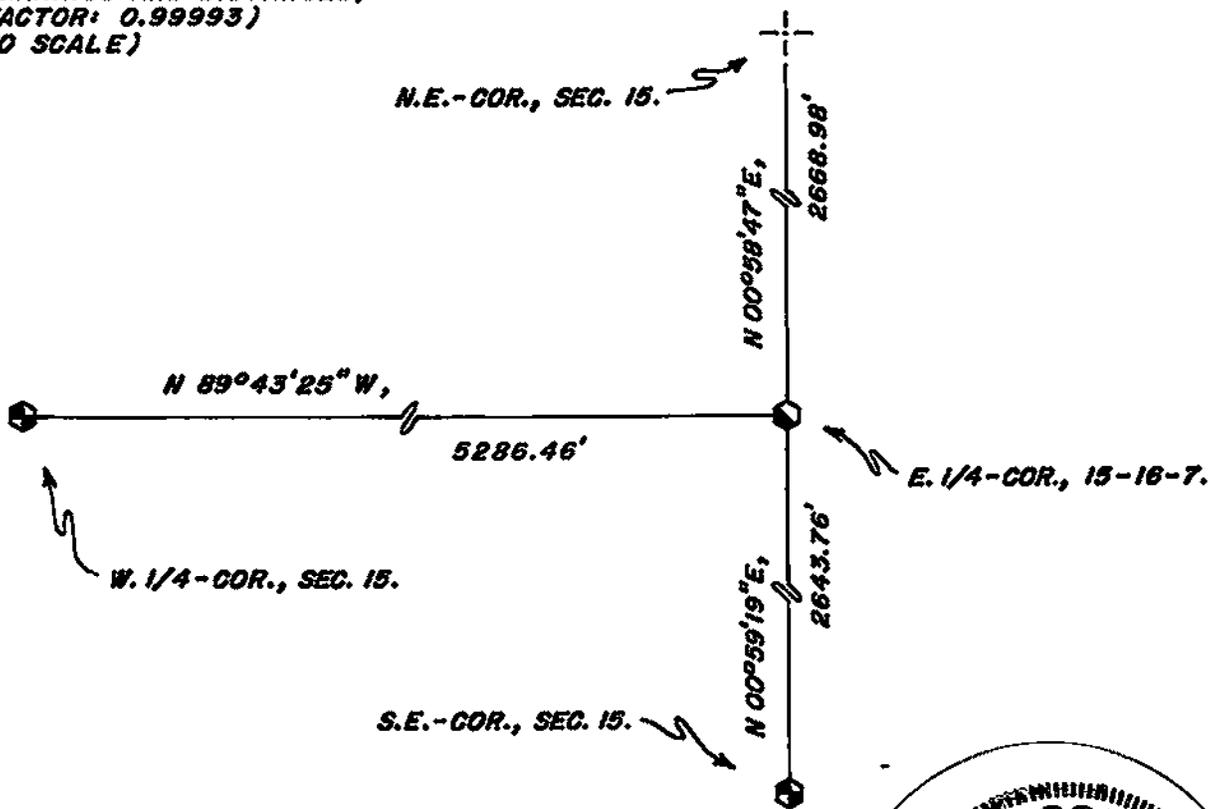

I, WILLIAM C. JUNG, COUNTY SURVEYOR
HEREBY CERTIFY THAT THE CORNER LOCATION SHOWN ON THIS RECORD
WAS DETERMINED BY ME OR UNDER MY DIRECTION AND CONTROL AND
THAT THIS U. S. PUBLIC LAND SURVEY MONUMENT RECORD IS CORRECT
AND COMPLETE TO THE BEST OF MY KNOWLEDGE AND BELIEF.

William C. Jung
Signature

11/20/08
Date

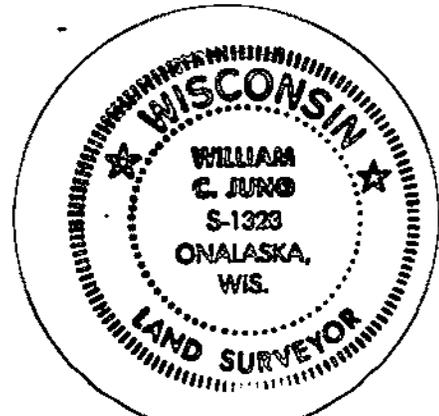

Seal