


21607160000

U. S. PUBLIC LAND SURVEY MONUMENT RECORD

SECTION 21 T 16 N, R 7 W, TOWN OF MEDARY

LA CROSSE COUNTY

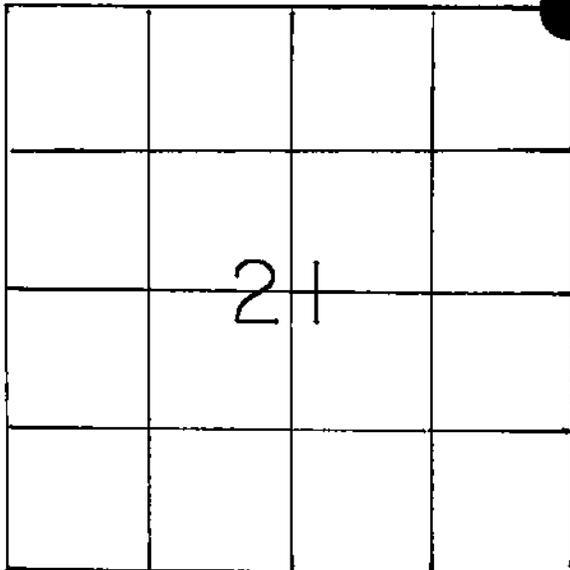

LOCATION OF LANDMARK

CREW: WILLIAM C. JUNG
PETER F. FOLLANSBEE

11-06-1987

Describe any record evidence, monument evidence, testimonial evidence or any other material evidence you considered and whether the monument was found or restored through acceptance of an obliterated evidence location.

There was a pipe at this corner which had been used as the corner in previous surveys. This pipe was destroyed during highway construction but ties were taken to it prior to construction. I reset the corner using these D.O.T. ties and monumented it with a brass capped Lunde marker.

Describe or show any material discrepancy between the location of the restored corner and that of the corner previously restored or reestablished.

NONE KNOWN

WISCONSIN COORDINATE SYSTEM

North 678,467.697 (as per D.O.T.)

East 1,680,920.109

Theta Angle

Horiz. Order

Vert. Order

TYPE OF LANDMARK


SET BRASS CAP LUNDE MARKER (FLUSH)

BEARINGS ARE REFERENCED TO
U.S. HIGHWAY NO. 16 (DIVISION JOB
NO. 5513 & 5530)


TAKEN FROM LAMPMAN PLAT OF SURVEY
MAP NO. "M-145"

RECORD OF DURABLE WITNESS MONUMENTS
MAGNETIC

NO	DESCRIPTION	BEARING	DISTANCE
1	FOUND 1½" IRON PIPE WITH D.O.T. FLUG	N 89°E	57.45 FT.
2	FOUND 1½" IRON PIPE WITH D.O.T. FLUG	N 89°E	100.56 FT.
3	CENTER OF EXISTING MANHOLE COVER	N 41°E	69.80 FT.
4	TOP NUT OF EXISTING FIRE HYDRANT	S 37°W	65.10 FT.

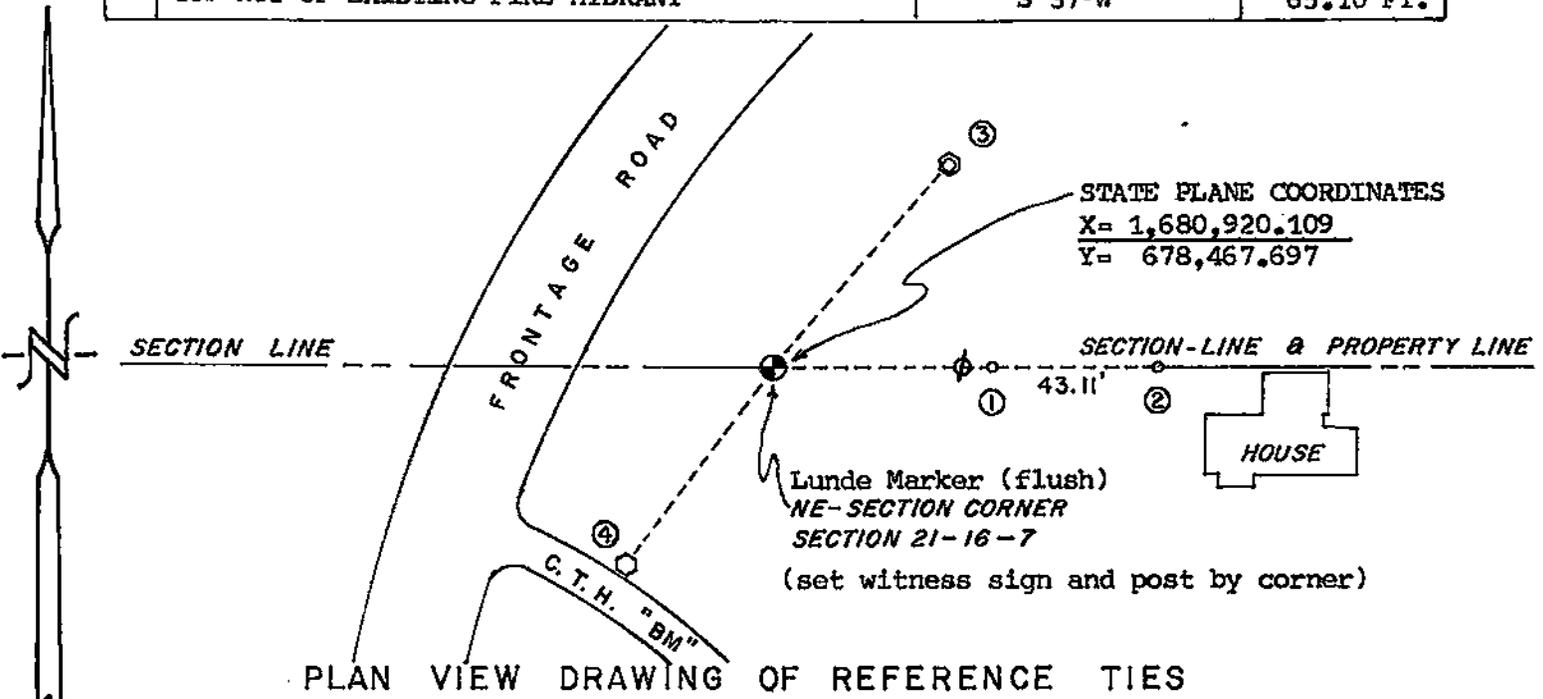


MAP SHOWING DISTANCE AND DIRECTION TO OTHER PUBLIC LAND SURVEY CORNERS USED FOR REESTABLISHING THE CORNER
NOT TO SCALE
LAMPMAN MEASUREMENTS.

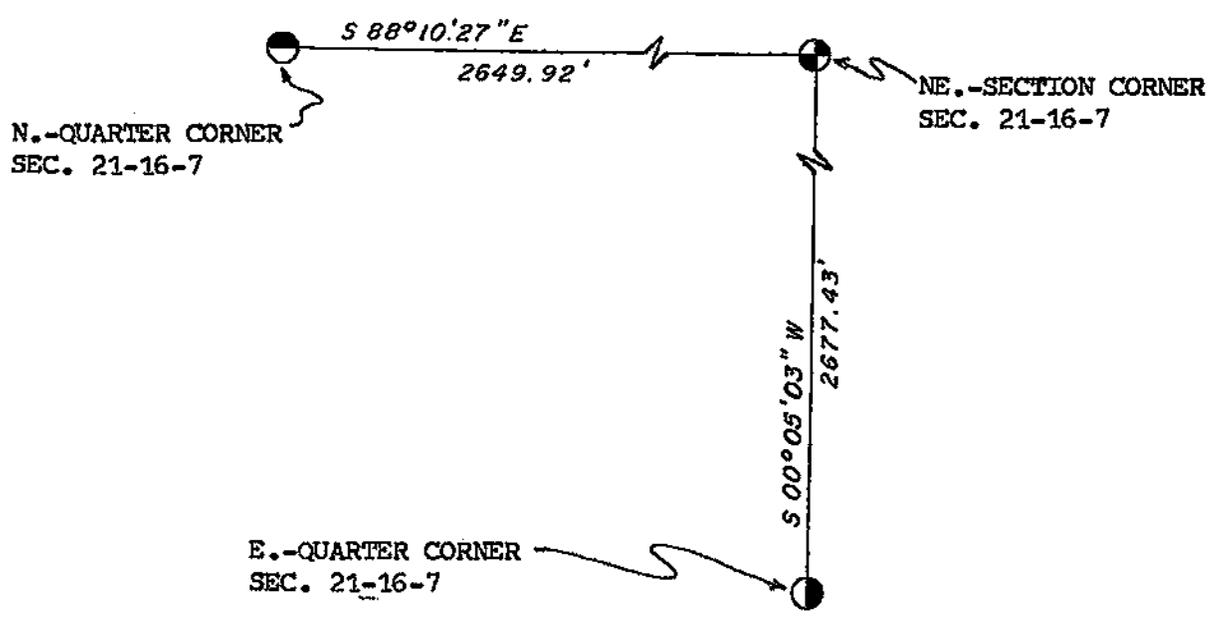

I, WILLIAM C. JUNG
HEREBY CERTIFY THAT THE CORNER LOCATION SHOWN ON THIS RECORD
WAS DETERMINED BY ME OR UNDER MY DIRECTION AND CONTROL AND
THAT THIS U. S. PUBLIC LAND SURVEY MONUMENT RECORD IS CORRECT
AND COMPLETE TO THE BEST OF MY KNOWLEDGE AND BELIEF.

William C. Jung Deputy County Surveyor, December 11, 1987
Signature Date

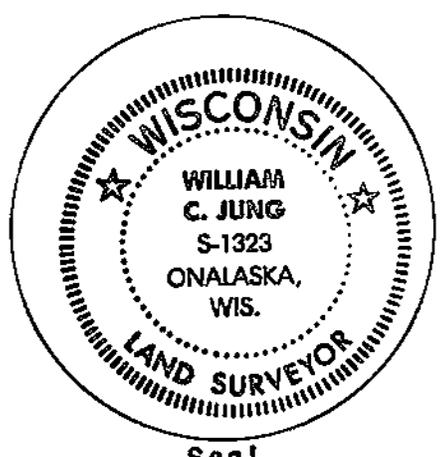

Seal

City of La Crosse


16-7-21-1

CO-168


FIELD SURVEY NOTES
PRESERVATION OF LANDMARKS
(Pursuant to Section 59.635(7) Wisconsin Statutes)

State Highway Commission of Wisconsin
Form E-D-707-88


COUNTY	LACROSSE		
TOWN	MEDARY		
HIGHWAY	S.T.H. 16		
SECTION	TOWNSHIP	RANGE	
21	16 N	7 W	
TYPE OF LANDMARK			
1 1/2" PIPE FOUND.			

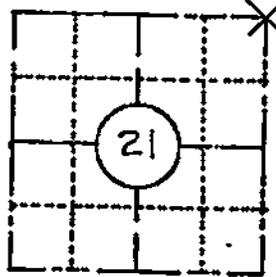

LOCATION SKETCH
(Location of landmark indicated by "x")

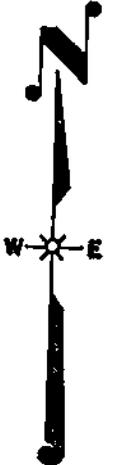

This space for copy of field notes or ties to the above described landmarks

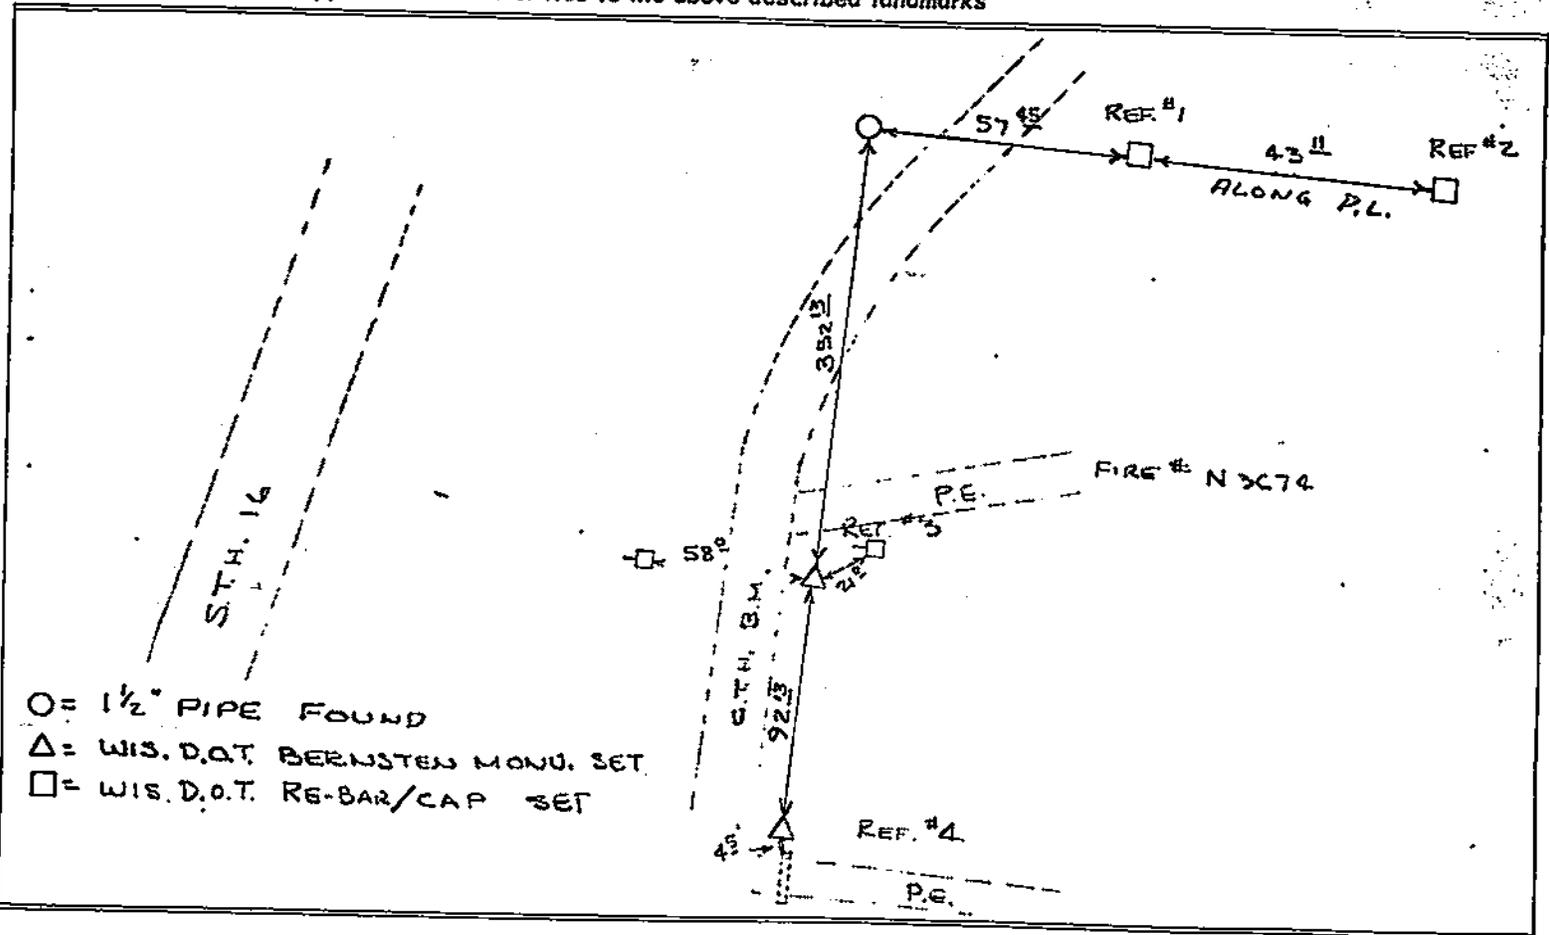

- O = 1 1/2" PIPE FOUND
- Δ = WIS. D.O.T. BERNSTEIN MON. SET
- = WIS. D.O.T. RE-BAR/CAP SET

FILED UNDER PROJECT NUMBER 7575-03-00			COUNTY CLERK'S OFFICE	
SBC DISTRICT OFFICE NUMBER 5		CITY LACROSSE	COUNTY LACROSSE	COUNTY OF WISCONSIN } 59
LOCATED OR ESTABLISHED BY			DATE RECEIVED FOR RECORD	DATE COPY SENT TO COUNTY SURVEYOR
NAME DERALD E. KADINSG #1064			SIGNATURE OF COUNTY CLERK	
TITLE SURVEY COORDINATOR DATE 8-22-84				