


21607160020

U. S. PUBLIC LAND SURVEY MONUMENT RECORD

SECTION 21 T 16 N, R 7 W, TOWN OF CITY OF LA CROSSE
LA CROSSE COUNTY

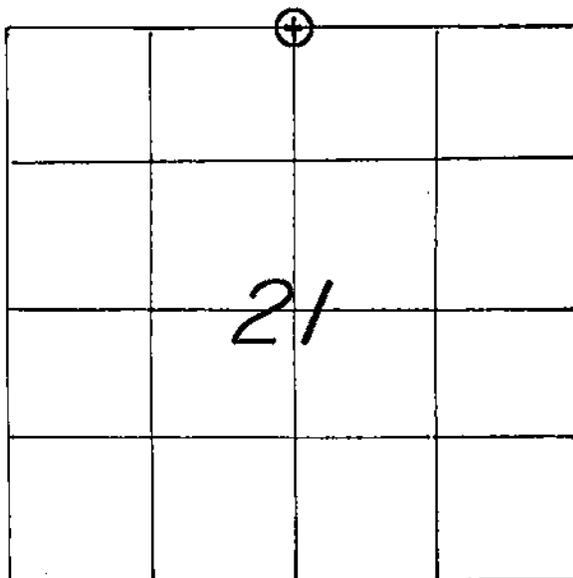

WISCONSIN COORDINATE SYSTEM

North

East

Theta Angle

Horiz. Order

Vert. Order

TYPE OF LANDMARK

3/4" x 30" IRON BAR WITH AN ALUMINUM CAP

BEARINGS ARE REFERENCED TO

Grid

LOCATION OF LANDMARK

CREW: WILLIAM C. JUNG

PETER F. FOLLANSBEE, DAN P. LEIS.

DATE: 3/12/1999

Describe any record evidence, monument evidence, testimonial evidence or any other material evidence you considered and whether the monument was found or restored through acceptance of an obliterated evidence location.


I found a bent iron pipe at the corner. This pipe had been used as the corner in many previous surveys. I accepted it as the best available evidence of the original government corner position. Leaving the bent pipe in, I set a 3/4"x30" iron bar with a cap at the corner.

Describe or show any material discrepancy between the location of the restored corner and that of the corner previously restored or reestablished.

NONE KNOWN.


RECORD OF DURABLE WITNESS MONUMENTS
MAGNETIC

| NO | DESCRIPTION | BEARING | DISTANCE |
|----|--|---------|-----------|
| 1 | SET A 3/4" x 30" IRON BAR ON EAST SLOPE OF BERM. | N 02° E | 33.15 FT. |
| 2 | SET A 1-1/4" x 27" IRON PIPE NEAR EDGE OF FIELD ROAD | S 60° E | 52.76 FT. |
| 3 | CENTER OF EXISTING MANHOLE COVER | S 04° W | 60.48 FT. |
| 4 | CENTER OF EXISTING WATER MANHOLE COVER | S 25° W | 42.71 FT. |

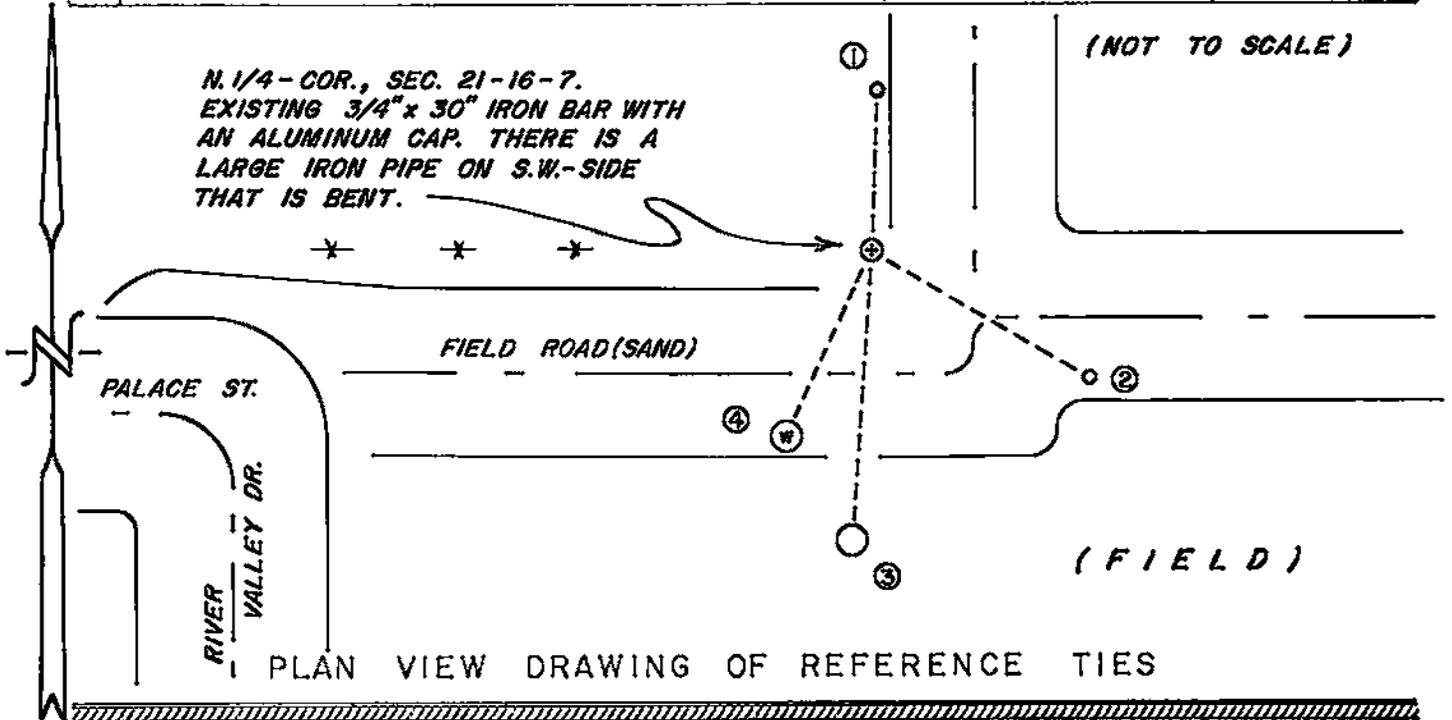

MAP SHOWING DISTANCE AND DIRECTION TO OTHER PUBLIC LAND SURVEY CORNERS USED FOR REESTABLISHING THE CORNER

(not to scale)

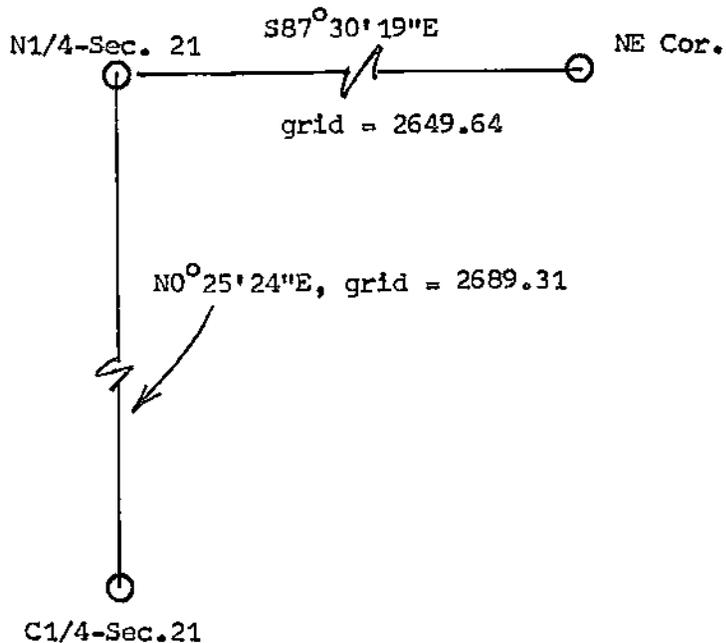

I, WILLIAM C. JUNG, COUNTY SURVEYOR
HEREBY CERTIFY THAT THE CORNER LOCATION SHOWN ON THIS RECORD WAS DETERMINED BY ME OR UNDER MY DIRECTION AND CONTROL AND THAT THIS U. S. PUBLIC LAND SURVEY MONUMENT RECORD IS CORRECT AND COMPLETE TO THE BEST OF MY KNOWLEDGE AND BELIEF.

William C. Jung 5/17/99
Signature Date



Seal