


U. S. PUBLIC LAND SURVEY MONUMENT RECORD

SECTION 16 T 16 N, R 7 W, CITY LACROSSE TOWN OF LACROSSE

LA CROSSE COUNTY

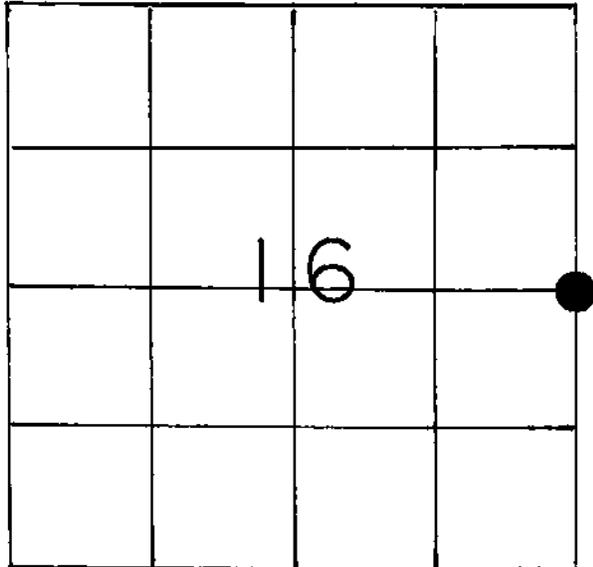

LOCATION OF LANDMARK

Crew: William C. Jung

Peter F. Follansbee

Date: March 17, 1988 & 4/16/07

Describe any record evidence, monument evidence, testimonial evidence or any other material evidence you considered and whether the monument was found or restored through acceptance of an obliterated evidence location.

In March of 1979 Greg Hofmeister set an iron pipe at this corner, setting it on line and equidistant between the section corners. This pipe was apparently destroyed during utility construction. I could not find it nor could Wil Clark. Wil Clark traversed the East line of Section 16 and recomputed Hofmeister's corner location. He spotted this location for me, and I monumented it with a brass capped Lunde marker.

Describe or show any material discrepancy between the location of the restored corner and that of the corner previously restored or reestablished.

None known.

WISCONSIN COORDINATE SYSTEM

North

East

Theta Angle

Horiz. Order

Vert. Order

TYPE OF LANDMARK


Brass Capped Lunde Marker

BEARINGS ARE REFERENCED TO

Grid North as per D.O.T. and Hofmeister survey

RECORD OF DURABLE WITNESS MONUMENTS


NO	DESCRIPTION	BEARING	DISTANCE
1	Center of manhole cover	-----	8.48
2	Center of fence corner post, centerline 31' East of	-----	52.80
3	Center of gas valve	-----	51.43
4			

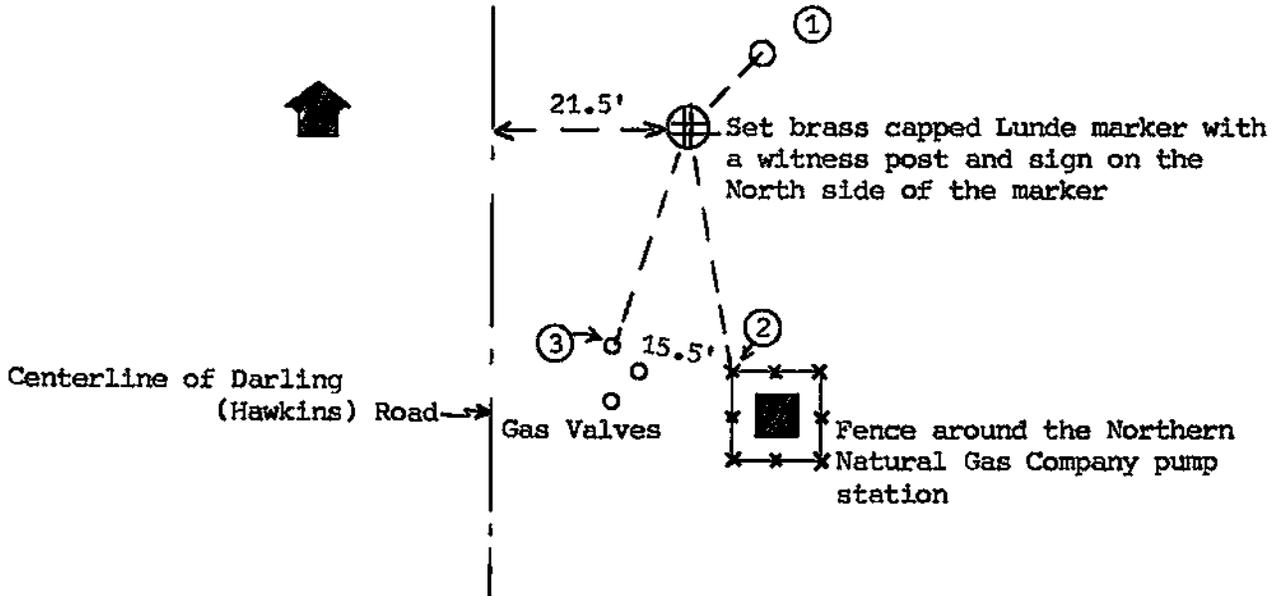

PLAN VIEW DRAWING OF REFERENCE TIES

MAP SHOWING DISTANCE AND DIRECTION TO OTHER PUBLIC LAND SURVEY CORNERS USED FOR REESTABLISHING THE CORNER


(not to scale)

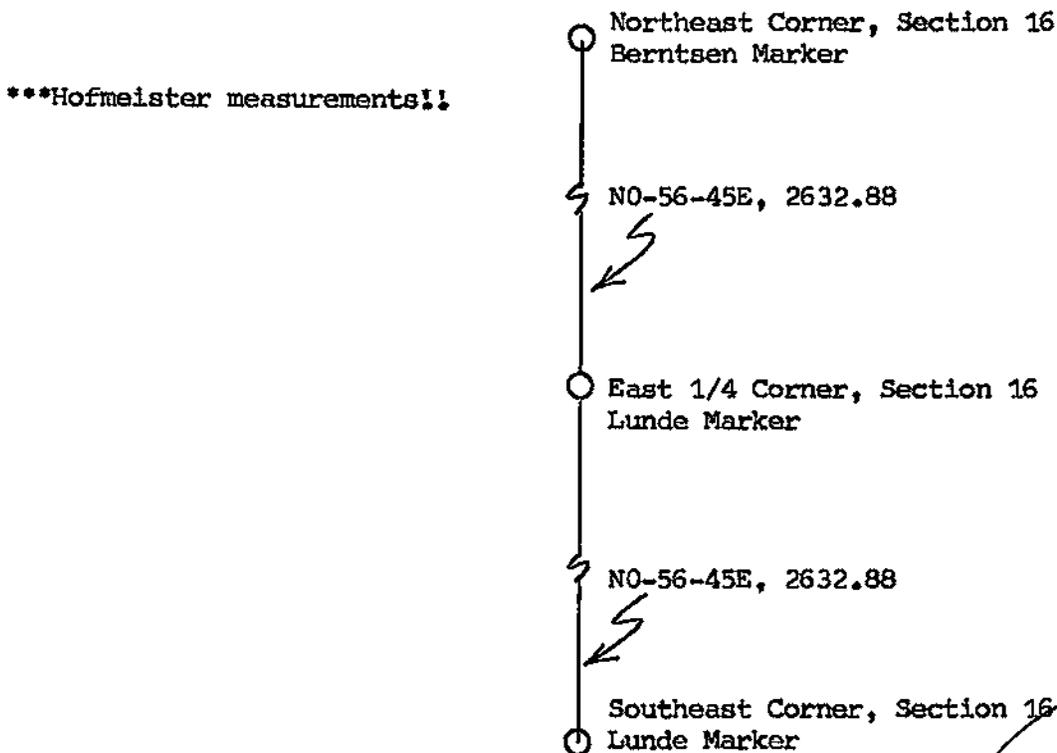

I, William C. Jung, Deputy County Surveyor
 HEREBY CERTIFY THAT THE CORNER LOCATION SHOWN ON THIS RECORD
 WAS DETERMINED BY ME OR UNDER MY DIRECTION AND CONTROL AND
 THAT THIS U. S. PUBLIC LAND SURVEY MONUMENT RECORD IS CORRECT
 AND COMPLETE TO THE BEST OF MY KNOWLEDGE AND BELIEF.

William C. Jung
 Signature


March 29, 1988
 Date

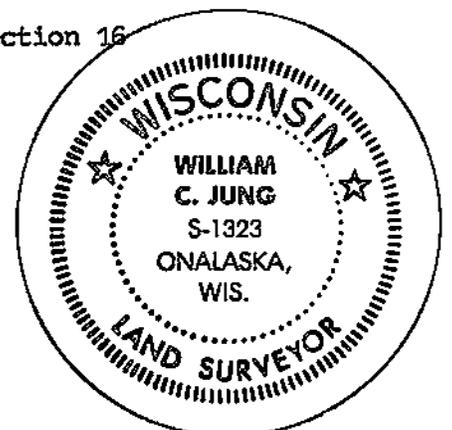

Seal

Tie Sheet, City of La Crosse

Section 16 Township 16 N Range 7 W

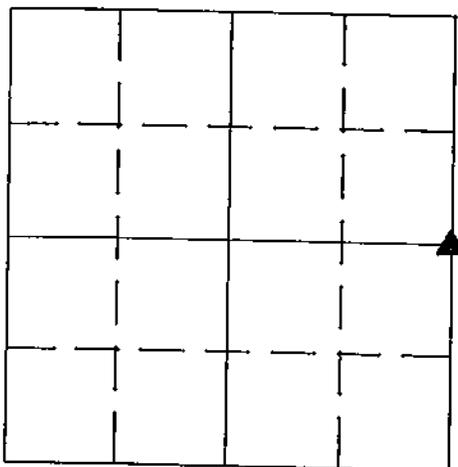


Project Section Corner
 Sta No _____
 Monument _____
 Coord. System _____
 North _____
 East _____
 Elev _____
 Surveyor County

Comments:

Date _____

Space for copy of field notes or ties to above described monument:

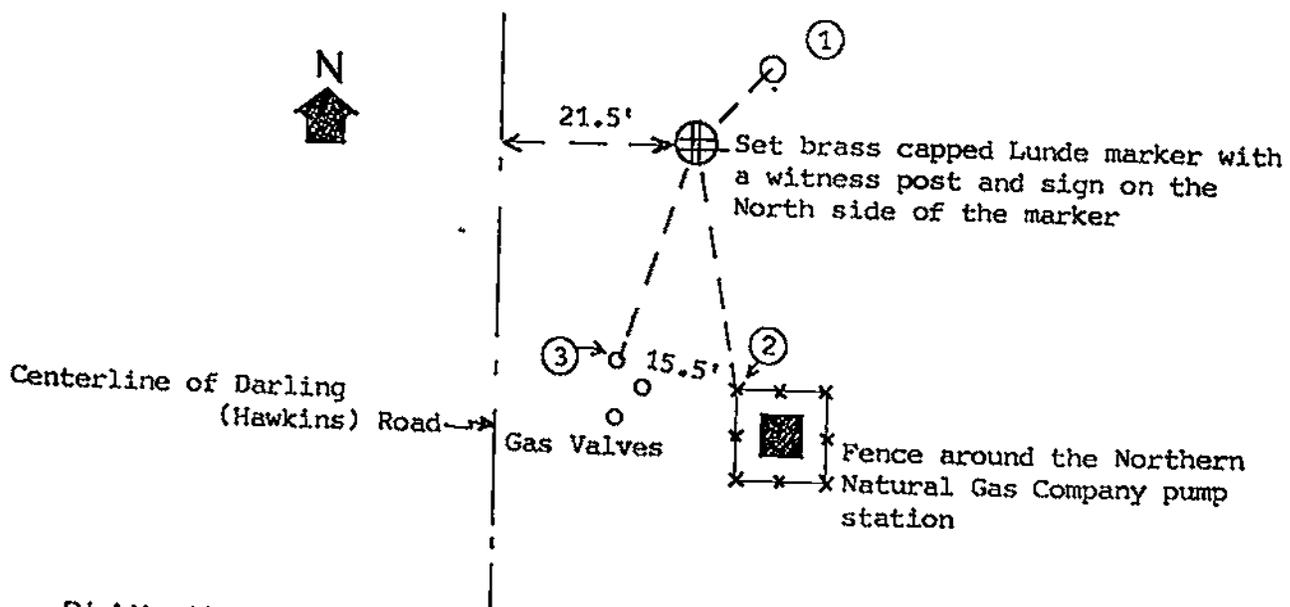

PLAN VIEW DRAWING OF REFERENCE TIES

MAP SHOWING DISTANCE AND DIRECTION TO OTHER PUBLIC LAND
 SURVEY CORNERS USED FOR REESTABLISHING THE CORNER