


U. S. PUBLIC LAND SURVEY MONUMENT RECORD

SECTION 16 T 16 N, R 7 W, ~~TOWN OF~~ CITY OF LACROSSE
LA CROSSE COUNTY

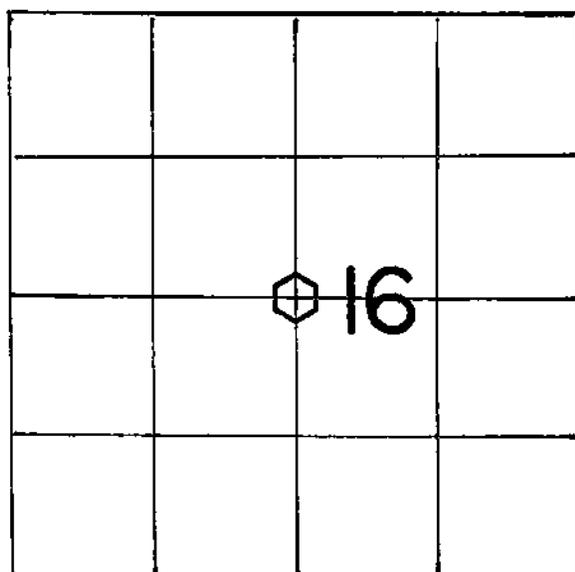

LOCATION OF LANDMARK

Crew: WILLIAM C. JUNG

Date: 7/20/1993

Describe any record evidence, monument evidence, testimonial evidence or any other material evidence you considered and whether the monument was found or restored through acceptance of an obliterated evidence location.

I found an iron pipe at the center of section , removed it, and replaced it with a brass capped Lunde marker.

Describe or show any material discrepancy between the location of the restored corner and that of the corner previously restored or reestablished.

None Known

WISCONSIN COORDINATE SYSTEM

North

East

Theta Angle

Horiz. Order

Vert. Order


TYPE OF LANDMARK

Set brass cap Lunde marker.

BEARINGS ARE REFERENCED TO

Tie Sheet, City of La Crosse

Section 16 Township 16 N Range 7 W

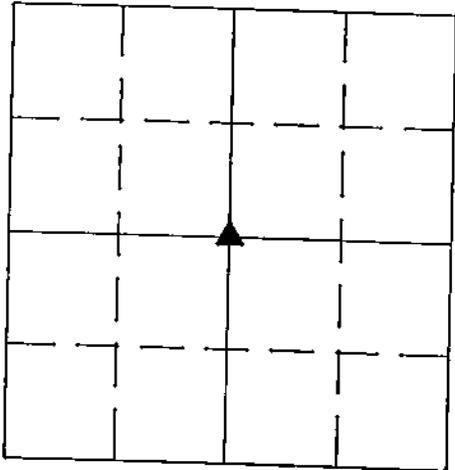


Project Section Corner
 Sta No _____
 Monument _____
 Coord. System _____
 North _____
 East _____
 Elev _____
 Surveyor County

Comments:

Date _____

Space for copy of field notes or ties to above described monument:

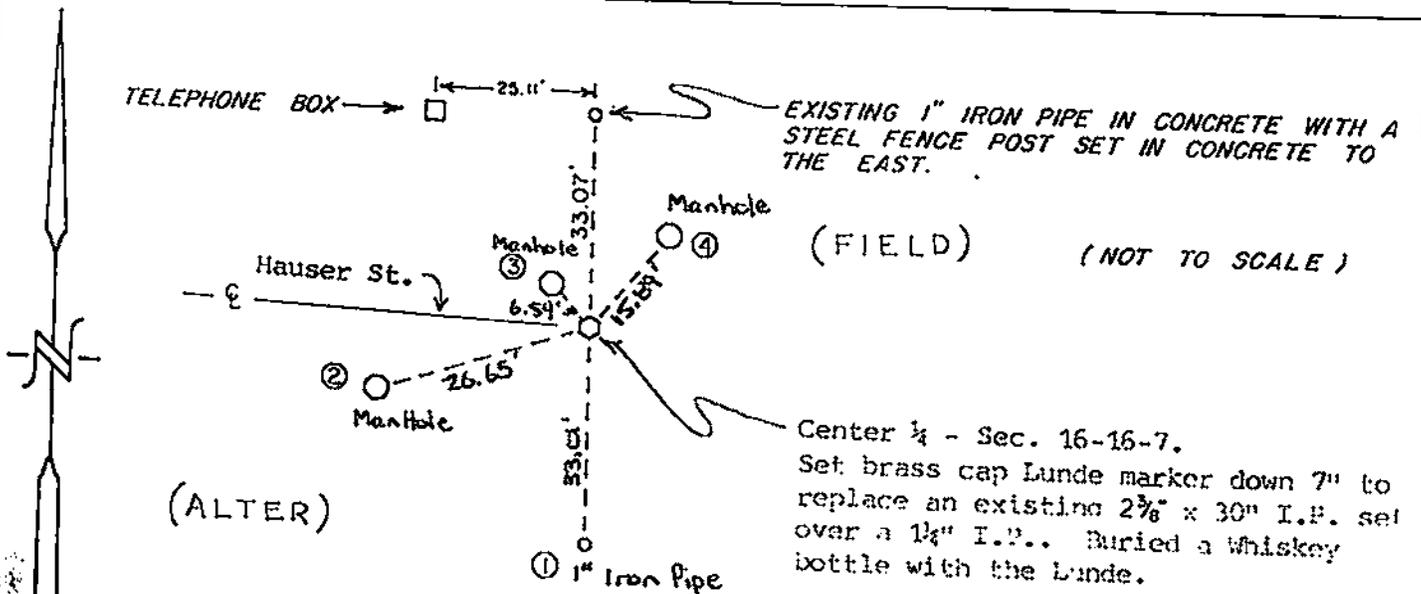

PLAN VIEW DRAWING OF REFERENCE TIES

MAP SHOWING DISTANCE AND DIRECTION TO OTHER PUBLIC LAND SURVEY CORNERS USED FOR REESTABLISHING THE CORNER