


21607180020

U. S. PUBLIC LAND SURVEY MONUMENT RECORD

SECTION 18 T 16 N, R 7 W, TOWN OF CAMPBELL

LA CROSSE COUNTY

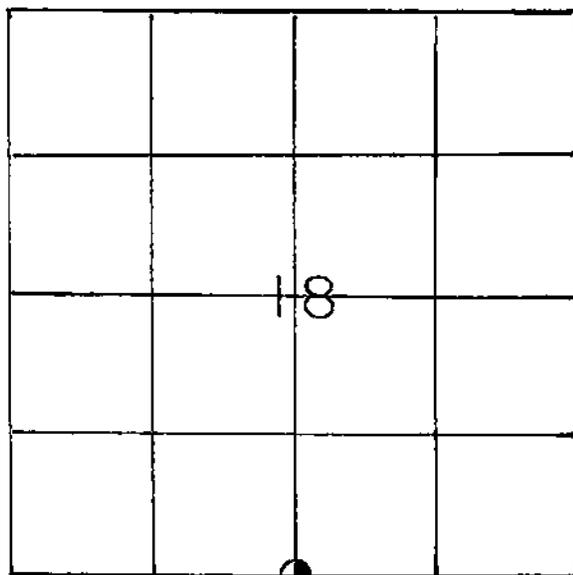

LOCATION OF LANDMARK

CREW:

BILL JUNG, PERRY DAHL

DATE: 9-24-86

REVISED: 9-9-88

Describe any record evidence, monument evidence, testimonial evidence or any other material evidence you considered and whether the monument was found or restored through acceptance of an obliterated evidence location.

I found an iron pipe at the corner that had been used as the corner in previous surveys and accepted this pipe as the best available evidence of the original government corner position.

Describe or show any material discrepancy between the location of the restored corner and that of the corner previously restored or reestablished.

None known.

WISCONSIN COORDINATE SYSTEM

North

East

Theta Angle

Horiz. Order

Vert. Order

TYPE OF LANDMARK


1" IRON PIPE

BEARINGS ARE REFERENCED TO

Assumed


RECORD OF DURABLE WITNESS MONUMENTS

NO	DESCRIPTION	BEARING	DISTANCE
1	CENTERLINE OF N. BAINBRIDGE ST.	---	182' ±
2	CENTER OF STREET SIGN POST	---	29.6'
3	P.K. NAIL IN UNBLAZED 24" MAPLE TREE	---	82.94'
4	CENTER OF MANHOLE COVER	---	2.57'
5	EXISTING IRON PIPE IN CONCRETE	---	47.79

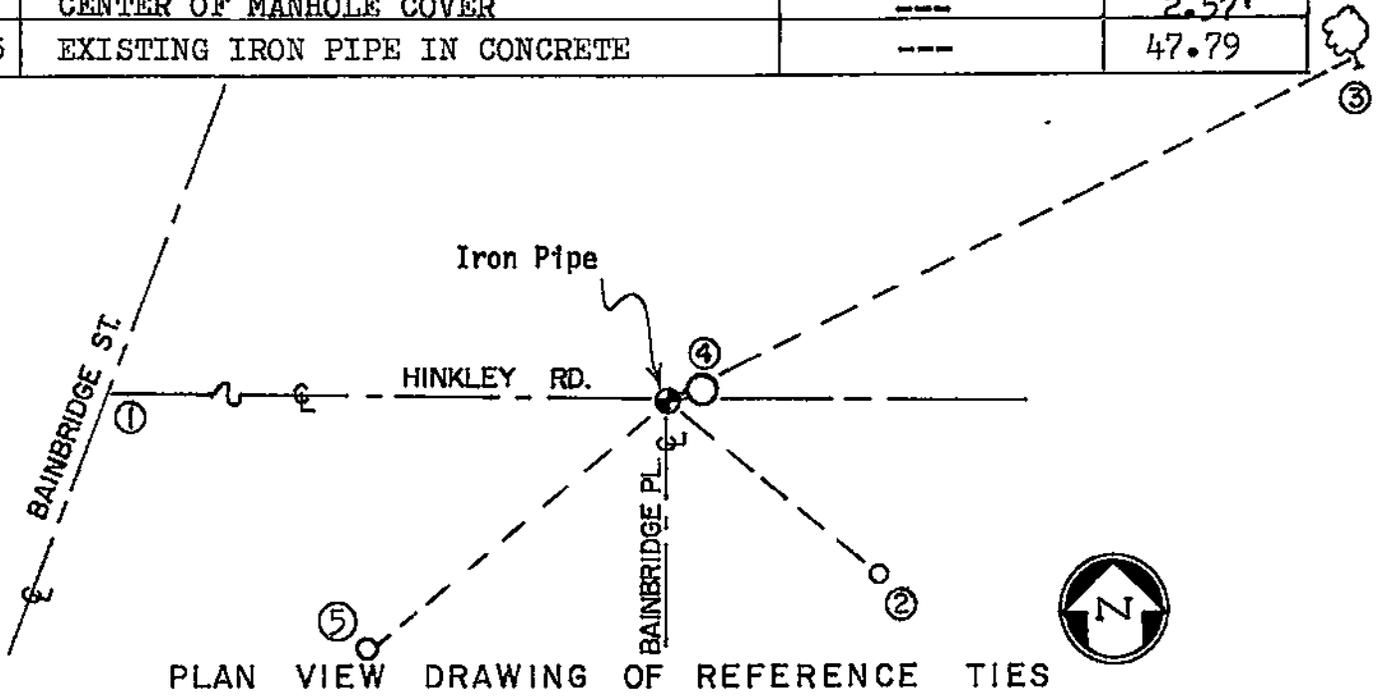

MAP SHOWING DISTANCE AND DIRECTION TO OTHER PUBLIC LAND SURVEY CORNERS USED FOR REESTABLISHING THE CORNER


(not to scale)

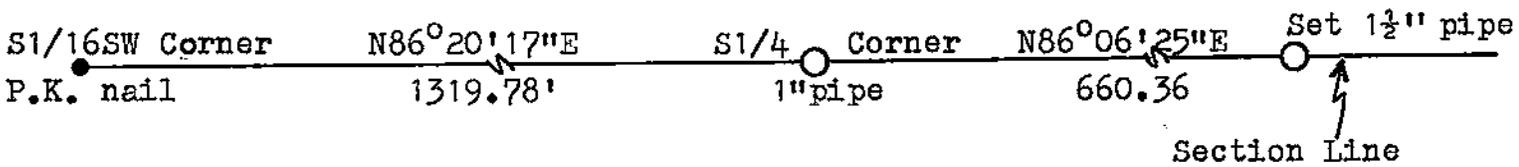

I, WILLIAM C. JUNG, Deputy County Surveyor,
HEREBY CERTIFY THAT THE CORNER LOCATION SHOWN ON THIS RECORD
WAS DETERMINED BY ME OR UNDER MY DIRECTION AND CONTROL AND
THAT THIS U. S. PUBLIC LAND SURVEY MONUMENT RECORD IS CORRECT
AND COMPLETE TO THE BEST OF MY KNOWLEDGE AND BELIEF.

William C. Jung
Signature

Revised: 9/9/88
September 24, 1986
Date

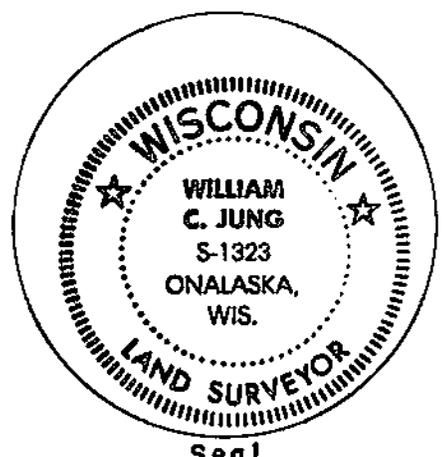

Seal