


21607200000

U. S. PUBLIC LAND SURVEY MONUMENT RECORD

SECTION 21 T 16 N, R 7 W, CITY OF LA CROSSE

LA CROSSE COUNTY

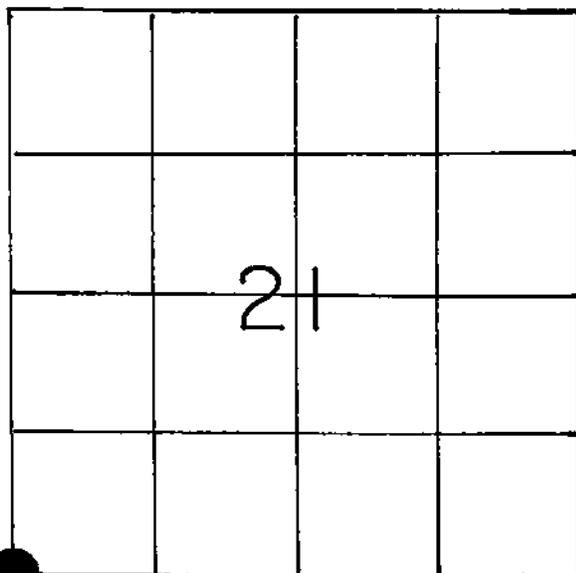

LOCATION OF LANDMARK

Crew: WILLIAM C. JUNG
PETER F. FOLLANSBEE

Date: 8/24/1988

Describe any record evidence, monument evidence, testimonial evidence or any other material evidence you considered and whether the monument was found or restored through acceptance of an obliterated evidence location.

Clark and Logan found and used an iron pipe at this corner. I tied off this pipe. Lampman shows a railroad rail at this corner, but measurements would indicate that the pipe is at the same location as that shown by Lampman.

Describe or show any material discrepancy between the location of the restored corner and that of the corner previously restored or reestablished.

NONE KNOWN

WISCONSIN COORDINATE SYSTEM

North

East

Theta Angle

Horiz. Order

Vert. Order

TYPE OF LANDMARK


EXISTING 1 3/4" IRON PIPE

BEARINGS ARE REFERENCED TO

U.S. Highway No. 16 (Division
Job 5513 & 5530)Taken from Lampman Plat of
Survey Map No. "M-145"


RECORD OF DURABLE WITNESS MONUMENTS

NO	DESCRIPTION	BEARING	DISTANCE
1	NW-Corner of building entrance way	South \pm	30.06 Ft.
2	NE-Corner of warehouse building	Southeast \pm	257.75 Ft.
3	Existing iron pipe in swamp	East \pm	361.70 Ft.
4			

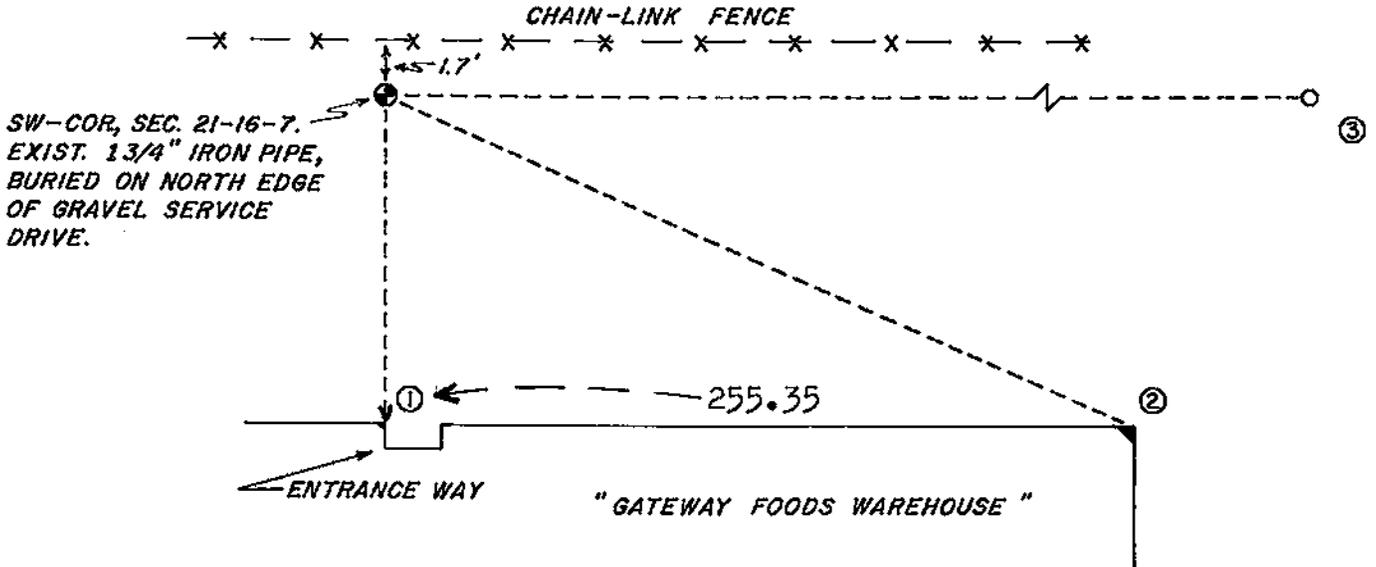

PLAN VIEW DRAWING OF REFERENCE TIES


MAP SHOWING DISTANCE AND DIRECTION TO OTHER PUBLIC LAND SURVEY CORNERS USED FOR REESTABLISHING THE CORNER
(not to scale)

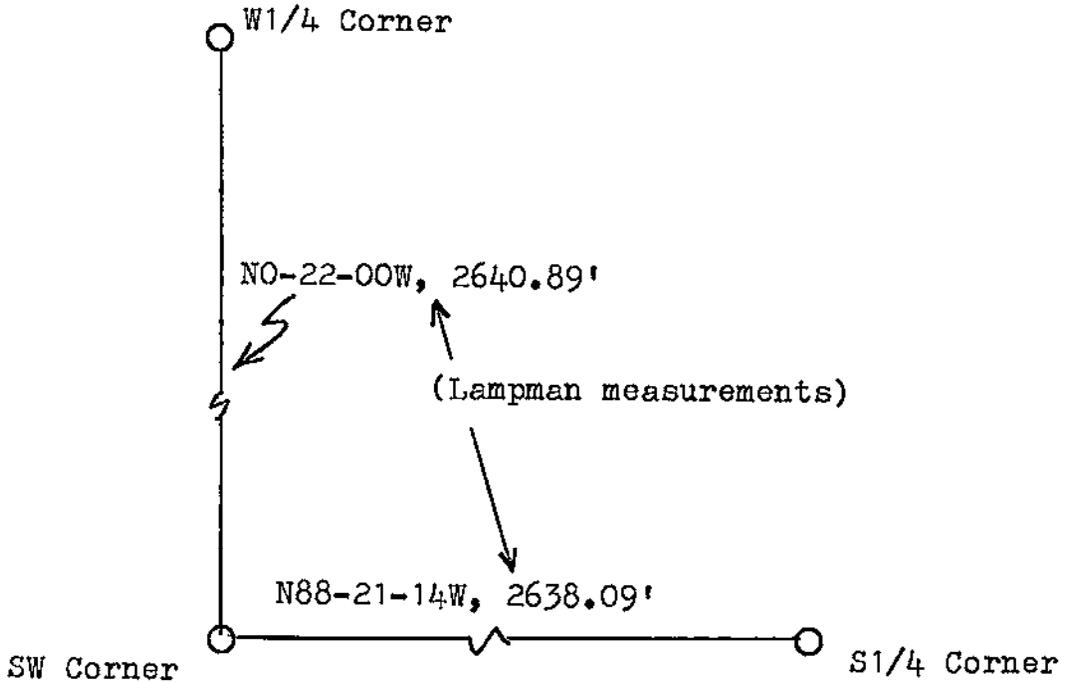

I, William C. Jung, Deputy County Surveyor
HEREBY CERTIFY THAT THE CORNER LOCATION SHOWN ON THIS RECORD
WAS DETERMINED BY ME OR UNDER MY DIRECTION AND CONTROL AND
THAT THIS U. S. PUBLIC LAND SURVEY MONUMENT RECORD IS CORRECT
AND COMPLETE TO THE BEST OF MY KNOWLEDGE AND BELIEF.

William C. Jung
Signature

January 3, 1989
Date

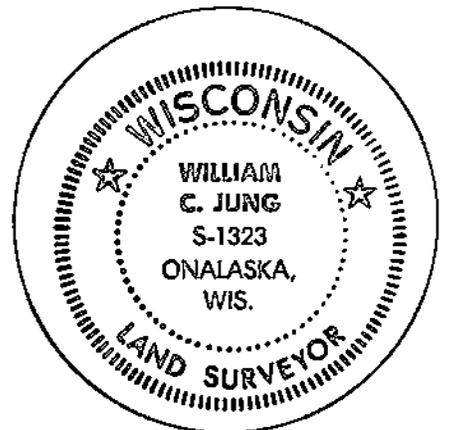

Seal