


21607200020

U. S. PUBLIC LAND SURVEY MONUMENT RECORD

SECTION 29 T 16 N, R 7 W, CITY LA CROSSE TOWN OF LA CROSSE  
 LA CROSSE COUNTY

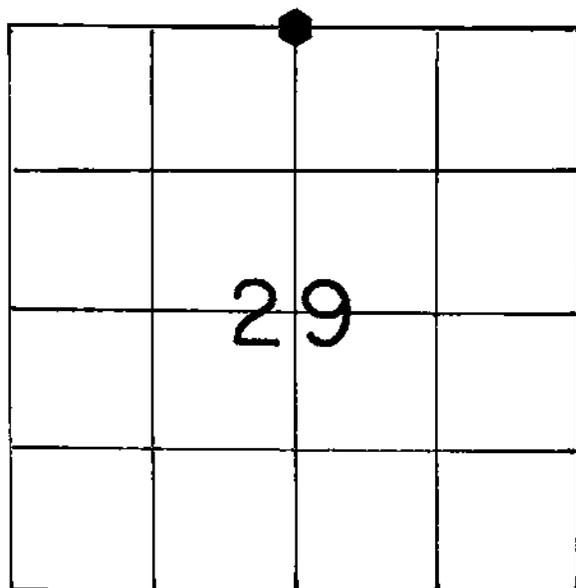

LOCATION OF LANDMARK

Crew: WILLIAM C. JUNG  
 PETER F. FOLLANSBEE

Date: 3/30/1992

Describe any record evidence, monument evidence, testimonial evidence or any other material evidence you considered and whether the monument was found or restored through acceptance of an obliterated evidence location.

A Berntsen set in concrete, down 1", was found at the corner. It apparently was set by the D.O.T. This corner location had been used in previous surveys. I accepted this Berntsen as the best available evidence of the original government corner position.


Describe or show any material discrepancy between the location of the restored corner and that of the corner previously restored or reestablished.

None Known.

WISCONSIN COORDINATE SYSTEM
North
East
Theta Angle
Horiz. Order
Vert. Order
TYPE OF LANDMARK
Existing Berntsen Top in concrete.
BEARINGS ARE REFERENCED TO

RECORD OF DURABLE WITNESS MONUMENTS

NO	DESCRIPTION	BEARING	DISTANCE
1	Set 8" Timber Nail at back of curb	West $\pm$	15.62 Ft.
2	Set 8" T. Nail back of curb on median	Northeasterly $\pm$	11.12 Ft.
3	Set 8" T. Nail back of curb on median	East $\pm$	9.50 Ft.
4	Set 8" T. Nail back of curb on median	Southeasterly $\pm$	11.31 Ft.

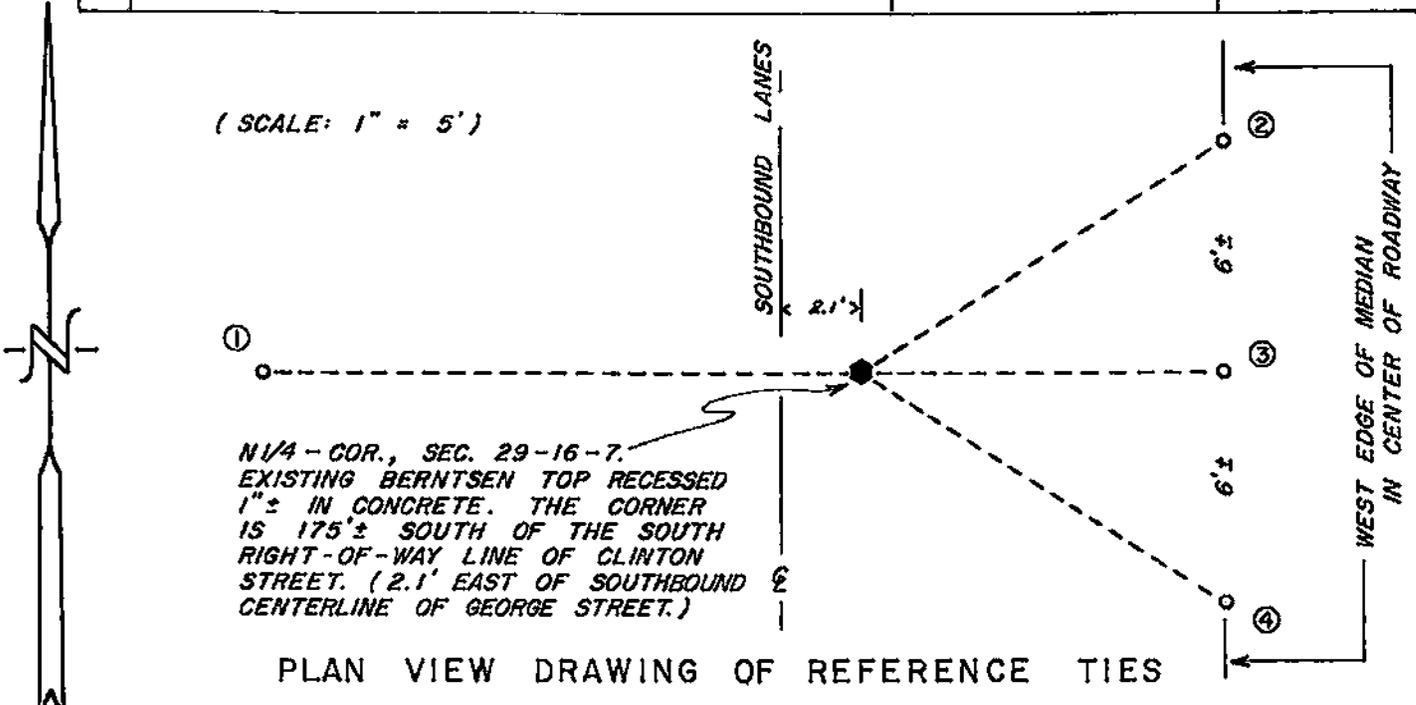


MAP SHOWING DISTANCE AND DIRECTION TO OTHER PUBLIC LAND SURVEY CORNERS USED FOR REESTABLISHING THE CORNER

NO SECTION MEASUREMENTS MADE BY ME AT THIS TIME. LOCATION CONFIRMED BY D.O.T.

I, William C. Jung, Deputy County Surveyor  
 HEREBY CERTIFY THAT THE CORNER LOCATION SHOWN ON THIS RECORD  
 WAS DETERMINED BY ME OR UNDER MY DIRECTION AND CONTROL AND  
 THAT THIS U. S. PUBLIC LAND SURVEY MONUMENT RECORD IS CORRECT  
 AND COMPLETE TO THE BEST OF MY KNOWLEDGE AND BELIEF.


William C. Jung December 31, 1992  
 Signature Date

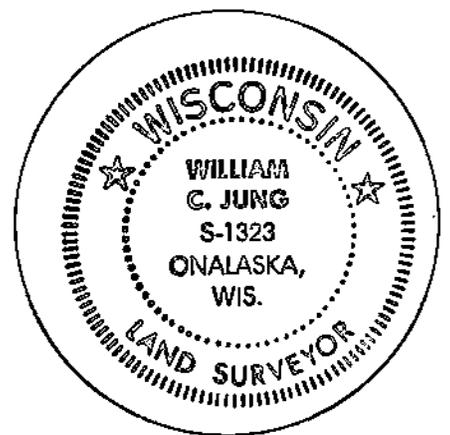

Seal

# Tie Sheet, City of La Crosse

Section 29 Township 16 N Range 7 W

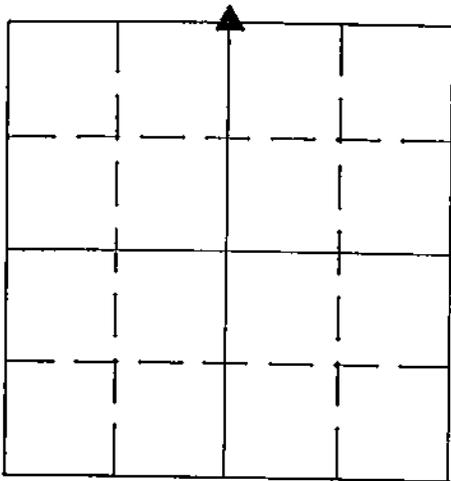


Project Section Corner  
 Sta No \_\_\_\_\_  
 Monument \_\_\_\_\_  
 Coord. System \_\_\_\_\_  
 North \_\_\_\_\_  
 East \_\_\_\_\_  
 Elev \_\_\_\_\_  
 Surveyor County

Comments:

Date \_\_\_\_\_

Space for copy of field notes or ties to above described monument:

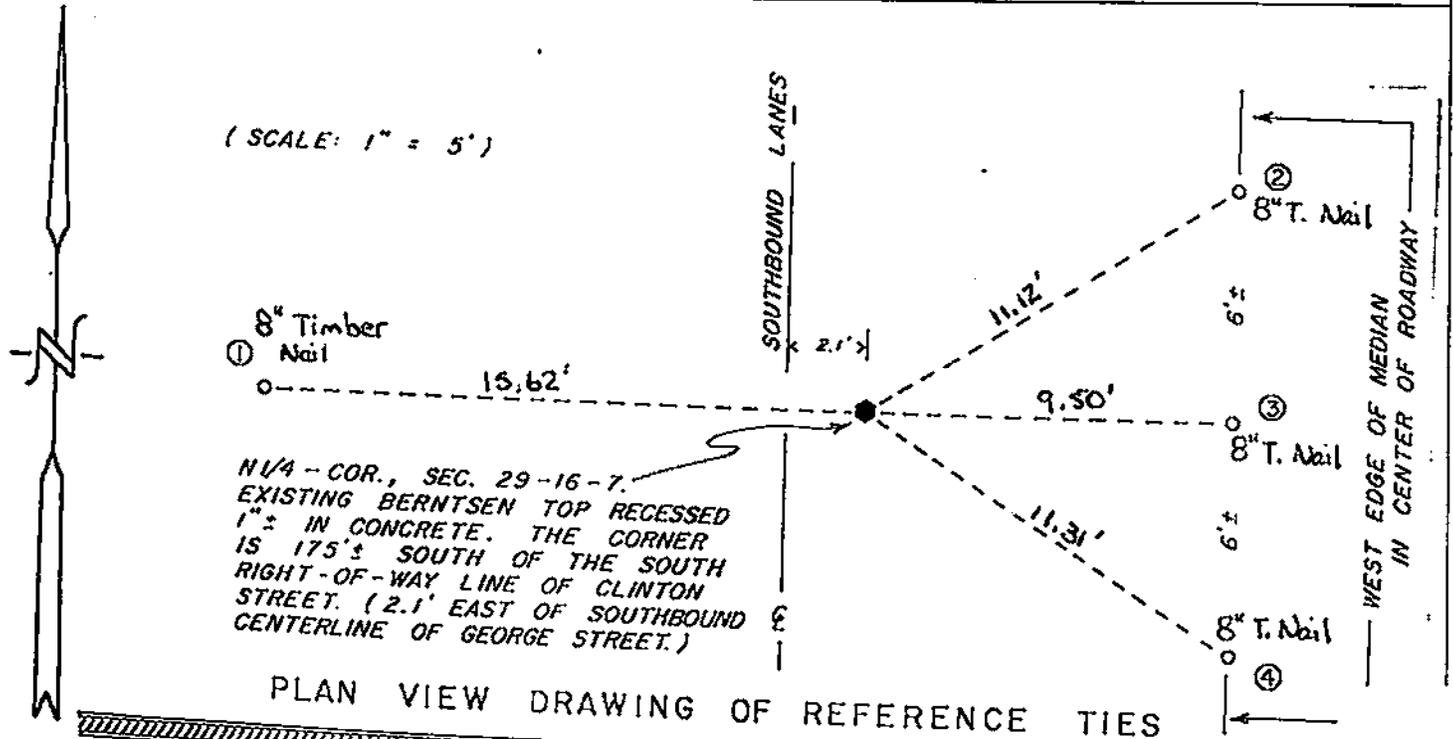

MAP SHOWING DISTANCE AND DIRECTION TO OTHER PUBLIC SURVEY CORNERS USED FOR REESTABLISHING THE CORNER