


21607202000

U. S. PUBLIC LAND SURVEY MONUMENT RECORD

SECTION 21 T 16 N, R 7 W, CITY OF LACROSSE

LA CROSSE COUNTY

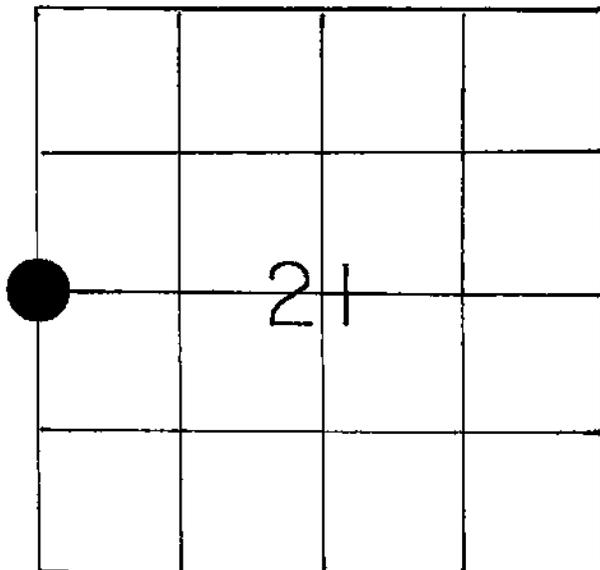

LOCATION OF LANDMARK

CREW: WILLIAM C. JUNG
PETER F. FOLLANSBEE

09-17-1987

Describe any record evidence, monument evidence, testimonial evidence or any other material evidence you considered and whether the monument was found or restored through acceptance of an obliterated evidence location.

I found a 1" (O.D.) iron pipe set over a stone. The stone was down 30". I removed the pipe and replaced it with a brass capped Lunde marker. The stone is still in. The marker is in the sideslope for the new parking lot. The pipe was used as the corner in previous surveys.

Caution: In the future there may be a new North-South communication line buried near the corner. The new line will go to the new building to the South.

Describe or show any material discrepancy between the location of the restored corner and that of the corner previously restored or reestablished.

A 1926 map shows a "rail set vertical" at this corner.

WISCONSIN COORDINATE SYSTEM

North

East

Theta Angle

Horiz. Order

Vert. Order


TYPE OF LANDMARK

SET BRASS CAP LUNDE MARKER OVER EX. STONE

BEARINGS ARE REFERENCED TO
HIGHWAY AS PER PROJECTS NO. 5513 & 5530
(HIGHWAY NO. 16)

RECORD OF DURABLE WITNESS MONUMENTS


NO	DESCRIPTION	BEARING	DISTANCE
1	EXTERIOR R.R. SPIKE FOR E. RAIL, 5th RAIL TO N.	WEST <u>+</u>	5.52 FT.
2	TOP NUT ON FIRE HYDRANT EAST OF OAK STREET	EAST <u>+</u>	129.04 FT.
3	NE-CORNER OF CONCRETE, AT BASE OF NEW R.R. BLD.	SOUTHEAST <u>+</u>	51.22 FT.
4	EX. P.K. NAIL ON R.R. TIE, CENTERLINE TRACKS	SOUTHWEST <u>+</u>	10.43 FT.

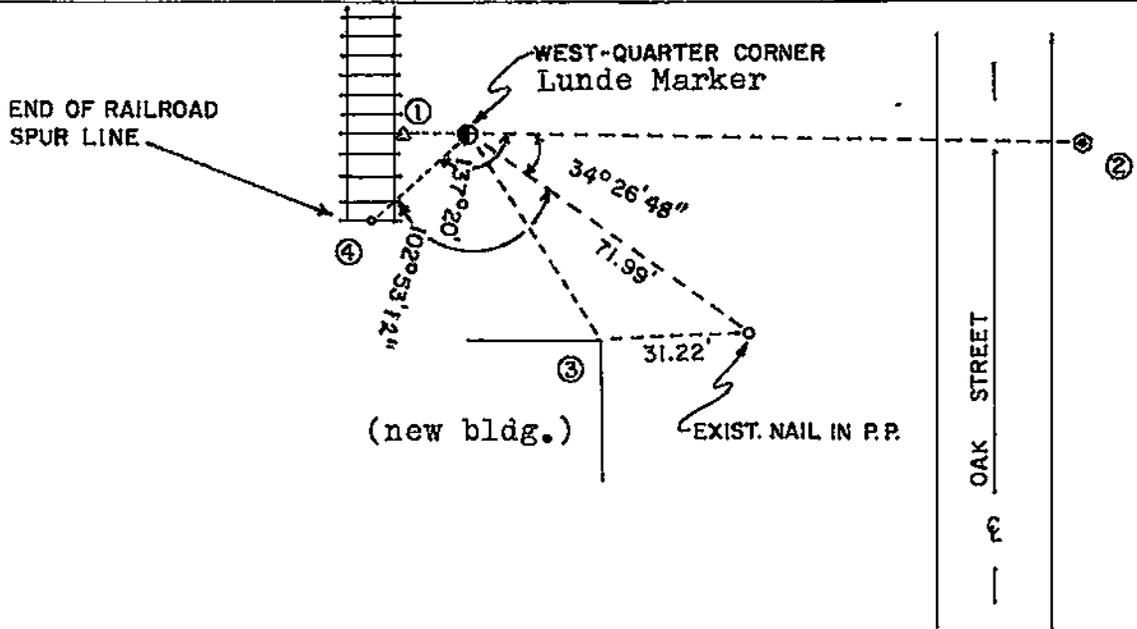

PLAN VIEW DRAWING OF REFERENCE TIES


MAP SHOWING DISTANCE AND DIRECTION TO OTHER PUBLIC LAND SURVEY CORNERS USED FOR REESTABLISHING THE CORNER

(not to scale)

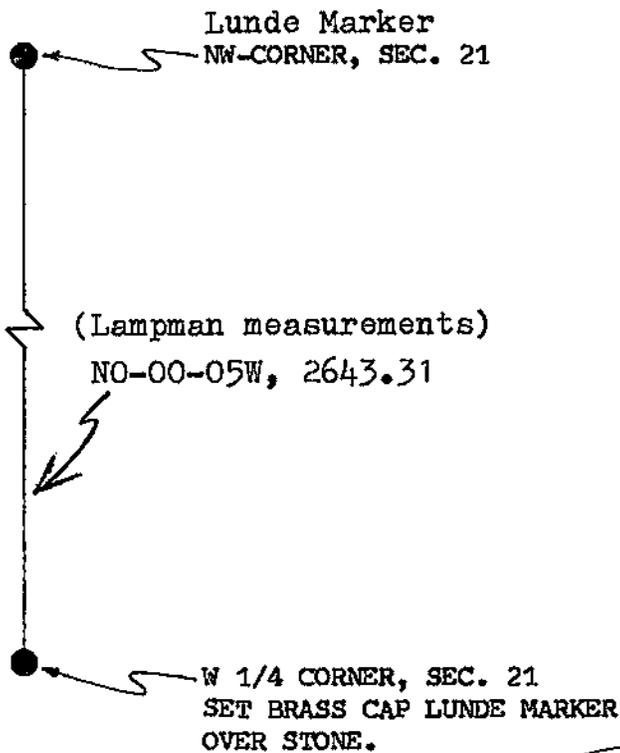

I, WILLIAM C. JUNG
 HEREBY CERTIFY THAT THE CORNER LOCATION SHOWN ON THIS RECORD
 WAS DETERMINED BY ME OR UNDER MY DIRECTION AND CONTROL AND
 THAT THIS U. S. PUBLIC LAND SURVEY MONUMENT RECORD IS CORRECT
 AND COMPLETE TO THE BEST OF MY KNOWLEDGE AND BELIEF.

William C. Jung Deputy County Surveyor, December 10, 1987
 Signature Date

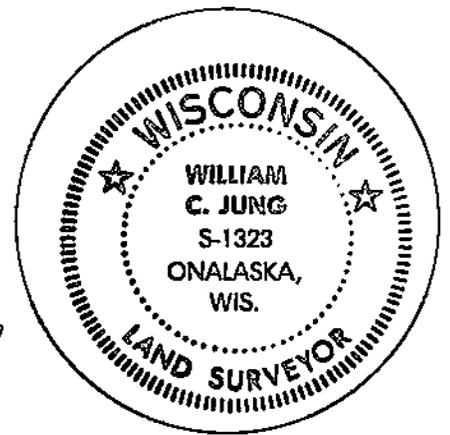

Seal