


U. S. PUBLIC LAND SURVEY MONUMENT RECORD

SECTION 21 T 16 N, R 7 W, TOWN OF Medary
 LA CROSSE COUNTY

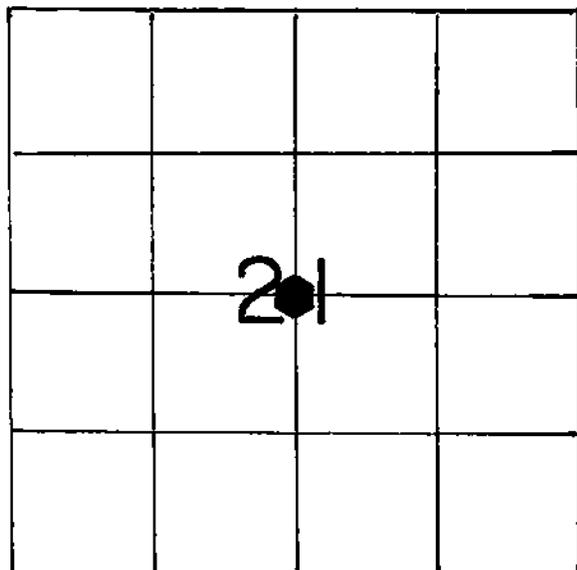

LOCATION OF LANDMARK

Crew: WILLIAM C. JUNG
 PETER F. FOLLANSBEE

Date: 3/19/1991

Describe any record evidence, monument evidence, testimonial evidence or any other material evidence you considered and whether the monument was found or restored through acceptance of an obliterated evidence location.

The Berntsen monument and all of the old ties were destroyed during highway construction. Phil Smith, R.L.S. and D.O.T. project engineer, set a new Berntsen top after construction. We tied off the new monument. The first Berntsen was set by Rob Lampman in 1982.

Describe or show any material discrepancy between the location of the restored corner and that of the corner previously restored or reestablished.


None known

(1927 coordinates)

WISCONSIN COORDINATE SYSTEM	
North	675893.97 as per D.O.T. plans
East	1678253.11
Theta Angle	
Horiz. Order	
Vert. Order	
TYPE OF LANDMARK	
Exist. Berntsen top in concrete	
BEARINGS ARE REFERENCED TO	

RECORD OF DURABLE WITNESS MONUMENTS

NO	DESCRIPTION	BEARING	DISTANCE
1	Existing P.K. Nail in pavement	N.W. +	427.18 Ft.
2	East edge of bridge concrete	West +	63.57 Ft.
3	Center of steel fence post @ bridge end	S.W. +	58.30 Ft.
4	Center of fuel pipe screw cap	S.E. +	169.80 Ft.

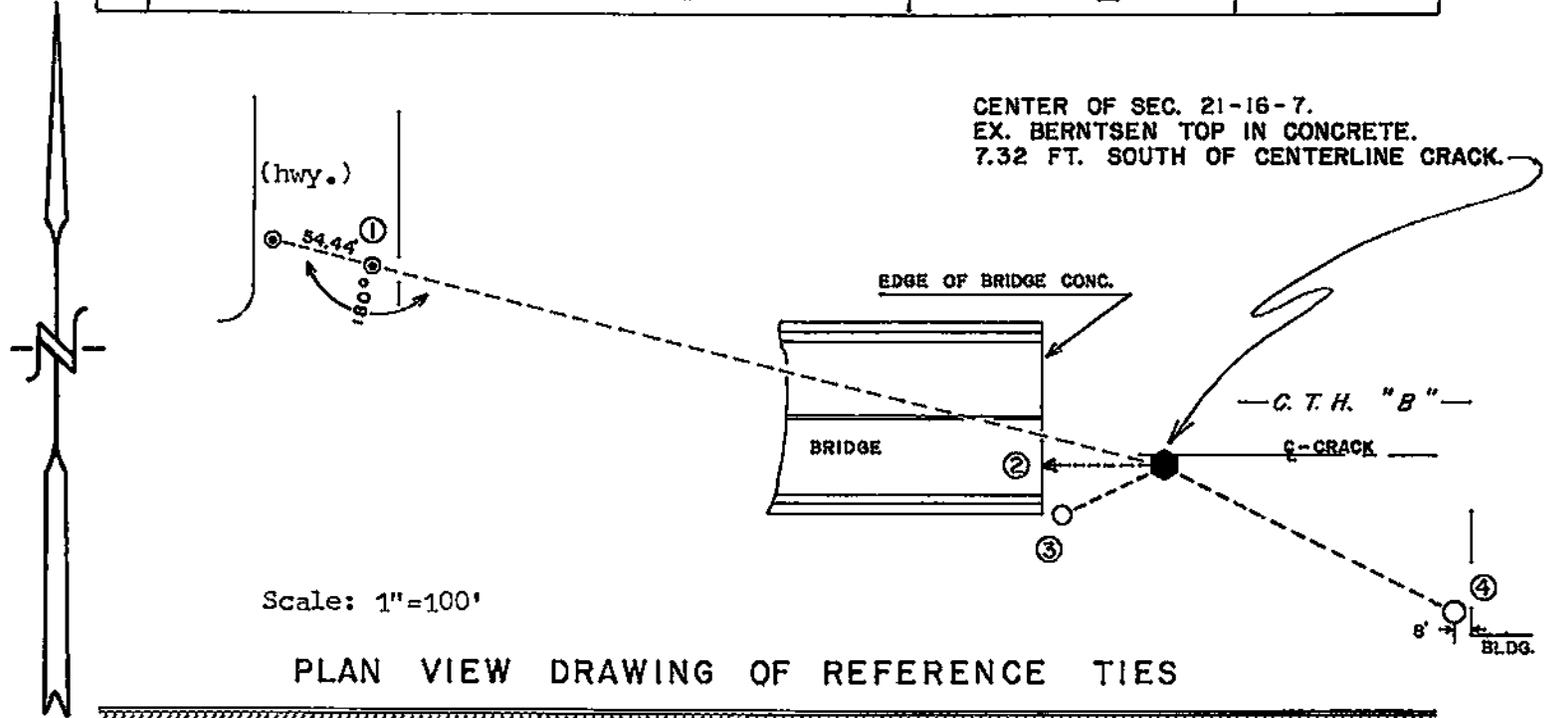

Scale: 1"=100'

PLAN VIEW DRAWING OF REFERENCE TIES

MAP SHOWING DISTANCE AND DIRECTION TO OTHER PUBLIC LAND SURVEY CORNERS USED FOR REESTABLISHING THE CORNER

No section measurements made by me at this time. Refer to Lampman's 1982 section data and highway plans of record.

I, William C. Jung, Deputy County Surveyor
 HEREBY CERTIFY THAT THE CORNER LOCATION SHOWN ON THIS RECORD
 WAS DETERMINED BY ME OR UNDER MY DIRECTION AND CONTROL AND
 THAT THIS U. S. PUBLIC LAND SURVEY MONUMENT RECORD IS CORRECT
 AND COMPLETE TO THE BEST OF MY KNOWLEDGE AND BELIEF.

William C. Jung
 Signature

December 3, 1991

Date




Seal

U. S. PUBLIC LAND SURVEY MONUMENT RECORD

SECTION 21 T 16 N, R 7 W, TOWN OF MEDARY

LA CROSSE COUNTY

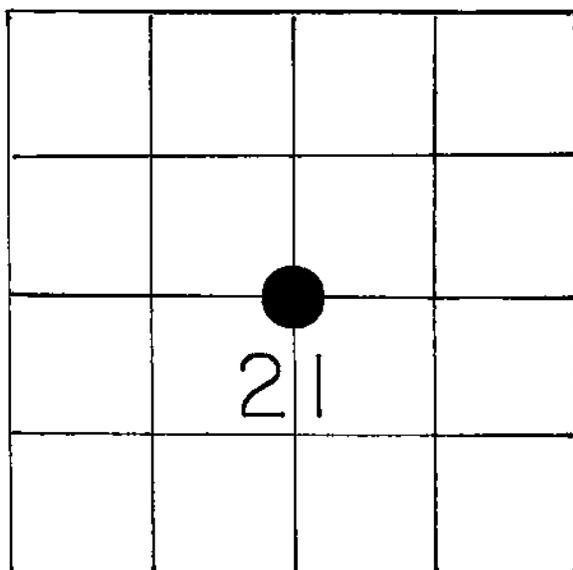

LOCATION OF LANDMARK

CREW: WILLIAM C. JUNG
 PETER F. FOLLANSBEE
 10-29-1987

WISCONSIN COORDINATE SYSTEM

North

East

Theta Angle

Horiz. Order

Vert. Order

TYPE OF LANDMARK

FOUND NAIL OVER BERNTSEN MONUMENT

BEARINGS ARE REFERENCED TO
 HIGHWAY NO. 16 AS PER PROJECTS
 NO. 5513 & 5530

Describe any record evidence, monument evidence, testimonial evidence or any other material evidence you considered and whether the monument was found or restored through acceptance of an obliterated evidence location.

SET

FD. BERNTSEN MONUMENT BY ROBERT M. LAMPMAN AFTER SECTION BREAKDOWN.
 CENTER SECTION SET ACCORDING TO 59.62 "LAW" IN 1982.

Describe or show any material discrepancy between the location of the restored corner and that of the corner previously restored or reestablished.


NONE KNOWN

VOID

Note: Lampman bearings and distances.

RECORD OF DURABLE WITNESS MONUMENTS

NO	DESCRIPTION	BEARING	DISTANCE
1	P.K. NAIL IN WOOD BRACE, EAST END OF BRIDGE	N 72° 38' 52" W	67.46 FT.
2	P.K. NAIL IN WOOD BRACE, EAST END OF BRIDGE	S 85° 14' 43" W	65.26 FT.
3	P.K. NAIL IN POWER POLE	S 53° 35' 28" W	62.53 FT.
4	P.K. NAIL IN POWER POLE	S 70° 49' 31" E	131.62 FT.

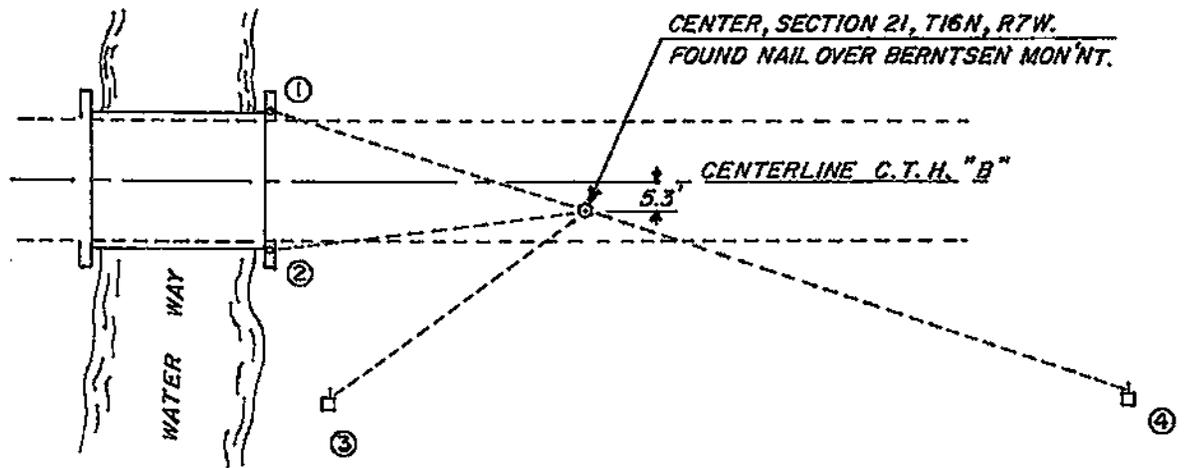


PLAN VIEW DRAWING OF REFERENCE TIES

MAP SHOWING DISTANCE AND DIRECTION TO OTHER PUBLIC LAND SURVEY CORNERS USED FOR REESTABLISHING THE CORNER

BEARINGS AND DISTANCES TAKEN FROM LAMPMAN PLAT OF SURVEY MAP NO. M-145

NOT TO SCALE

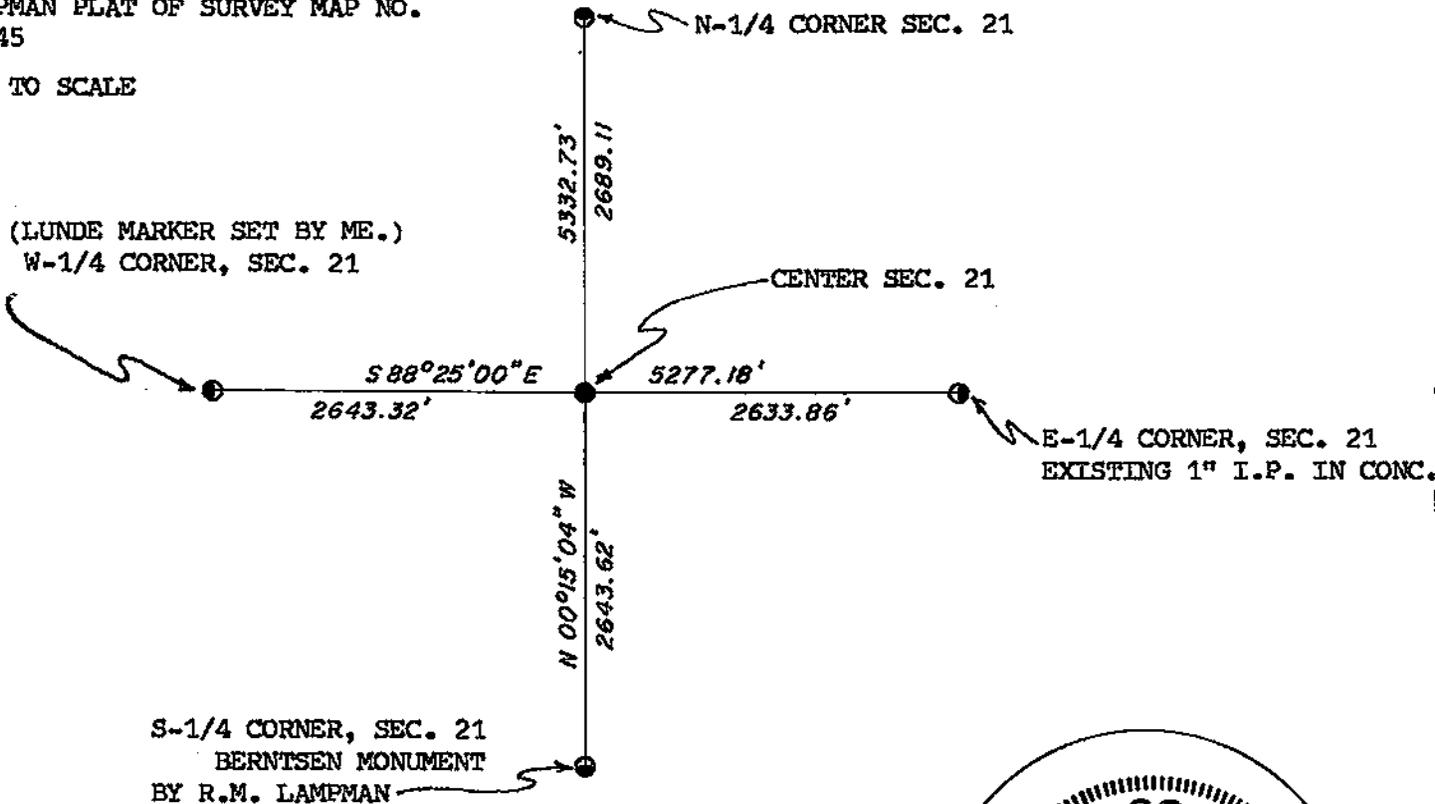

I, WILLIAM C. JUNG
 HEREBY CERTIFY THAT THE CORNER LOCATION SHOWN ON THIS RECORD WAS DETERMINED BY ME OR UNDER MY DIRECTION AND CONTROL AND THAT THIS U. S. PUBLIC LAND SURVEY MONUMENT RECORD IS CORRECT AND COMPLETE TO THE BEST OF MY KNOWLEDGE AND BELIEF.

William C. Jung Deputy County Surveyor, December 10, 1987
 Signature Date



Seal