


U. S. PUBLIC LAND SURVEY MONUMENT RECORD

SECTION 22 T 16 N, R 7 W, TOWN OF MEDARY

LA CROSSE COUNTY

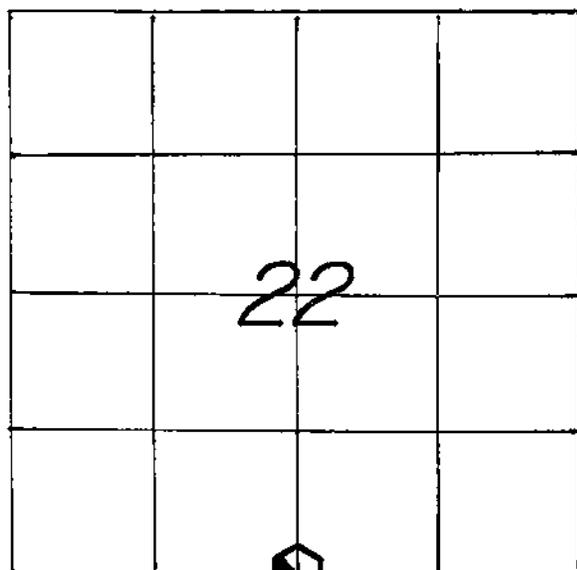

LOCATION OF LANDMARK

CREW: WILLIAM G. JUNG
 PETER F. FOLLANSBEE
 DATE: 8/25/2008

WISCONSIN COORDINATE SYSTEM

North 673,090.336

East 1,651,902.748

Theta Angle

Horiz. Order

Vert. Order

DATUM: 1983('91)

TYPE OF LANDMARK

BERNTSEN TOP IN 1/2" (I.D.) IRON PIPE.

BEARINGS ARE REFERENCED TO
 GRID NORTH AS PER SECTION DATA.

Describe any record evidence, monument evidence, testimonial evidence or any other material evidence you considered and whether the monument was found or restored through acceptance of an obliterated evidence location.

We found an iron pipe at the corner that had been used as the corner in several previous surveys. I accepted it as the best available evidence of the original government corner. A Berntsen top was put in the pipe.


Describe or show any material discrepancy between the location of the restored corner and that of the corner previously restored or reestablished.

NONE KNOWN.

RECORD OF DURABLE WITNESS MONUMENTS


MAGNETIC

NO	DESCRIPTION	BEARING	DISTANCE
1	SET A NAIL IN S.-SIDE OF A 9" COTTONWOOD	N 70° W	14.13 FT.
2	SET A 3/4" x 30" IRON BAR WITH A RED PLASTIC CAP	EAST ±	51.31 FT.
3	SET A NAIL IN S.W.-SIDE OF A 4-1/2" COTTONWOOD	S 05° E	23.46 FT.
4	SET A NAIL IN N.W.-SIDE OF A 7-1/2" COTTONWOOD	S 35° W	23.25 FT.

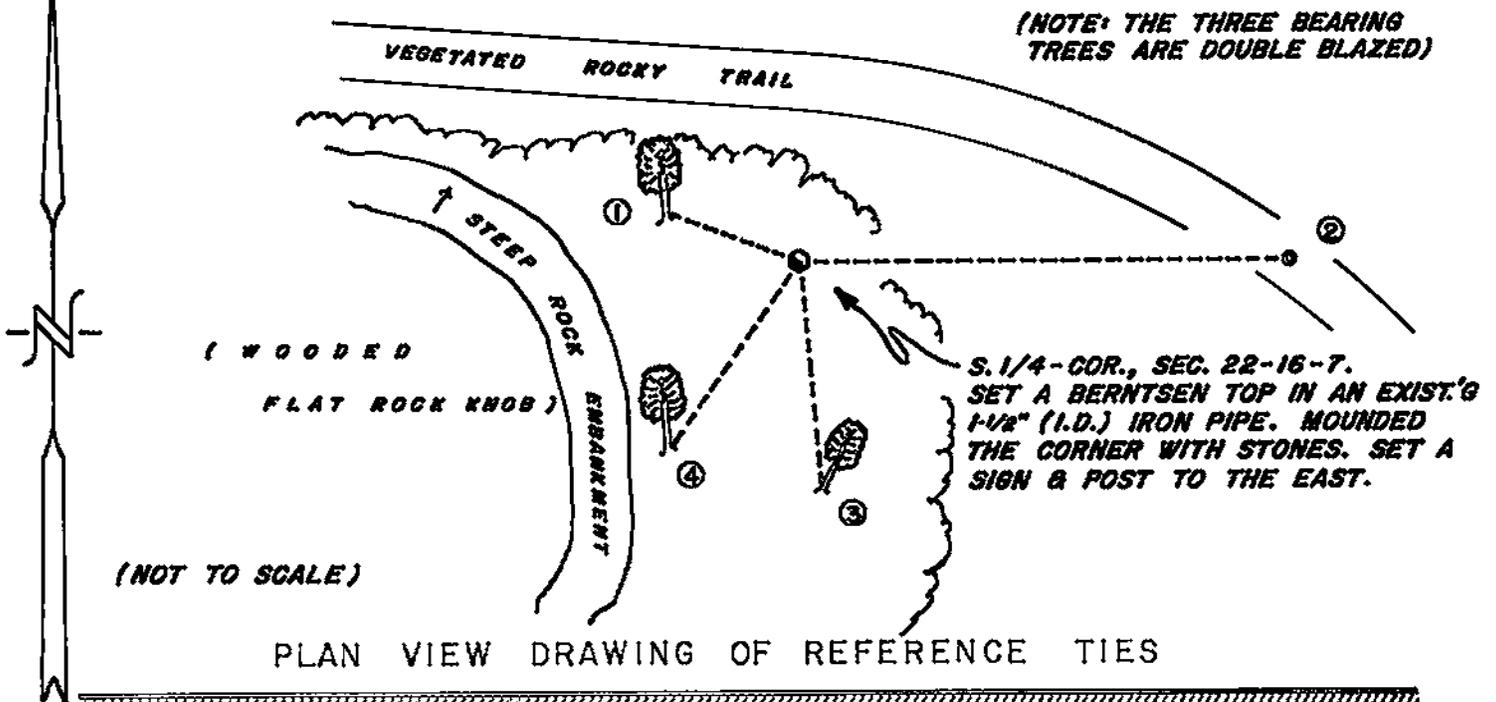

MAP SHOWING DISTANCE AND DIRECTION TO OTHER PUBLIC LAND SURVEY CORNERS USED FOR REESTABLISHING THE CORNER

(GRID BEARINGS AND DISTANCES)
(GRID FACTOR: 0.99994)
(NOT TO SCALE)

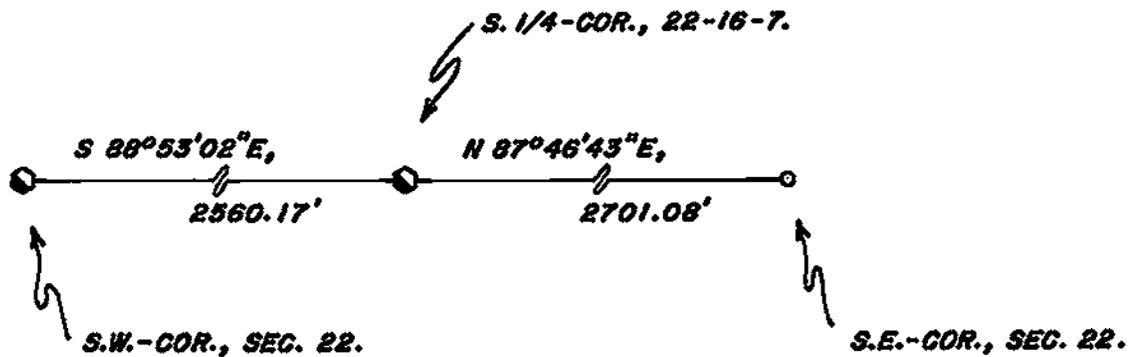

I, WILLIAM C. JUNG, COUNTY SURVEYOR
HEREBY CERTIFY THAT THE CORNER LOCATION SHOWN ON THIS RECORD WAS DETERMINED BY ME OR UNDER MY DIRECTION AND CONTROL AND THAT THIS U. S. PUBLIC LAND SURVEY MONUMENT RECORD IS CORRECT AND COMPLETE TO THE BEST OF MY KNOWLEDGE AND BELIEF.

William C. Jung
Signature

11/5/08
Date



Seal