


21607230000

## U. S. PUBLIC LAND SURVEY MONUMENT RECORD

SECTION 26 T 16 N, R 7 W, TOWN OF MEDARY

LA CROSSE COUNTY

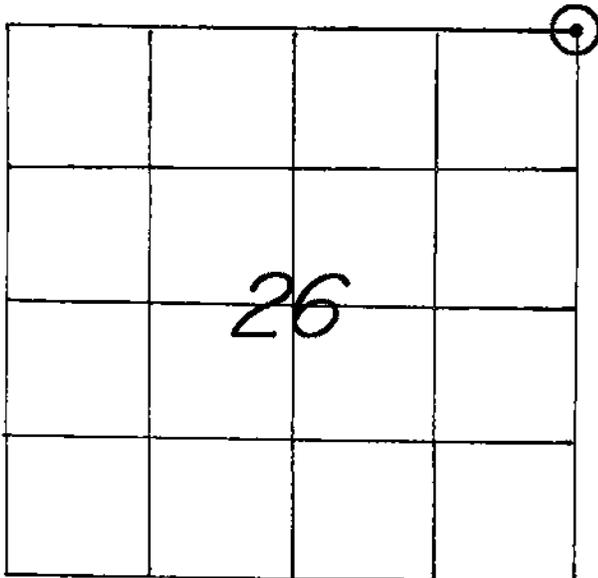

WISCONSIN COORDINATE SYSTEM

North

East

Theta Angle

Horiz. Order

Vert. Order

TYPE OF LANDMARK

*1-3/4" (O.D.) IRON PIPE WITH RED PLASTIC PLUG.*

BEARINGS ARE REFERENCED TO

LOCATION OF LANDMARK

CREW: *WILLIAM C. JUNG*  
*PETER F. FOLLANSBEE*  
 DATE: *3/03/2005*

Describe any record evidence, monument evidence, testimonial evidence or any other material evidence you considered and whether the monument was found or restored through acceptance of an obliterated evidence location.

Greg Hofmeister set an iron pipe at this corner in 1978. The iron pipe has been used as the corner in at least 25 surveys since Greg set the pipe. I accepted the pipe as the best available evidence of the original government corner position.

Describe or show any material discrepancy between the location of the restored corner and that of the corner previously restored or reestablished.

*NONE KNOWN.*

