


U. S. PUBLIC LAND SURVEY MONUMENT RECORD

SECTION 23 T 16 N, R 7 W, TOWN OF MEDARY
 LA CROSSE COUNTY

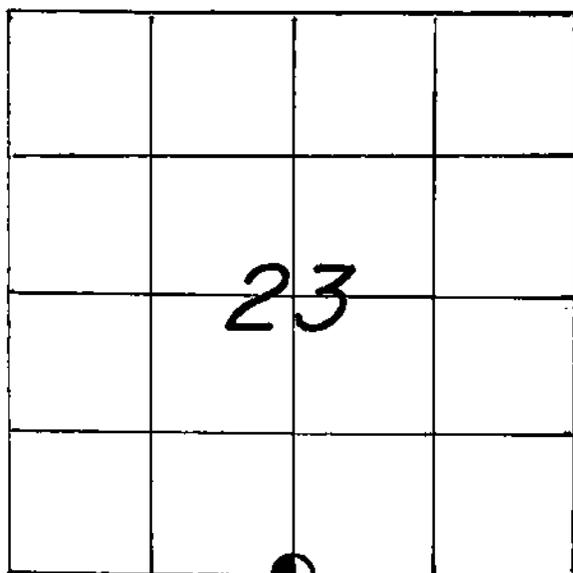

LOCATION OF LANDMARK

WISCONSIN COORDINATE SYSTEM
North
East
Theta Angle
Horiz. Order
Vert. Order
TYPE OF LANDMARK
Brass cap Lunde marker.
BEARINGS ARE REFERENCED TO

Crew: WILLIAM C. JUNG
 PETER F. FOLLANSBEE
 Date: 5/17/1996

Describe any record evidence, monument evidence, testimonial evidence or any other material evidence you considered and whether the monument was found or restored through acceptance of an obliterated evidence location.

I found an iron pipe at the occupied corner that had been used in many previous surveys as the corner. I accepted this pipe as the best available evidence of the original government corner position, removed it, and replaced it with a brass capped Lunde marker.

Describe or show any material discrepancy between the location of the restored corner and that of the corner previously restored or reestablished.

None Known.

RECORD OF DURABLE WITNESS MONUMENTS
MAGNETIC

NO	DESCRIPTION	BEARING	DISTANCE
1	Existing 1½" Iron Pipe	N 86°W	27.82 Ft.
2	Set P.K. Nail in SE-side 3½" Hickory	N 05°W	13.72 Ft.
3	Set P.K. Nail in S.-side 14" Hickory	S 88°E	19.47 Ft.
4	Set P.K. Nail in NE-side 13" Oak	S 45°E	13.77 Ft.

S.¼-Cor., Sec. 23-16-7.

Set brass cap Lunde marker to replace an existing 1" iron pipe at the fence intersection. Set the marker flush & buried a Wine bottle containing a shell casing on the SW-side. Set stones around the corner and a sign & post to the N.E.

(Scale: 1" = 10')

(W O O D S)

(Note: the three Bearing Trees are double blazed.)

(W O O D S)

PLAN VIEW DRAWING OF REFERENCE TIES

MAP SHOWING DISTANCE AND DIRECTION TO OTHER PUBLIC LAND SURVEY CORNERS USED FOR REESTABLISHING THE CORNER

No section measurements were made by me at this time. This position was confirmed by others with previous section measurements.

I, William C. Jung, County Surveyor
HEREBY CERTIFY THAT THE CORNER LOCATION SHOWN ON THIS RECORD WAS DETERMINED BY ME OR UNDER MY DIRECTION AND CONTROL AND THAT THIS U. S. PUBLIC LAND SURVEY MONUMENT RECORD IS CORRECT AND COMPLETE TO THE BEST OF MY KNOWLEDGE AND BELIEF.

William C. Jung
Signature

10/30/96
Date



Seal