


## U. S. PUBLIC LAND SURVEY MONUMENT RECORD

SECTION 24 T 16 N, R 7 W, TOWN OF MEDARY  
 LA CROSSE COUNTY

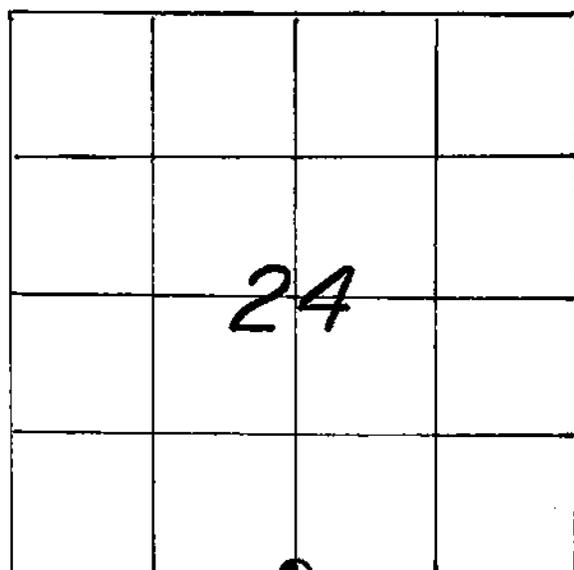

LOCATION OF LANDMARK

WISCONSIN COORDINATE SYSTEM
North
East
Theta Angle
Horiz. Order
Vert. Order
TYPE OF LANDMARK
Existing 2½" IRON PIPE (O.D.)
BEARINGS ARE REFERENCED TO

Crew: WILLIAM C. JUNG  
 PETER F. FOLLANSBEE  
 Date: 1/03/1996

Describe any record evidence, monument evidence, testimonial evidence or any other material evidence you considered and whether the monument was found or restored through acceptance of an obliterated evidence location.

I found a pipe at the corner which had been used in previous survey work as the corner. I accepted this pipe as the best available evidence of the original government corner position.


Describe or show any material discrepancy between the location of the restored corner and that of the corner previously restored or reestablished.

None Known.

RECORD OF DURABLE WITNESS MONUMENTS

MAGNETIC

NO	DESCRIPTION	BEARING	DISTANCE
1	Set P.K. Nail in SW-side 9½" White Oak	N 43° W	20.24 Ft.
2	Set P.K. Nail in SE-side 14" Aspen	S 79° W	15.29 Ft.
3	Set P.K. Nail in SE-side 12½" Aspen	S 39° W	18.62 Ft.
4	Set P.K. Nail in E.-side 13½" Aspen	South ±	37.11 Ft.

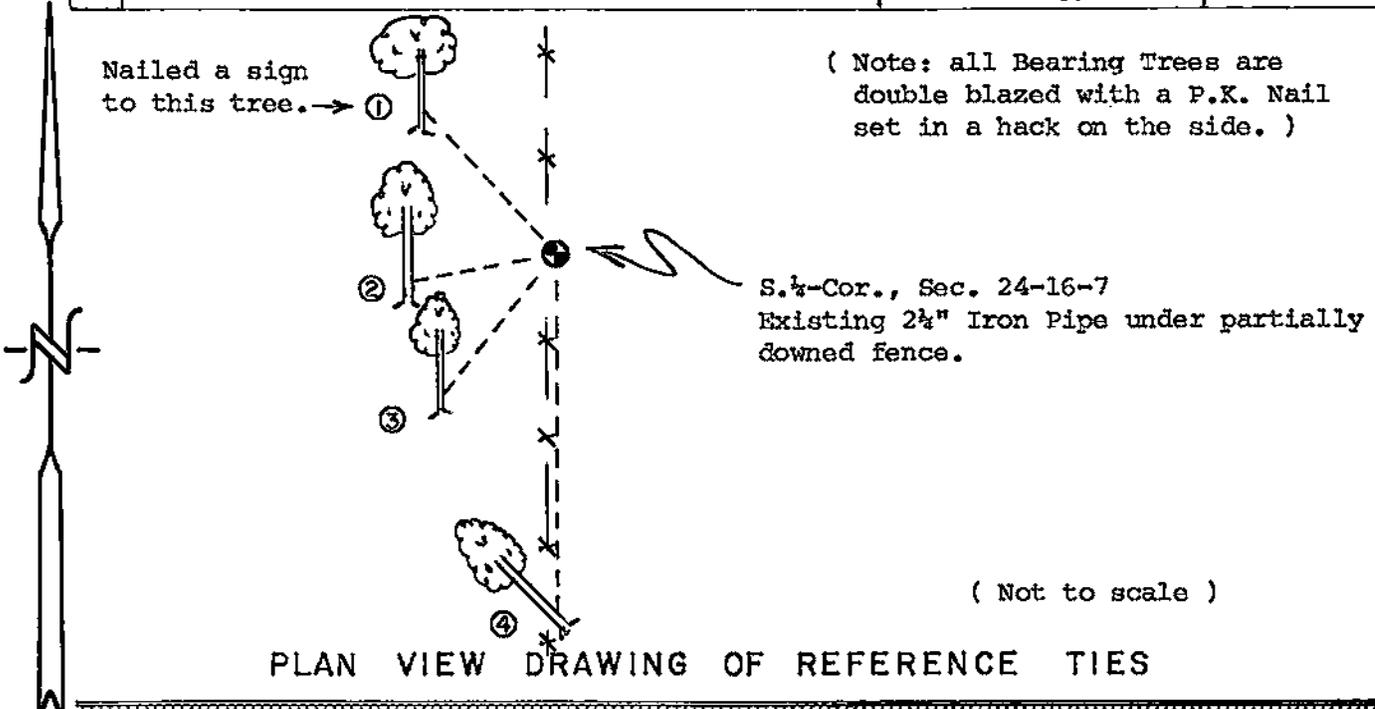

MAP SHOWING DISTANCE AND DIRECTION TO OTHER PUBLIC LAND SURVEY CORNERS USED FOR REESTABLISHING THE CORNER

No section measurements were made by me at this time.

I, William C. Jung, County Surveyor  
 HEREBY CERTIFY THAT THE CORNER LOCATION SHOWN ON THIS RECORD  
 WAS DETERMINED BY ME OR UNDER MY DIRECTION AND CONTROL AND  
 THAT THIS U. S. PUBLIC LAND SURVEY MONUMENT RECORD IS CORRECT  
 AND COMPLETE TO THE BEST OF MY KNOWLEDGE AND BELIEF.

William C. Jung 1/6/96  
 Signature Date



Seal