


21607242000

U. S. PUBLIC LAND SURVEY MONUMENT RECORD

SECTION 24 T 16 N, R 7 W, TOWN OF MEDARY
 LA CROSSE COUNTY

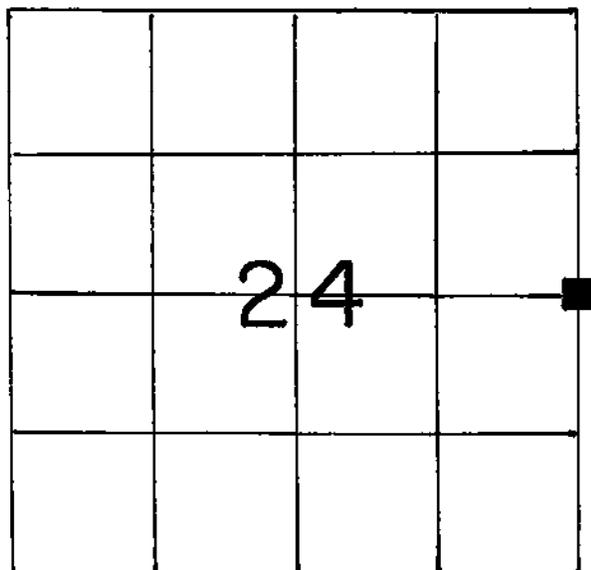

LOCATION OF LANDMARK

Crew: William C. Jung
 Peter F. Follansbee

Date: October 10, 1990

Describe any record evidence, monument evidence, testimonial evidence or any other material evidence you considered and whether the monument was found or restored through acceptance of an obliterated evidence location.

I found a stone that had been used in several previous surveys. The stone was scribed with " 1/4S" and measured 6" square. I plumbed the stone up and buried a liquor bottle with an empty blank bullet on the Southwest side of the stone. Tied barbed wire around the stone and set a survey witness on the bearing tree to the Southwest.

SIGN

Describe or show any material discrepancy between the location of the restored corner and that of the corner previously restored or reestablished.

None known.

WISCONSIN COORDINATE SYSTEM

North

East

Theta Angle

Horiz. Order

Vert. Order

TYPE OF LANDMARK

6" square stone

BEARINGS ARE REFERENCED TO

