


U. S. PUBLIC LAND SURVEY MONUMENT RECORD

SECTION 24 T 16 N, R 7 W, TOWN OF MEDARY
 LA CROSSE COUNTY

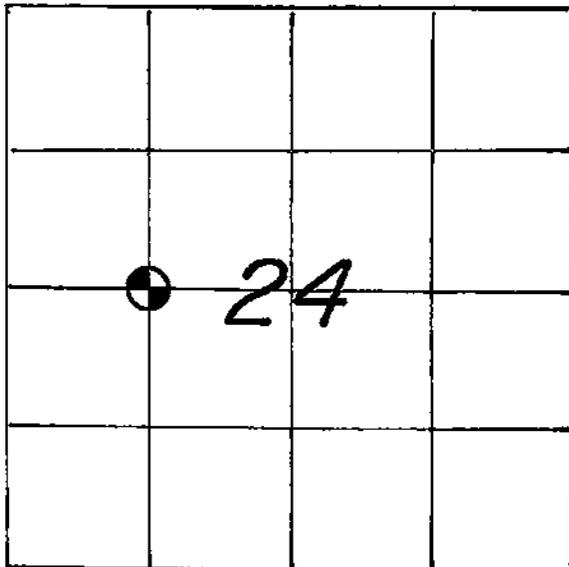

LOCATION OF LANDMARK

Crew: WILLIAM C. JUNG
 PETER F. FOLLANSBEE
 Date: 12/07/1995

Describe any record evidence, monument evidence, testimonial evidence or any other material evidence you considered and whether the monument was found or restored through acceptance of an obliterated evidence location.

We found an old stone at the "forty" corner that had been used in previous survey work. This stone is unrecorded but would probably have shown up in the old, lost County Surveyor records. It very well may have been set many years ago by a previous County Surveyor or his Deputy. The stone fits the section measurements very well. I have no problem accepting it as the corner.

Describe or show any material discrepancy between the location of the restored corner and that of the corner previously restored or reestablished.

None Known.

WISCONSIN COORDINATE SYSTEM

North

East

Theta Angle

Horiz. Order

Vert. Order


TYPE OF LANDMARK

Existing Fieldstone.

BEARINGS ARE REFERENCED TO

RECORD OF DURABLE WITNESS MONUMENTS

NO	DESCRIPTION	BEARING	DISTANCE
1	Existing 3/4" Iron Pipe	South \pm	45.92 Ft.
2	Set P.K. Nail in NW-side 9" Tree (unblazed)	N 35° E = Mag.	25.98 Ft.
3	Set P.K. Nail in N.-side 17" Aspen (unblazed)	East = Mag.	56.80 Ft.
4	Ex. 3/4" Iron Pipe east of east edge asphalt	Southeasterly \pm	(see sketch)

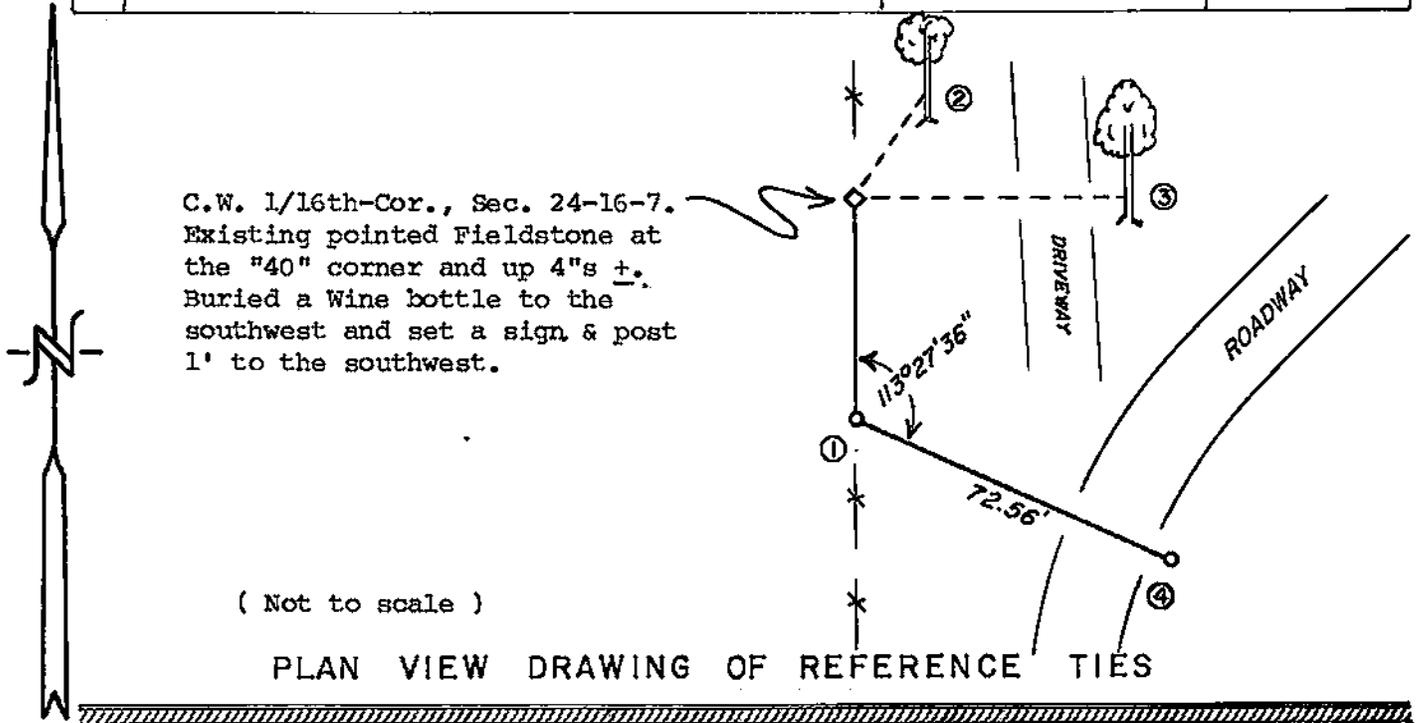

MAP SHOWING DISTANCE AND DIRECTION TO OTHER PUBLIC LAND SURVEY CORNERS USED FOR REESTABLISHING THE CORNER

No section measurements were made by me at this time. The position of this corner was confirmed in previous survey work.

I, William C. Jung, County Surveyor
HEREBY CERTIFY THAT THE CORNER LOCATION SHOWN ON THIS RECORD WAS DETERMINED BY ME OR UNDER MY DIRECTION AND CONTROL AND THAT THIS U. S. PUBLIC LAND SURVEY MONUMENT RECORD IS CORRECT AND COMPLETE TO THE BEST OF MY KNOWLEDGE AND BELIEF.

William C. Jung 12/21/95
Signature Date



Seal